

Dr. 9-9-92

SS. No 218.


SS. "Brancher"

ARRANGEMENT OF BILGE & SOUNDING PIPES ETC. - Brw Rept No 529





Brw 7/9/92

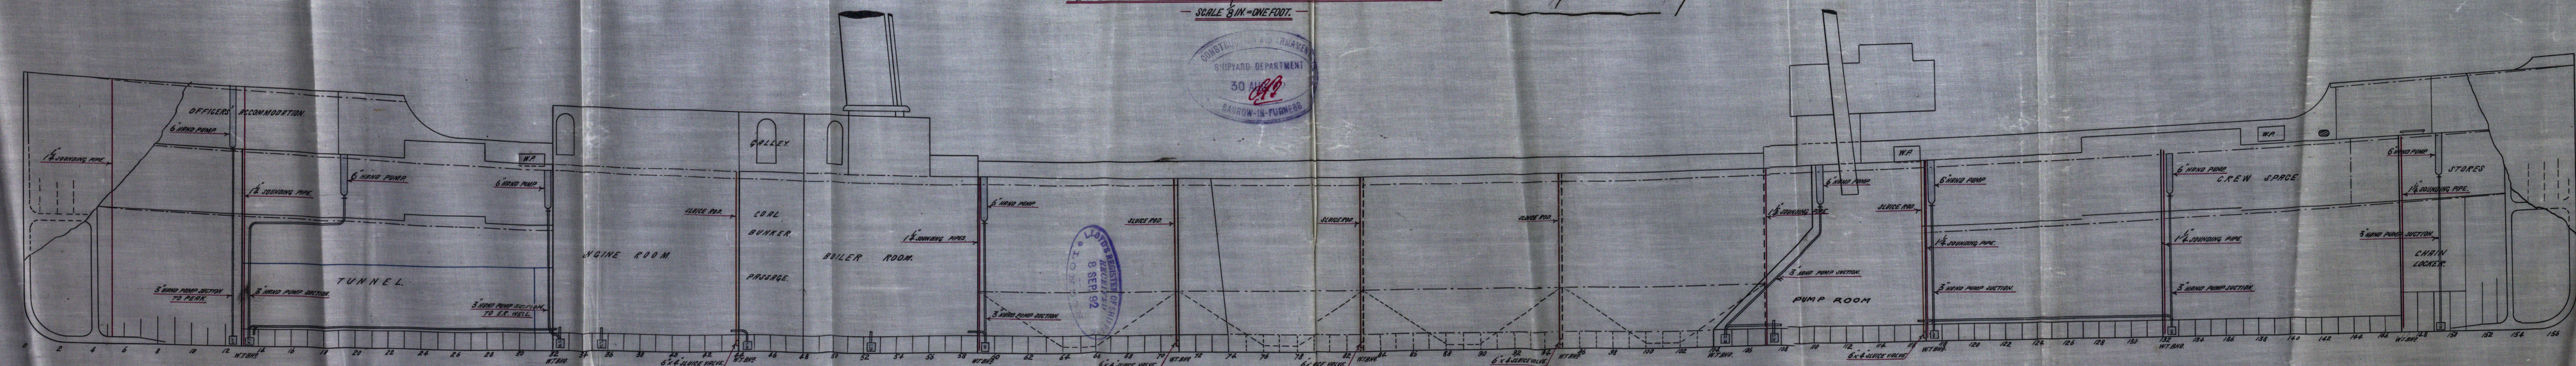

BILGE PIPES COLOURED THIN
SOUNDING PIPES
SLURGE VALVES

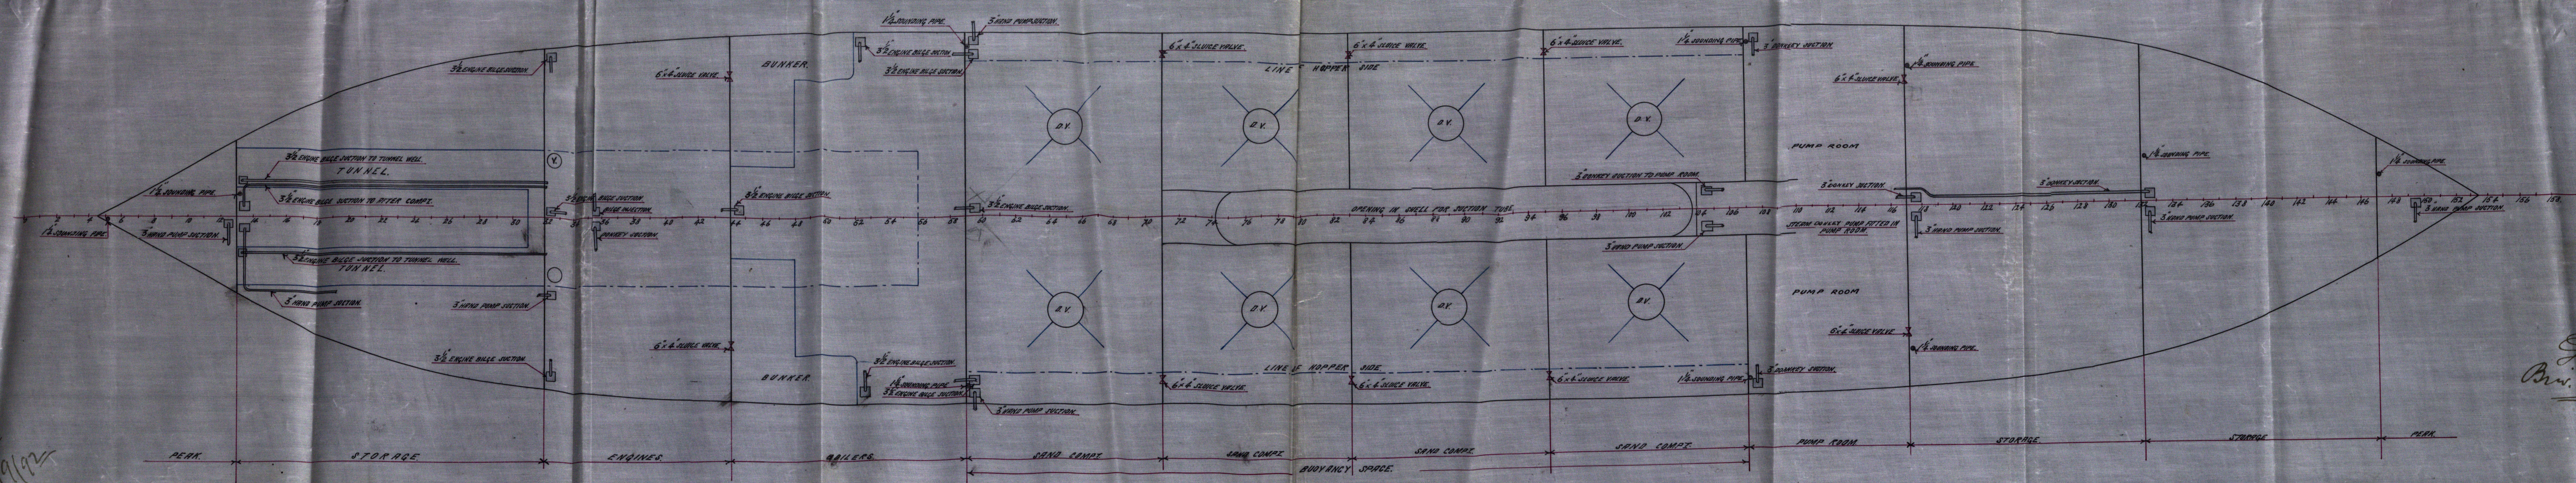

J.M. 8/9/92

Brw 7/9/92

BRW 42-099