

Ln. 25792



# SAND PUMP DREDGER No 218

V. J. Branker  
Brw Rept No 529


Brw  
23/7/92  
11/2

## STERN FRAME.


2 OFF.  
CAST STEEL  
SCALE 3/4 IN. = ONE FOOT  
ALSO ONE STEEL COUPLING FOR ONE RUDDER  
TO LLOYD'S TESTS.

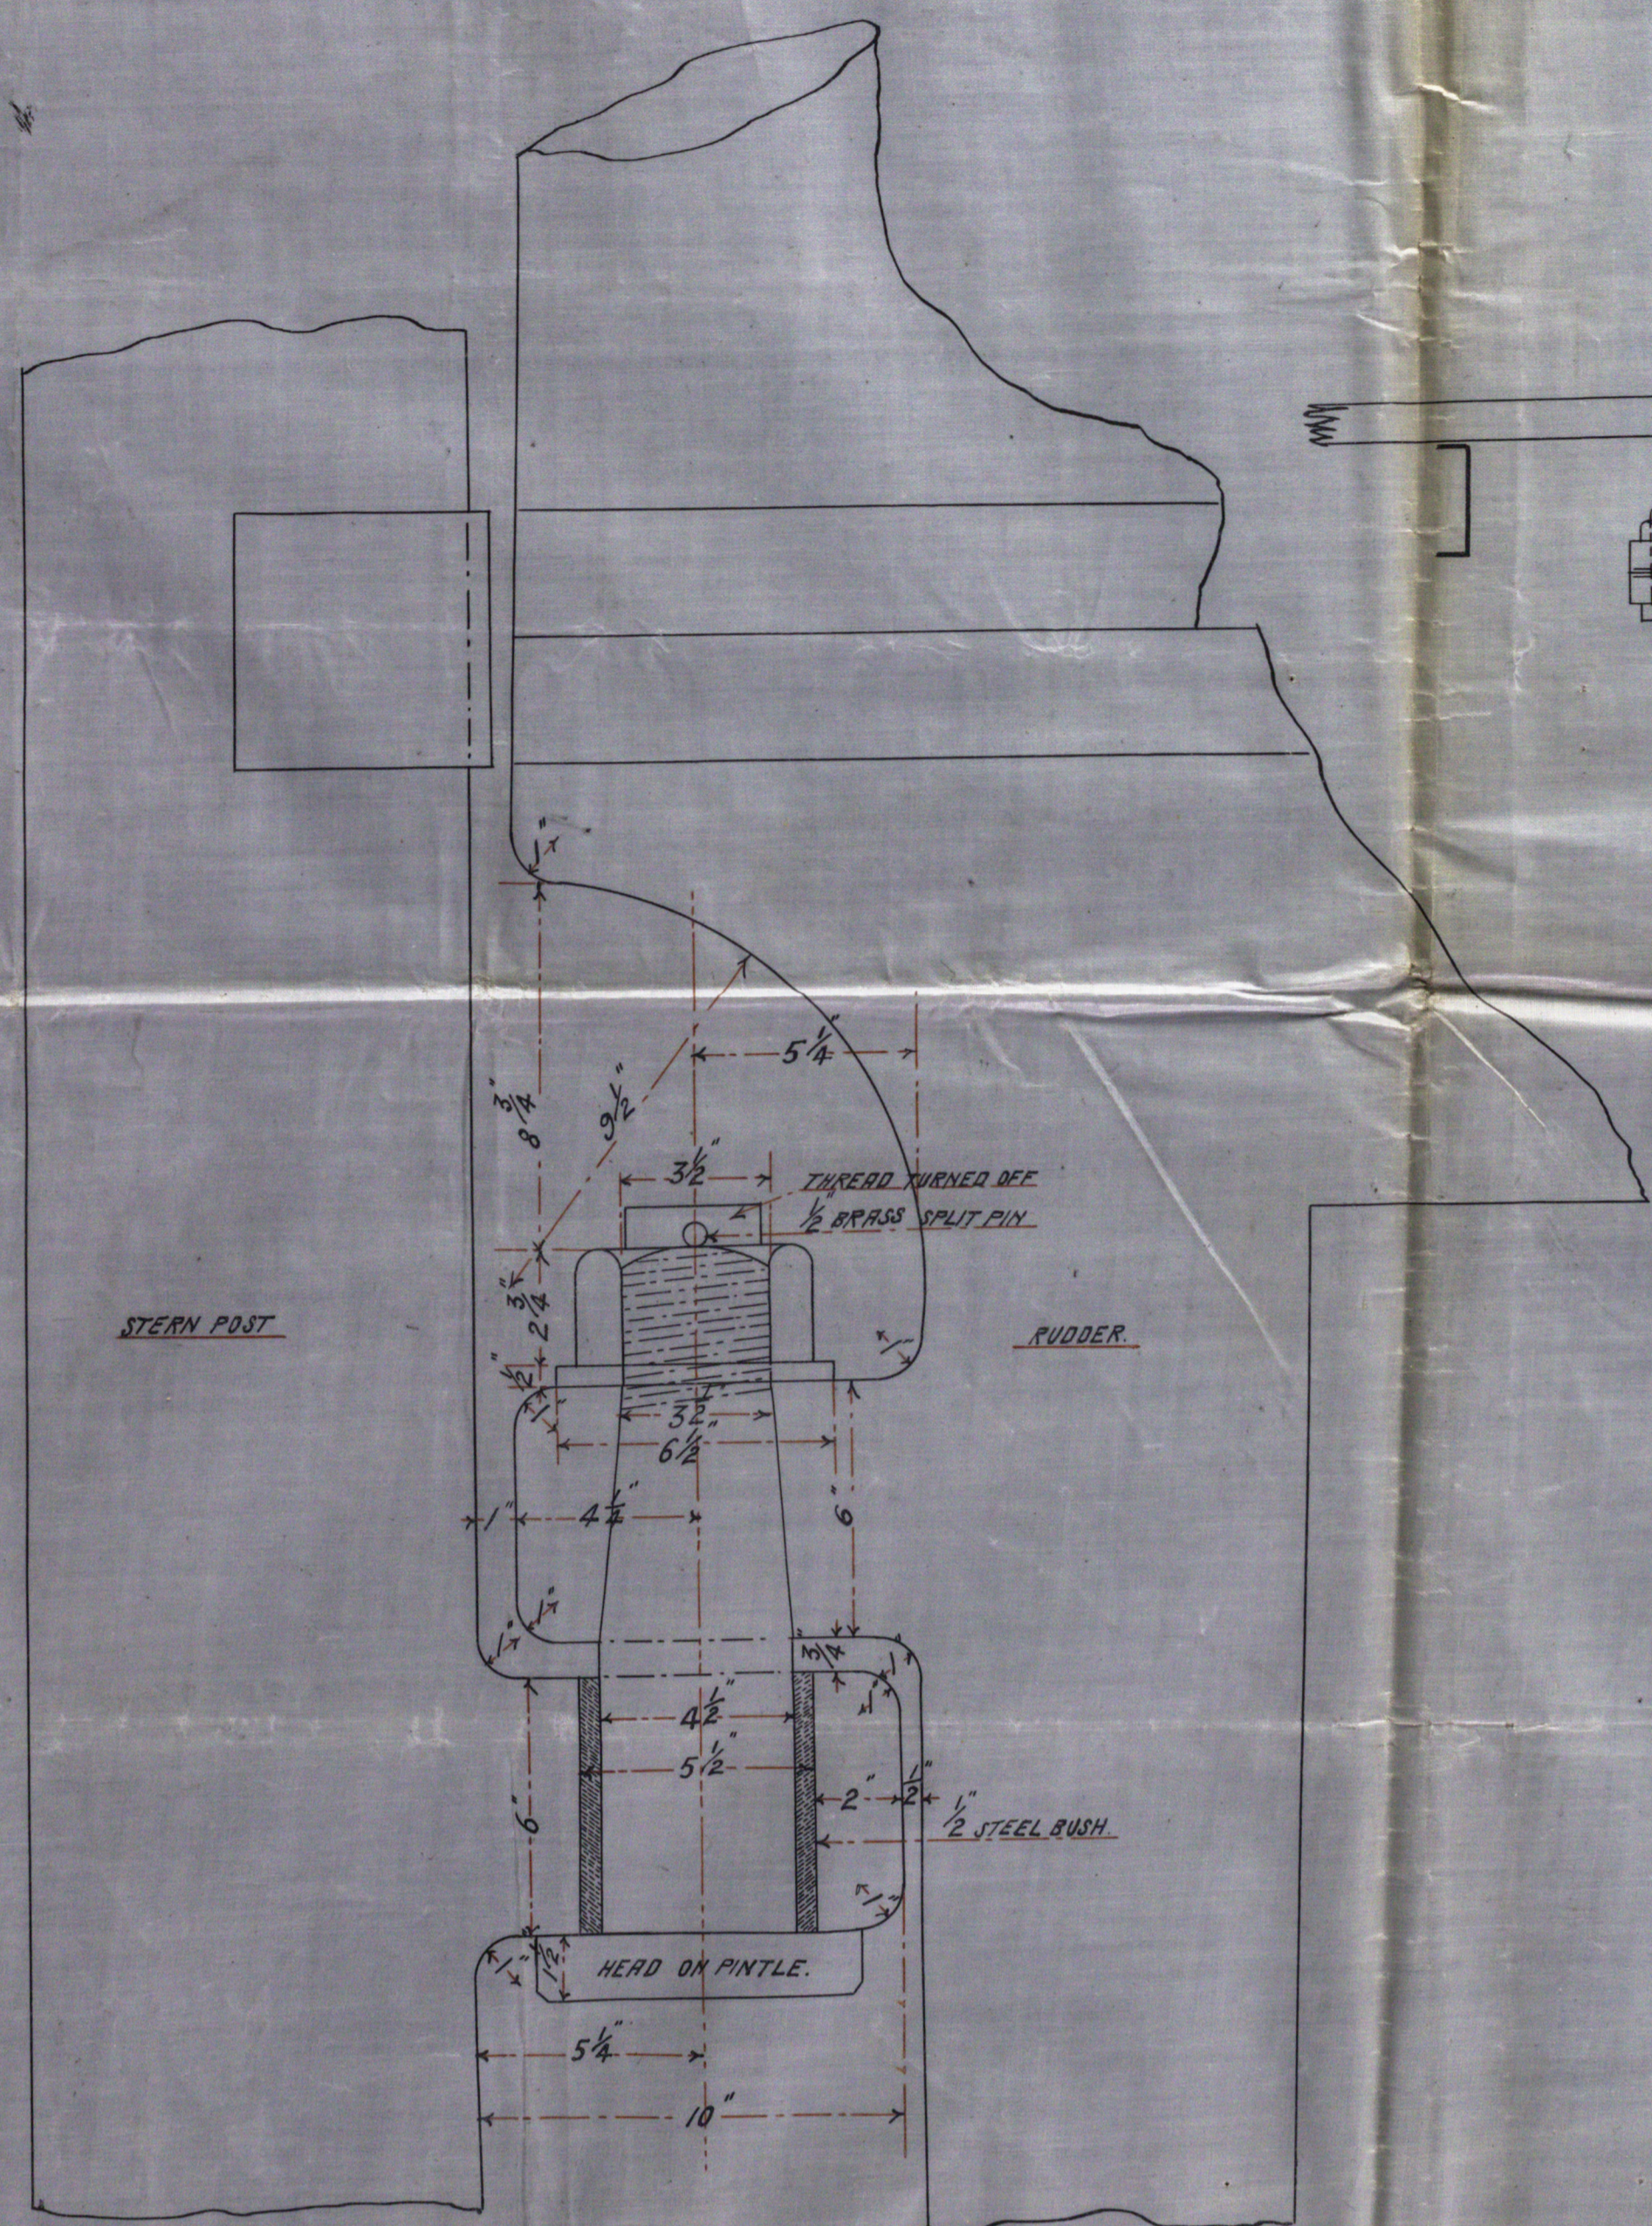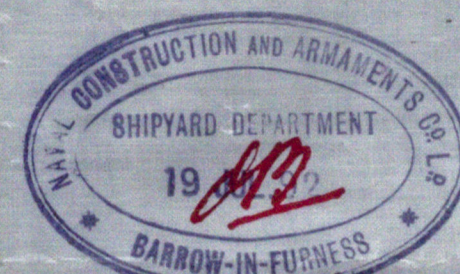


SECTION AT GUDGEON A  
SCALE 3/4 IN. = ONE FOOT

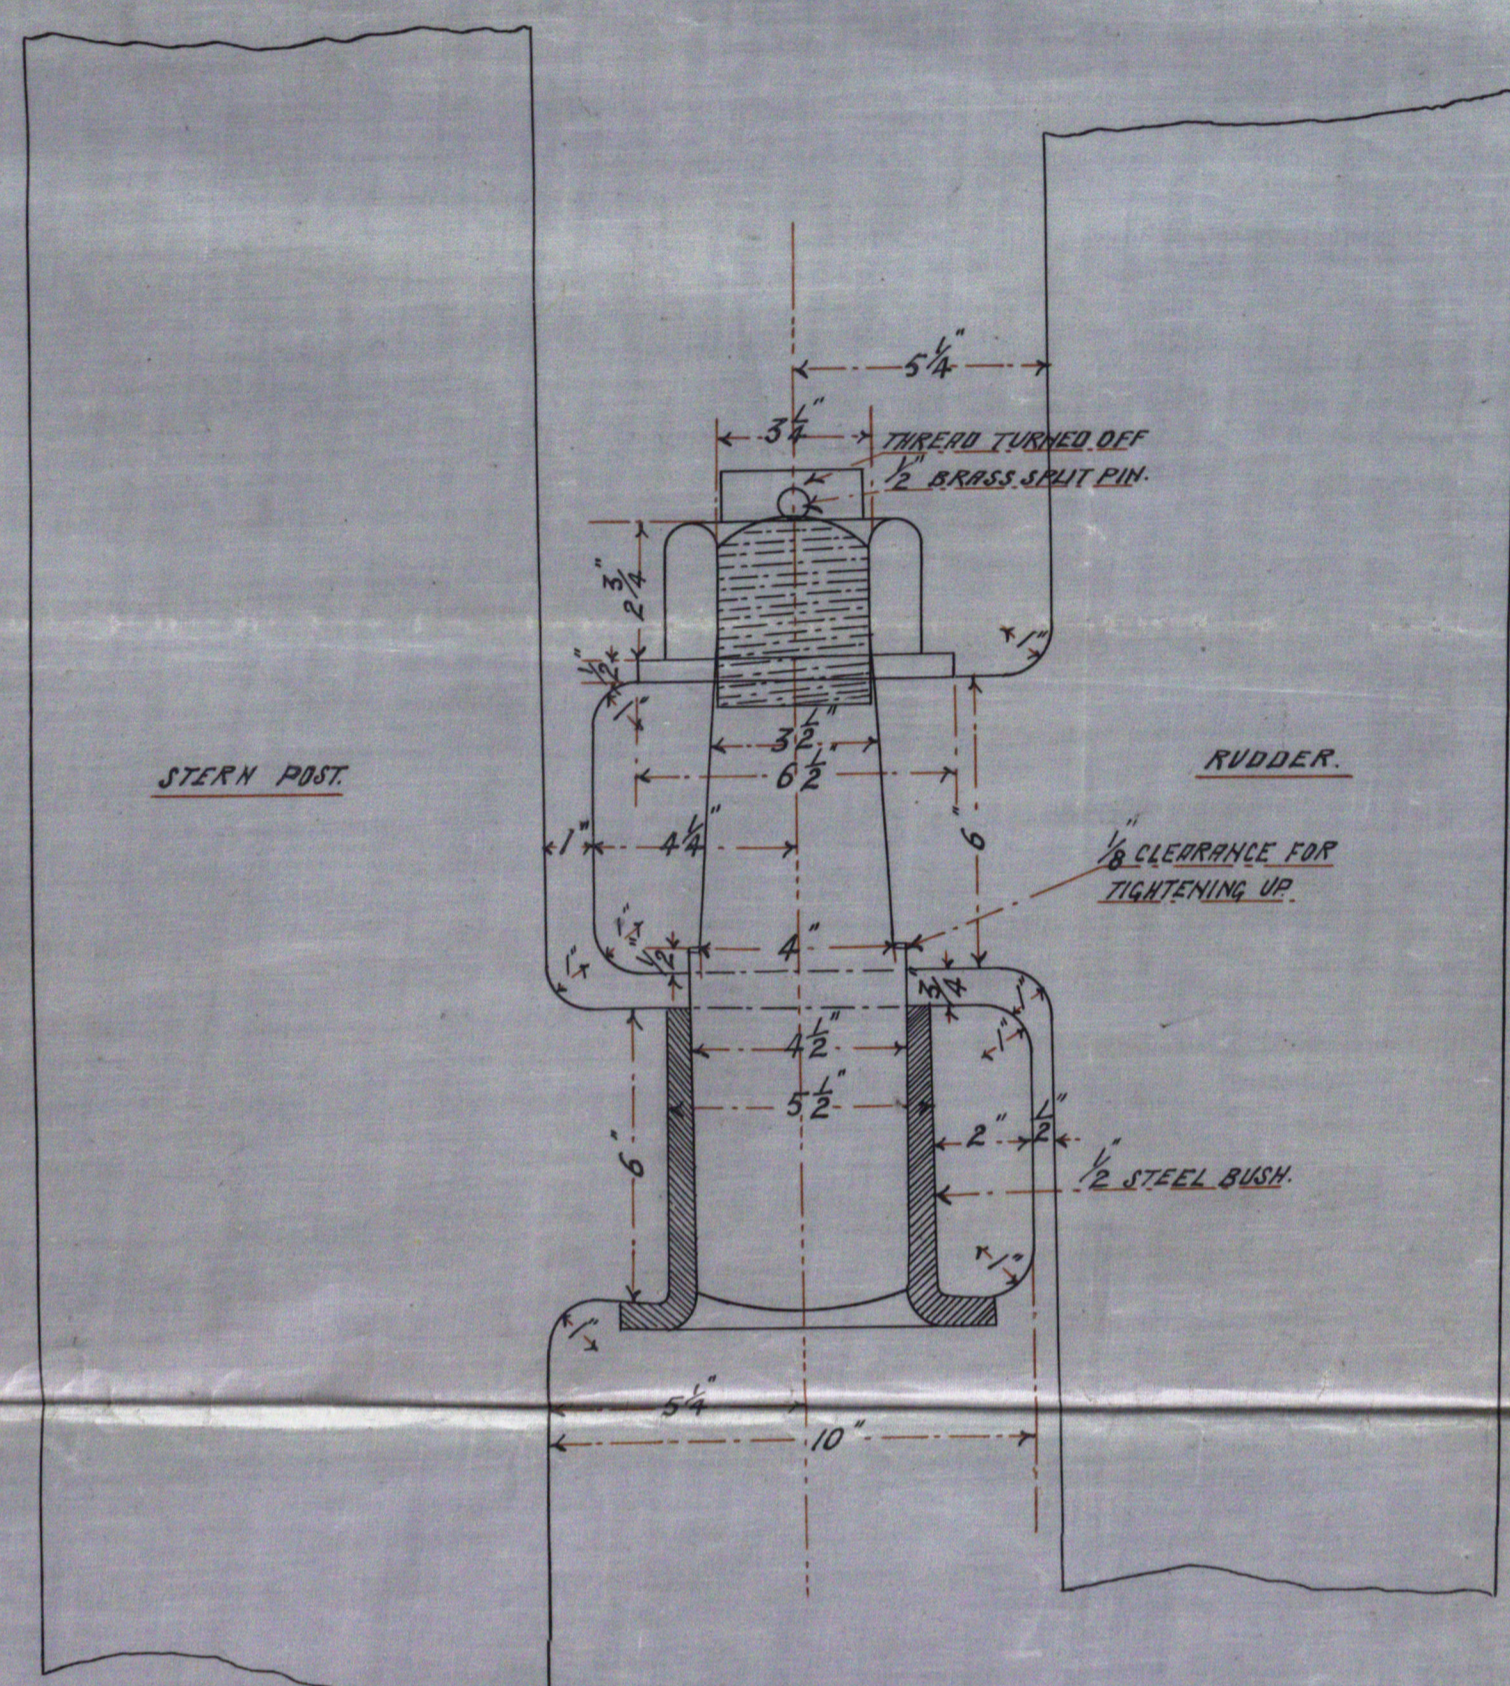




SECTION AT GUDGEONS B & C  
SCALE 3/4 IN. = ONE FOOT

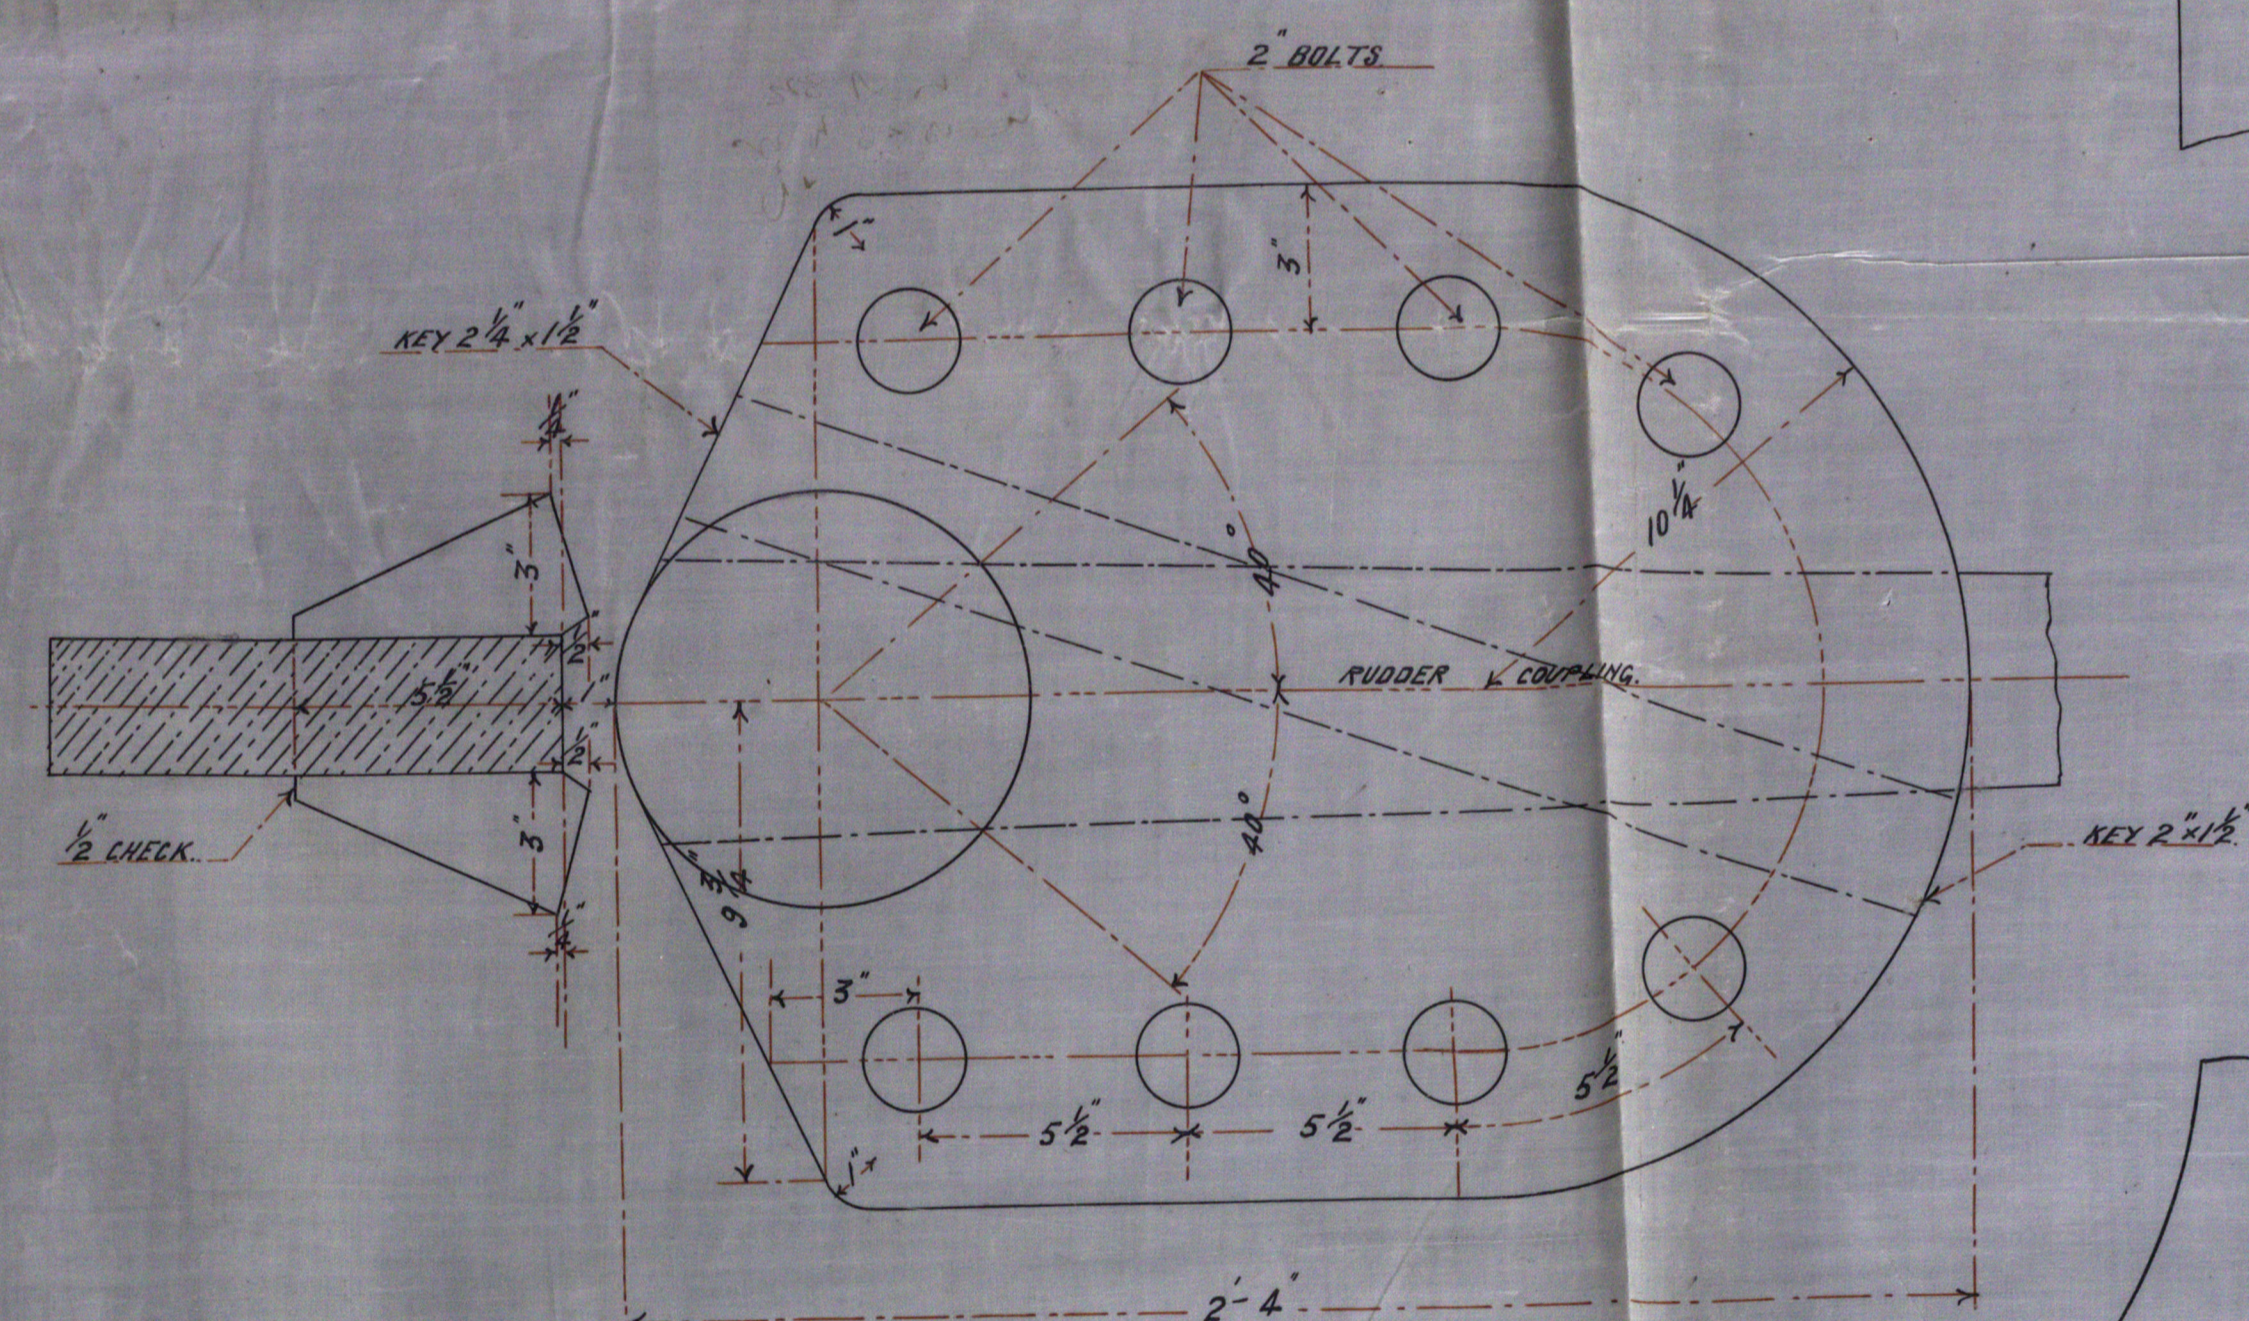

PLAN AT RUDDER COUPLING & STOPPER  
SCALE 3/4 IN. = ONE FOOT

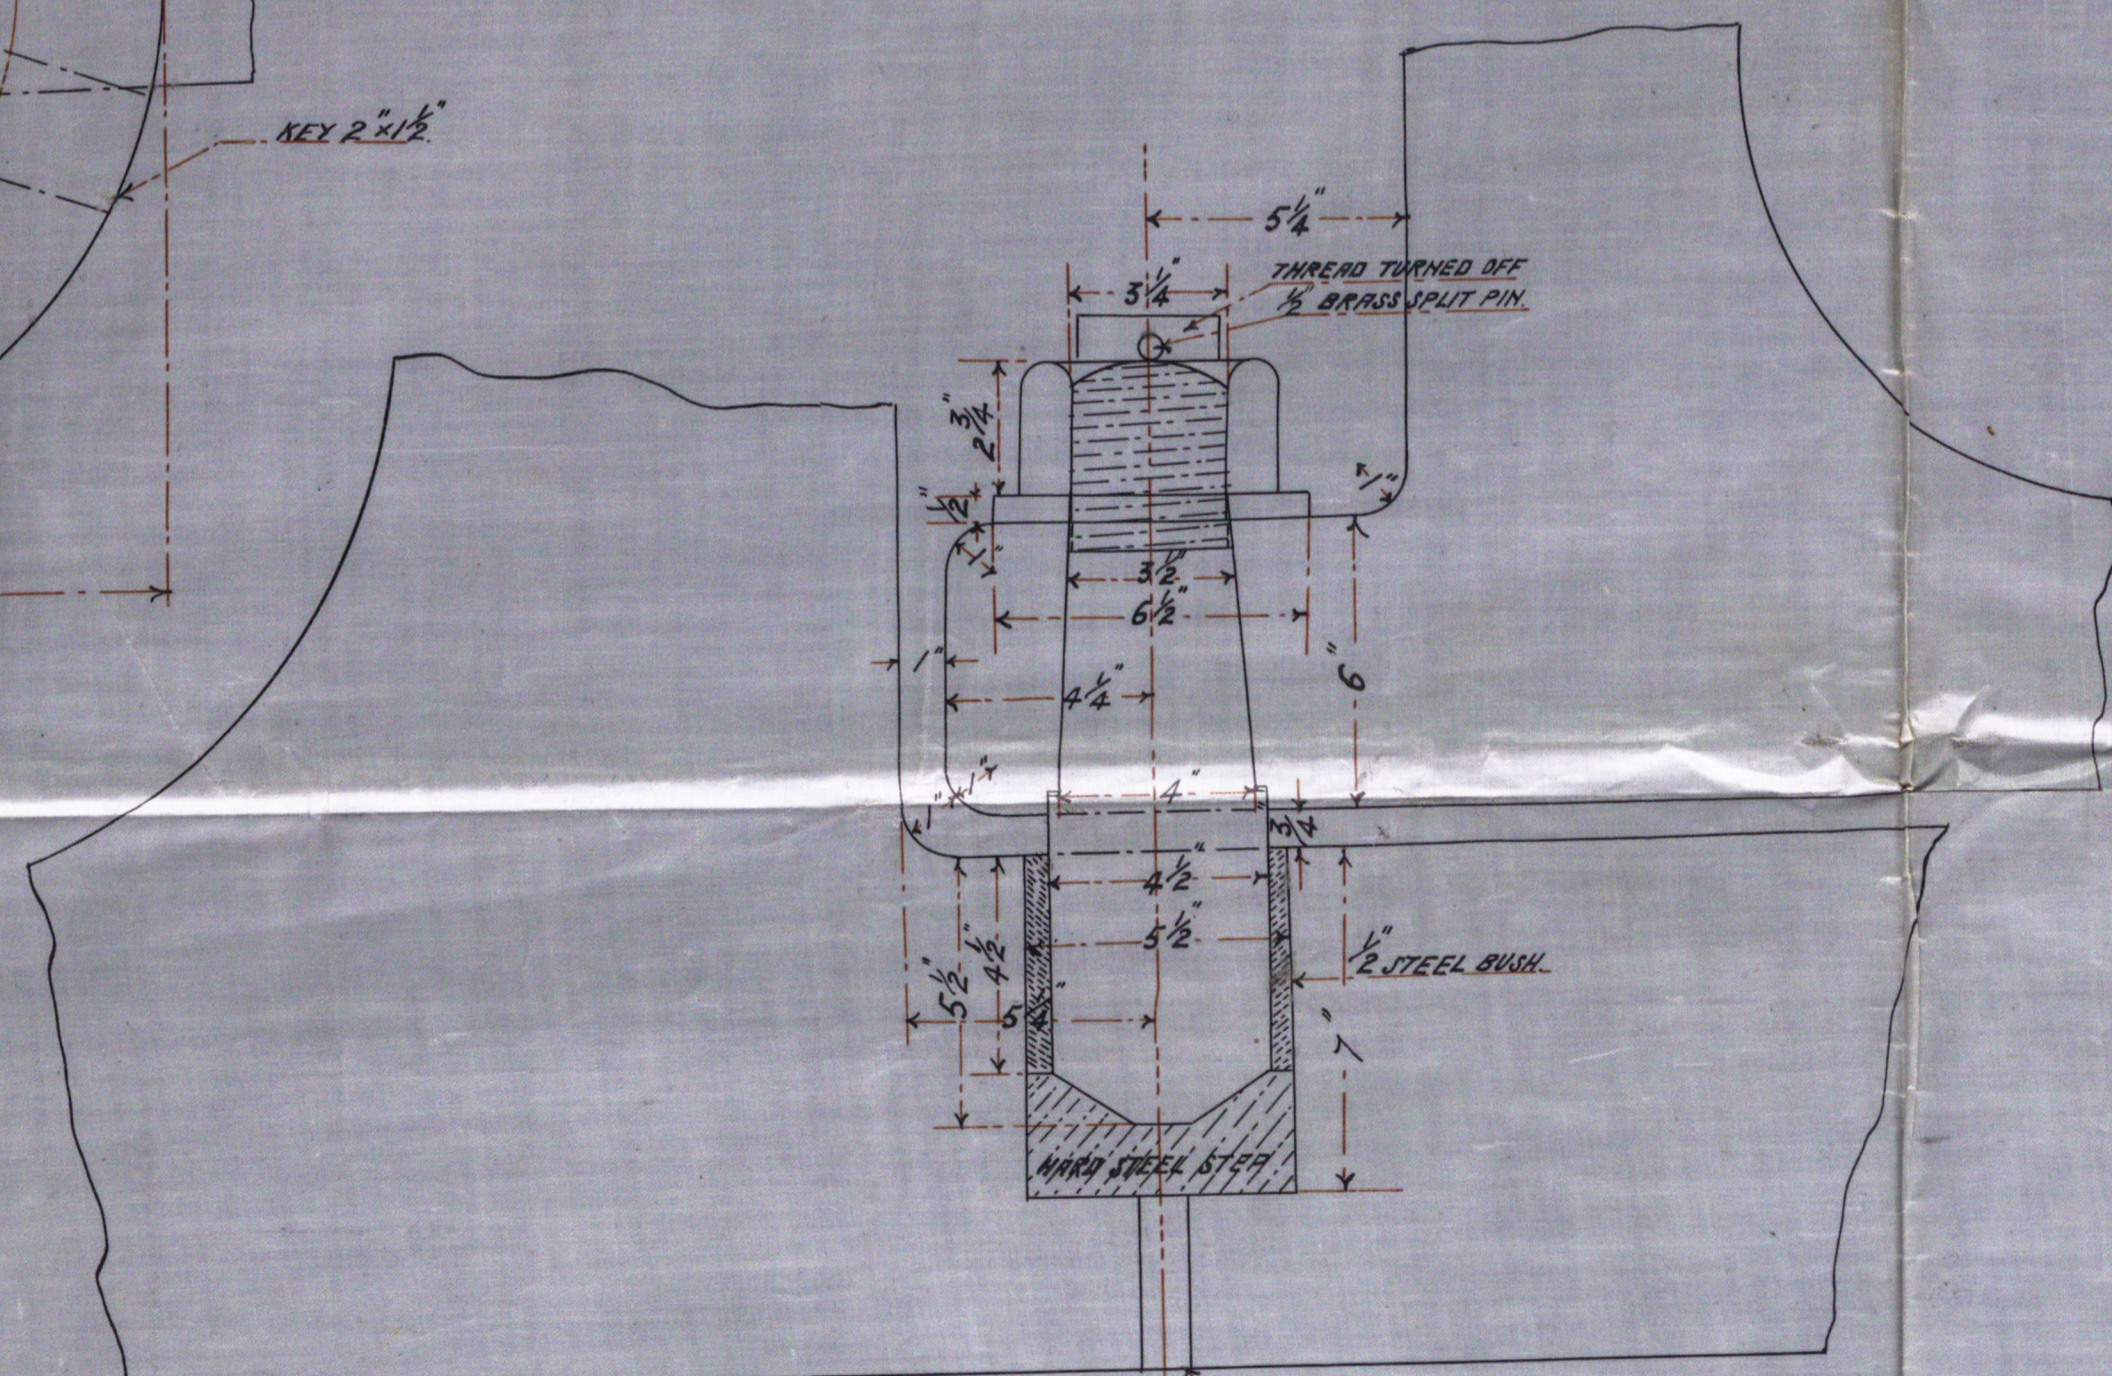

SECTION AT GUDGEON D  
SCALE 3/4 IN. = ONE FOOT

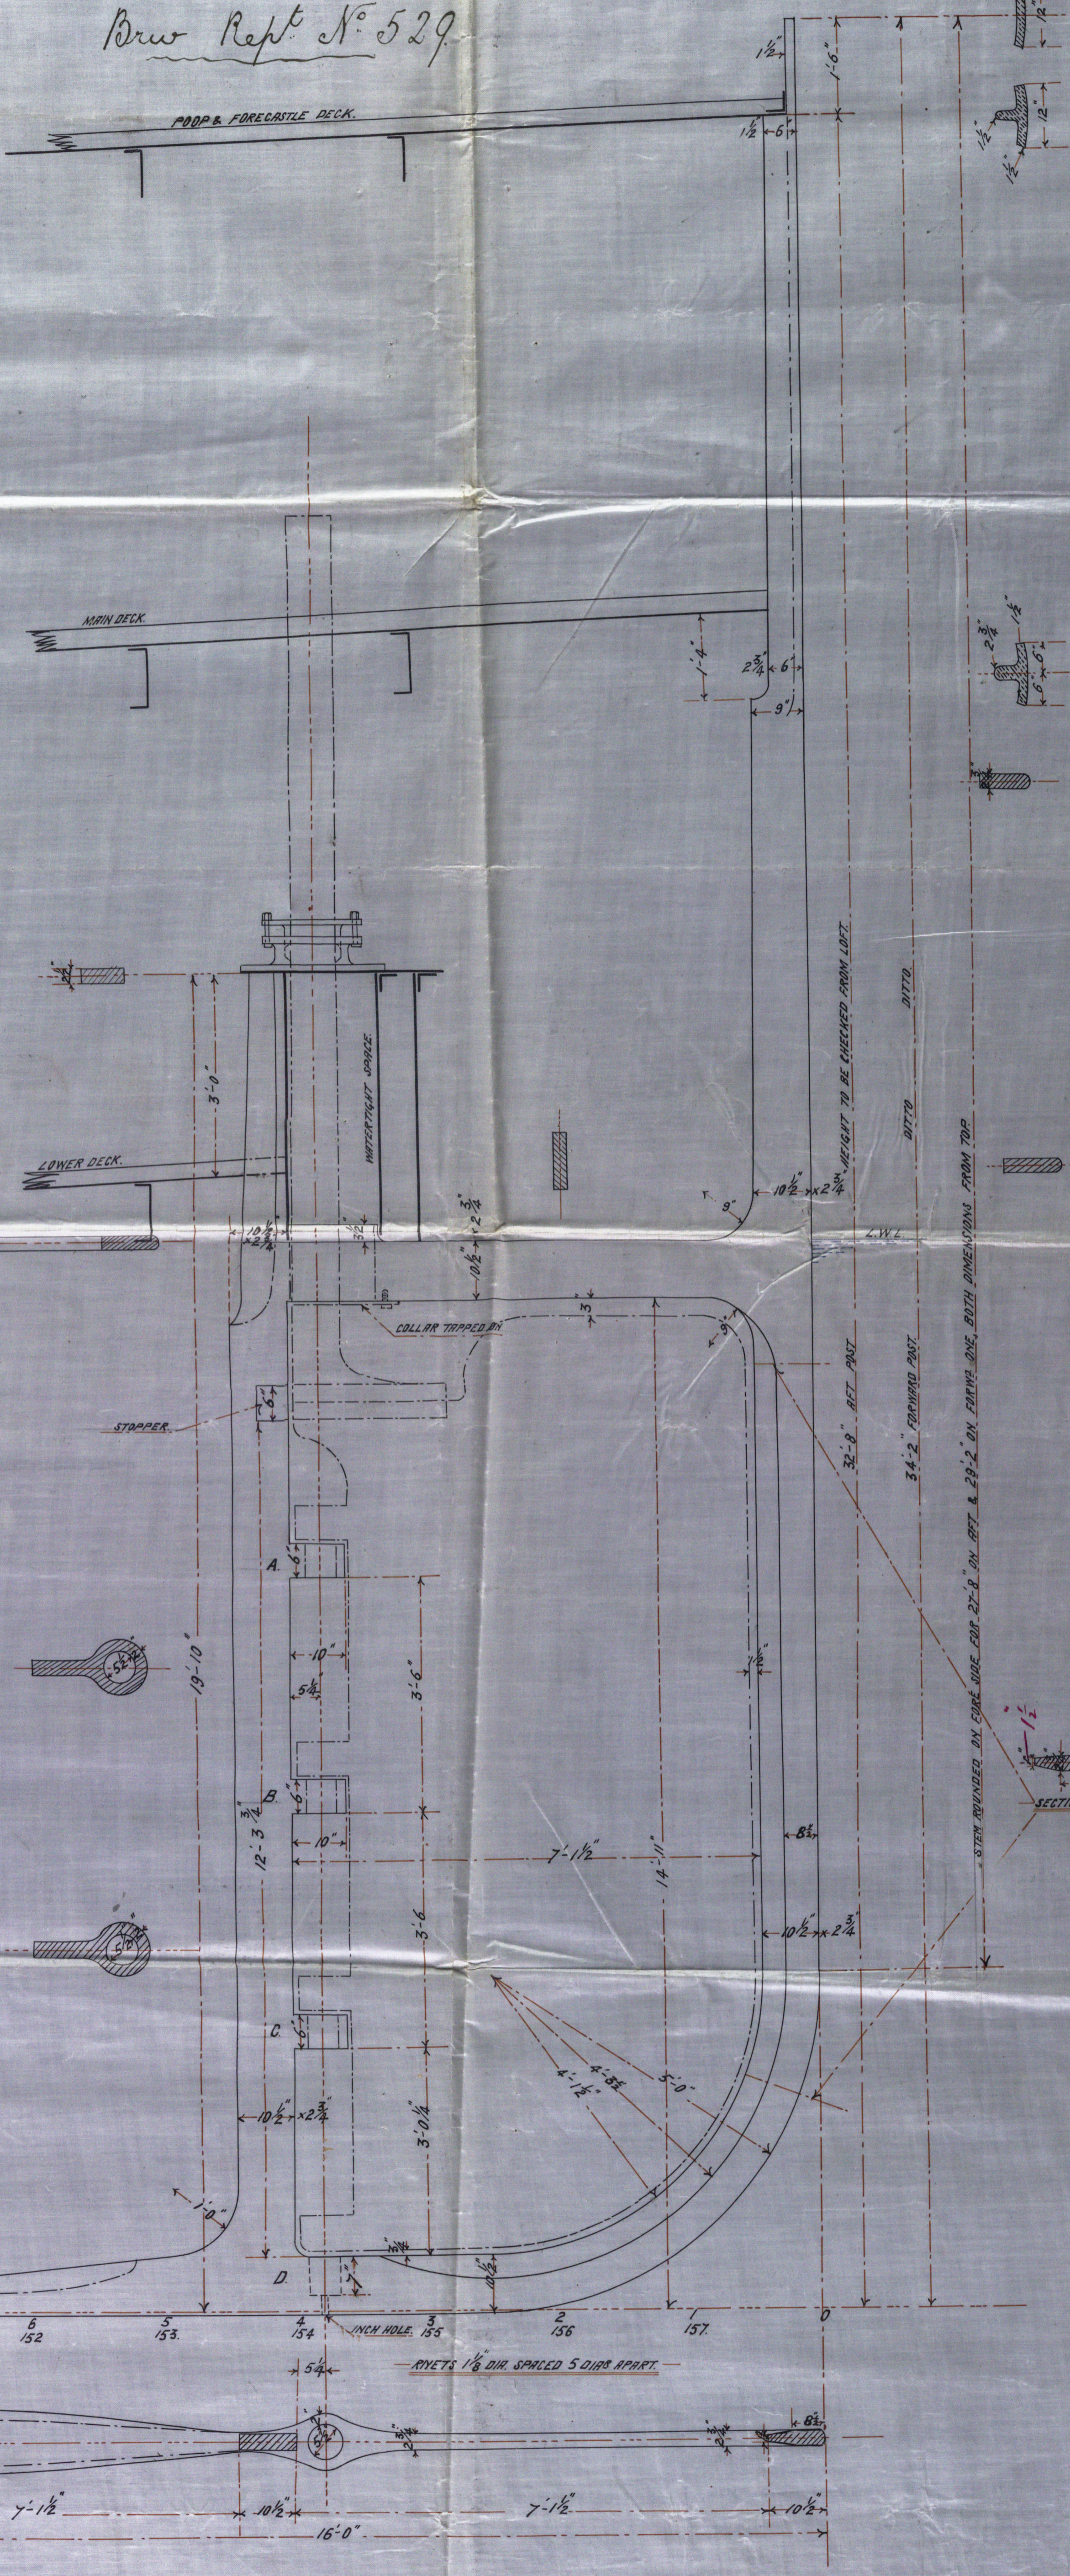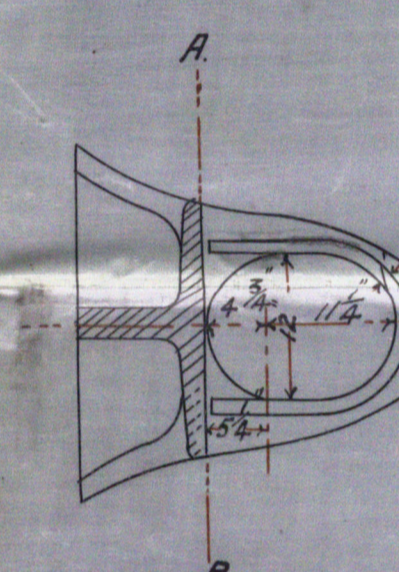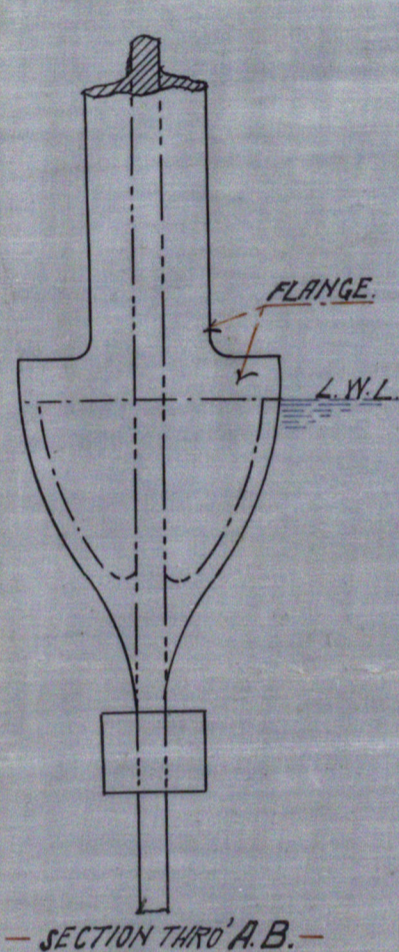

SECTION THRU

SECTION THRU