

14.12.93.


S.S. "Clan Ross"

Bow Rept No 604

S.S. Nos 227-8

AMENDED CONSTRUCTION OF MAIN HATCH.

SCALE 1/8 INCH = ONE FOOT.

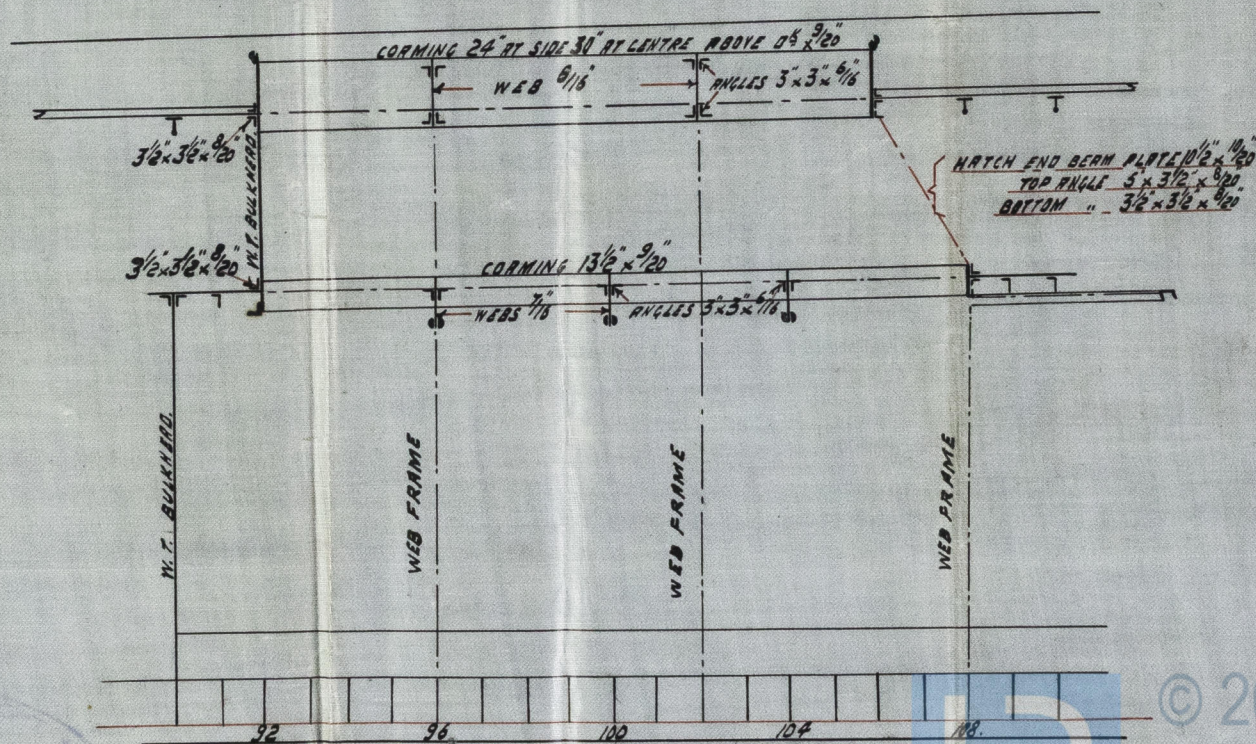

© 2021

Lloyd's Register
Foundation

BLW43-0064