


7.12.93.
21.12.93.


W.T. BULK^o N^o 90

AT POKE END OF DEEP TANK.
LOOKING FORW^d.



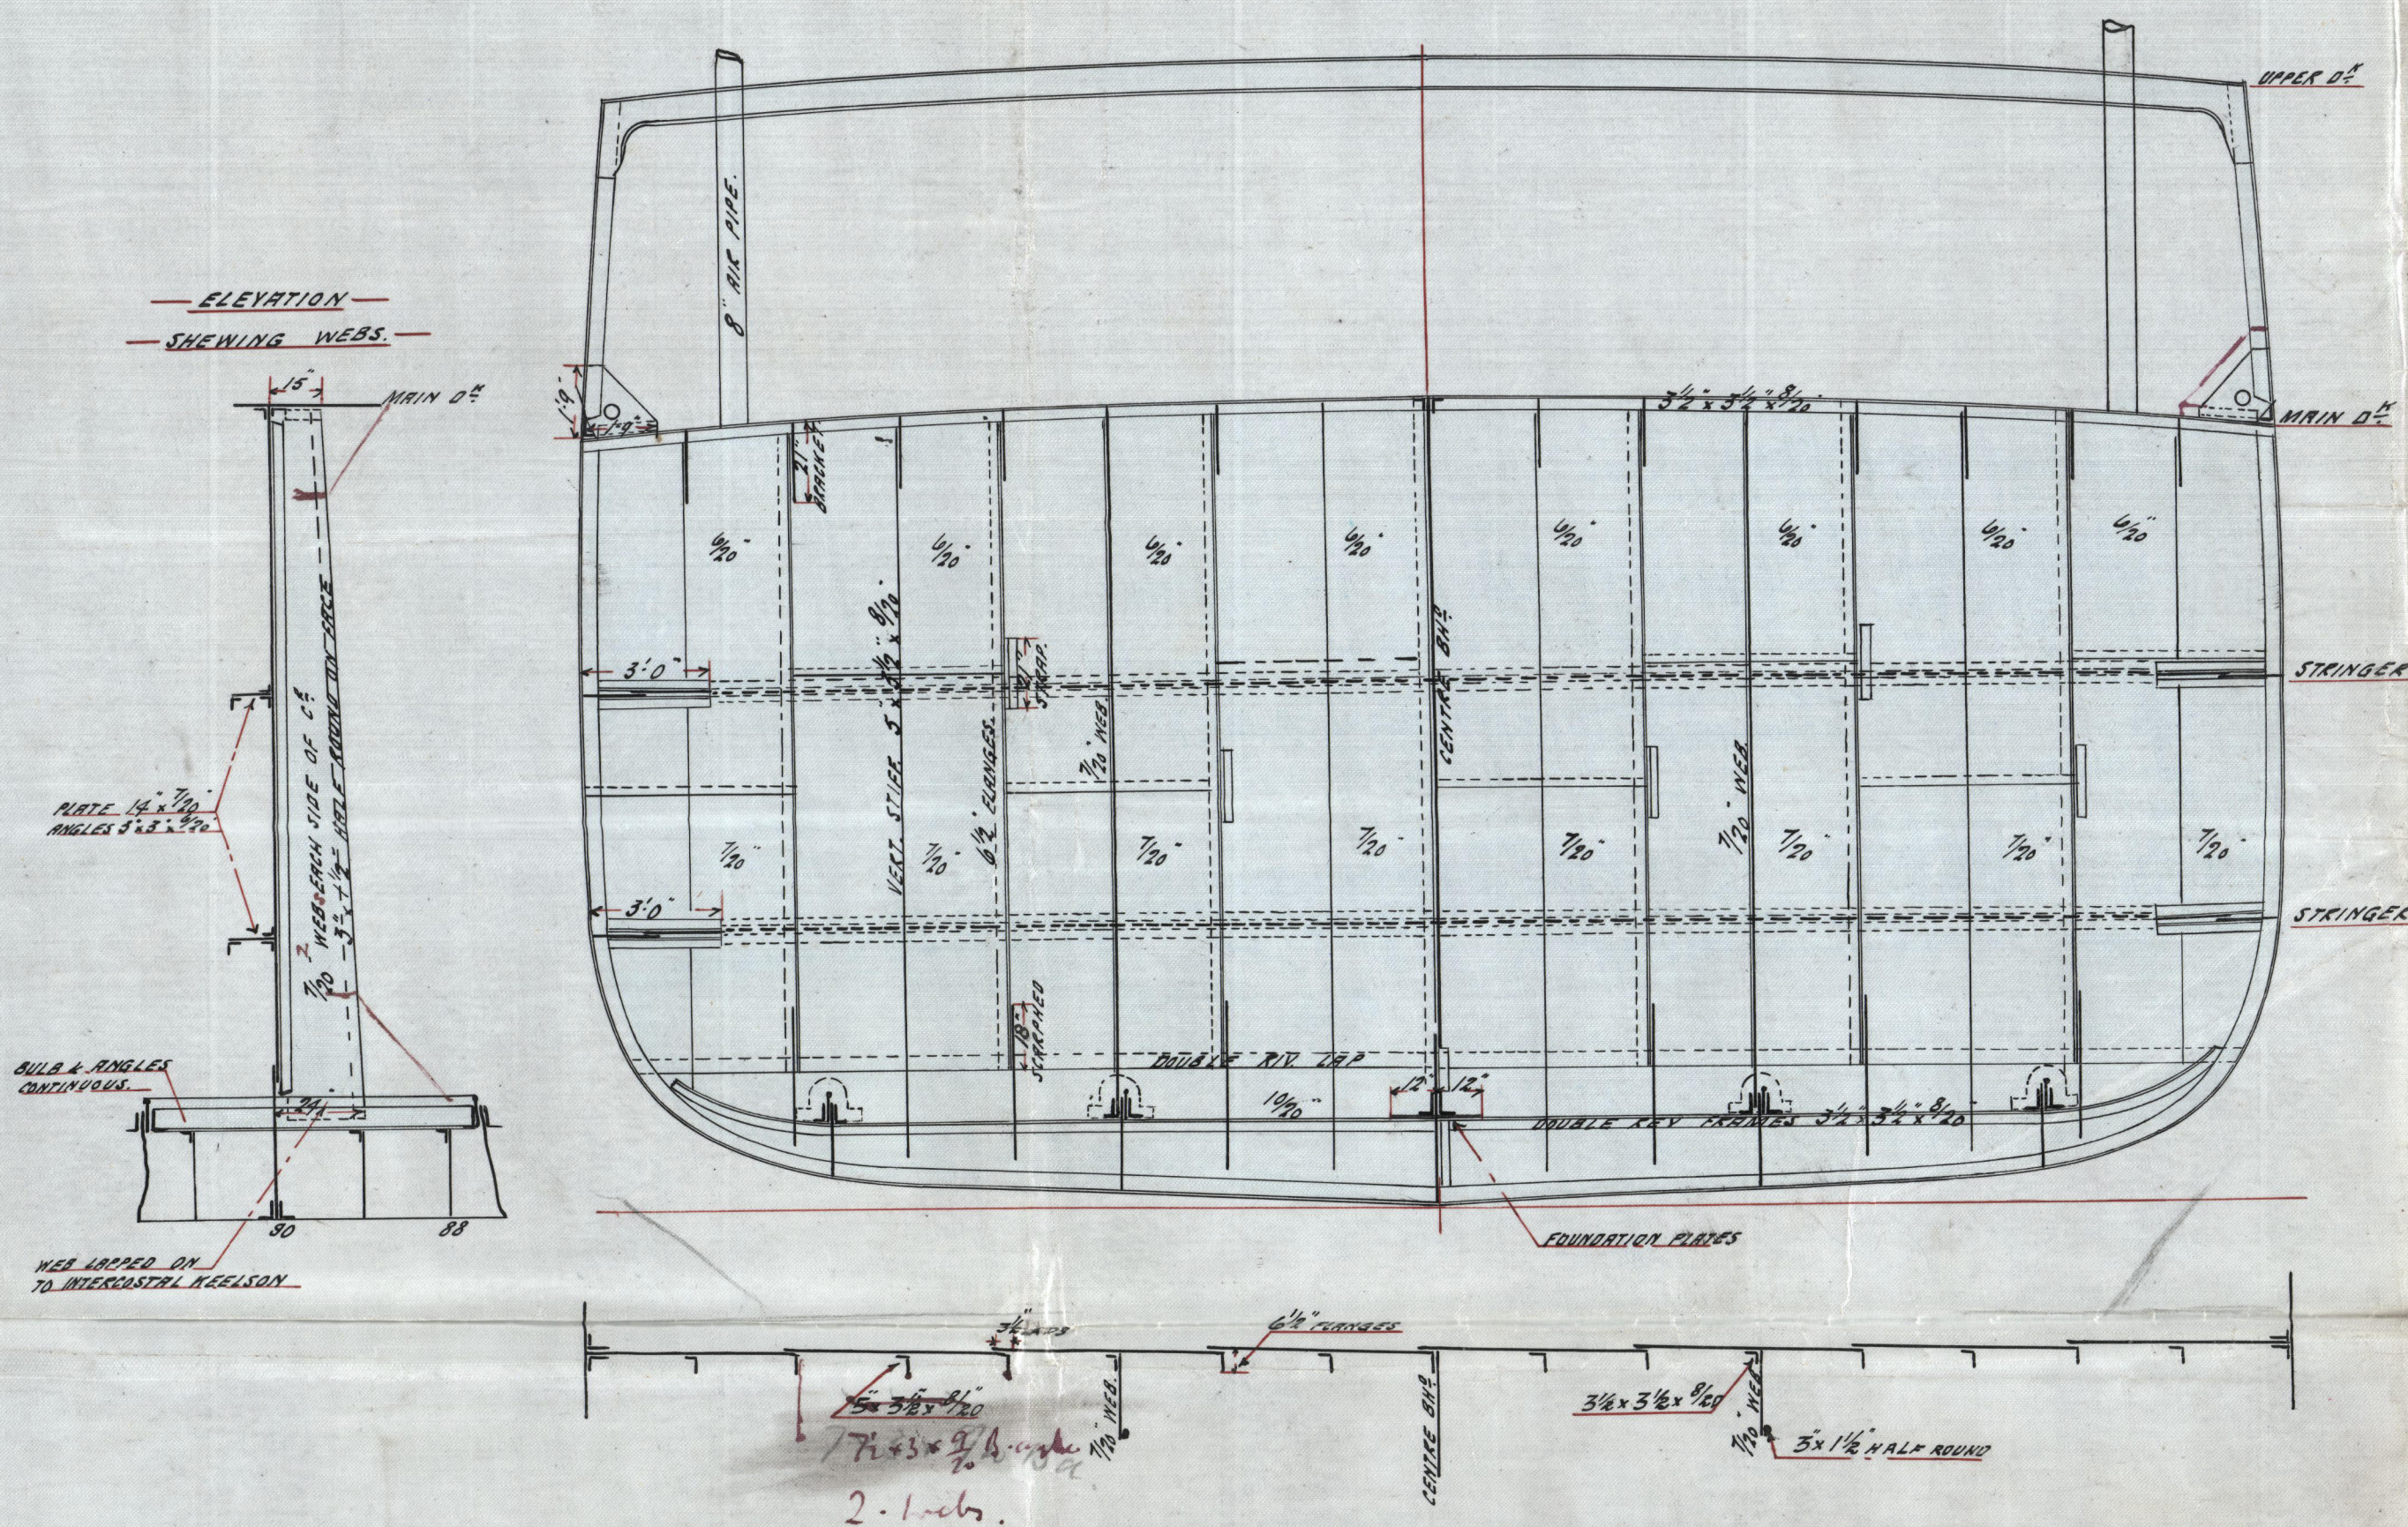


W.T. BULK^o N^o 73

AT AFTER END OF DEEP TANK.
LOOKING AFT.

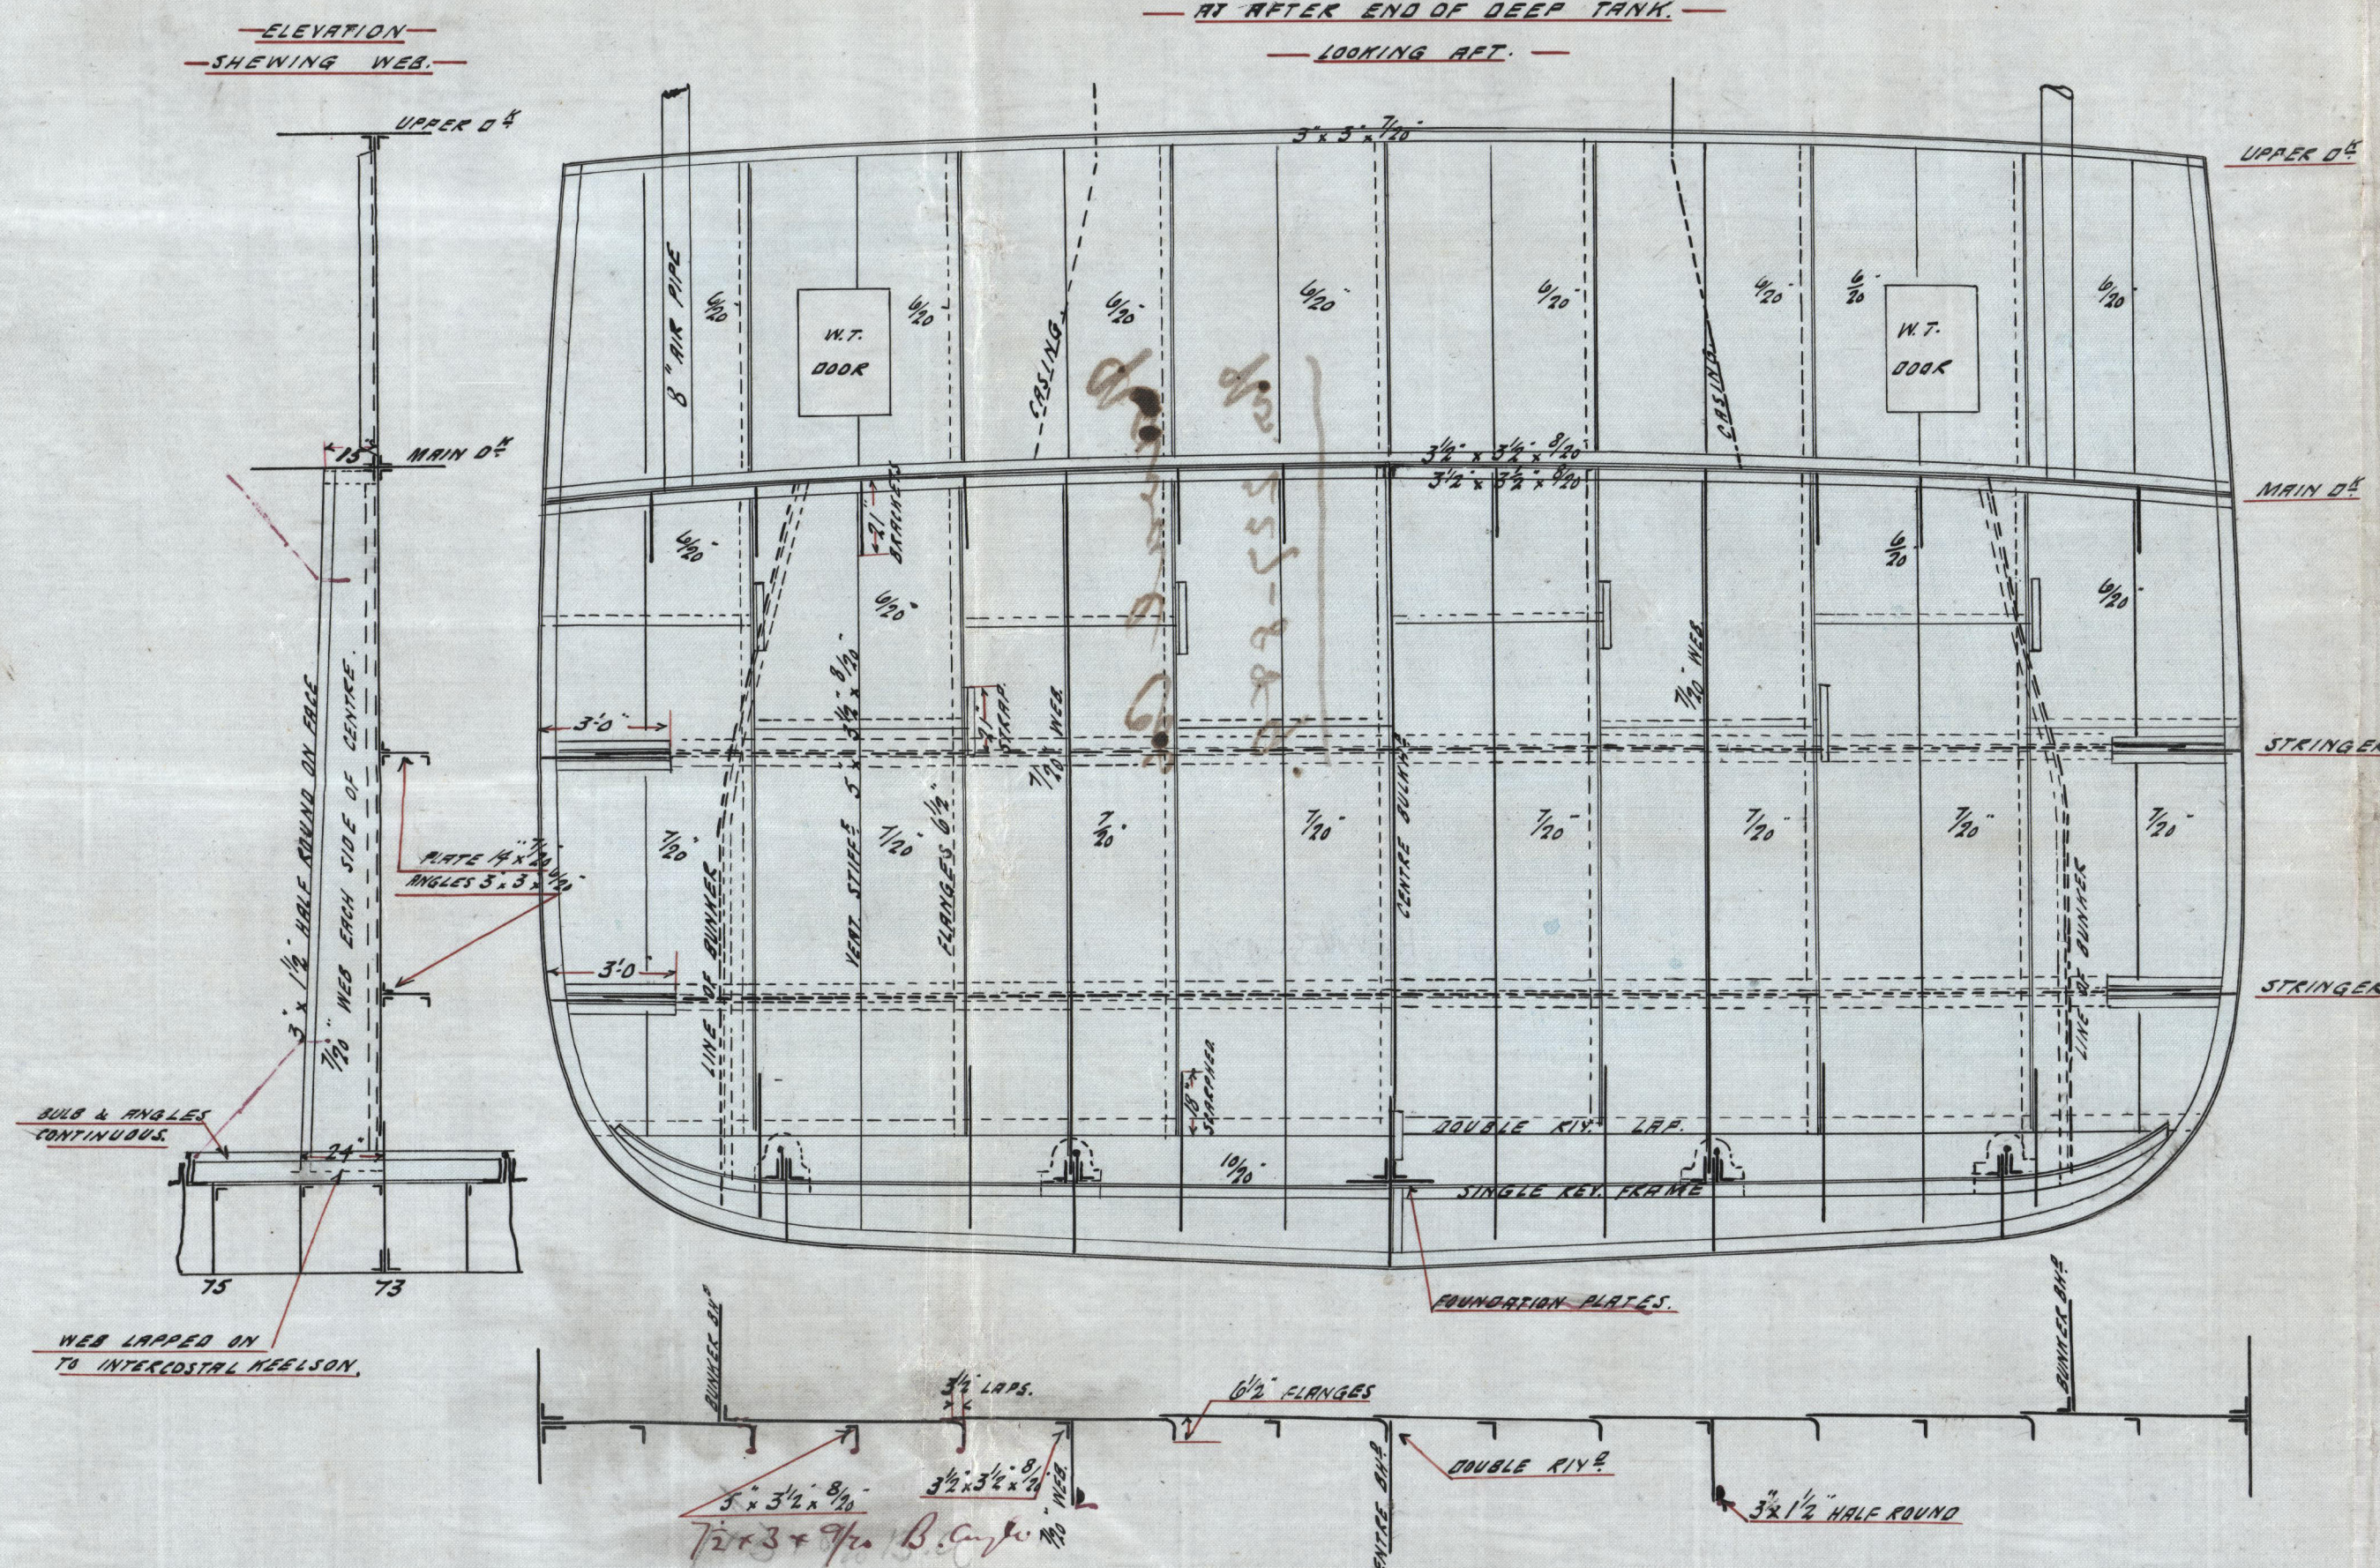

CENTRE LINE BULKH^o
NOT W.T.

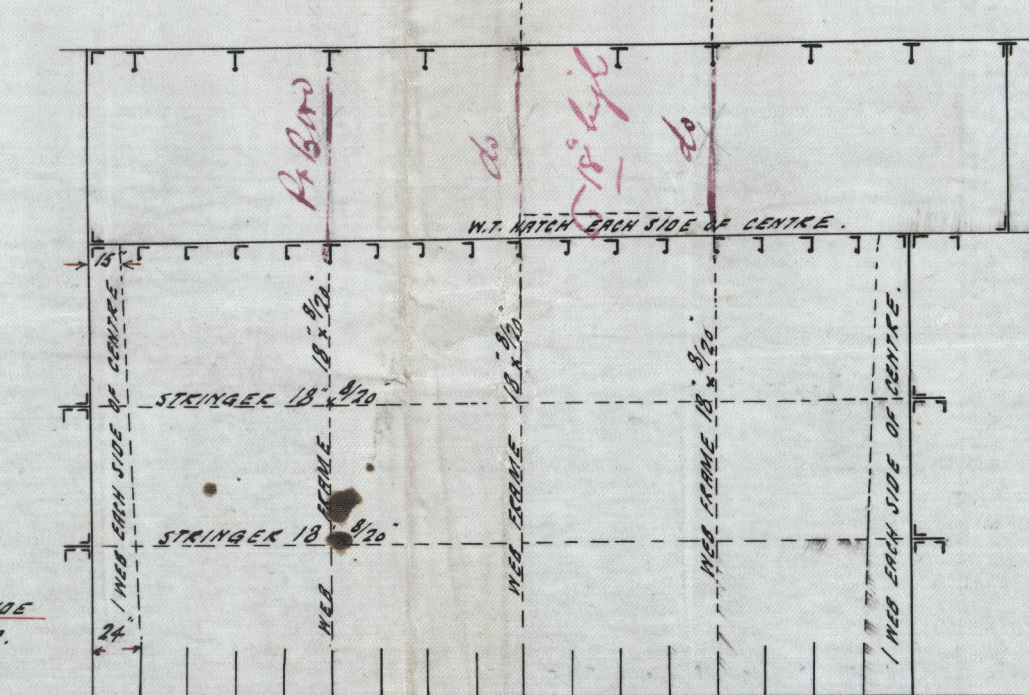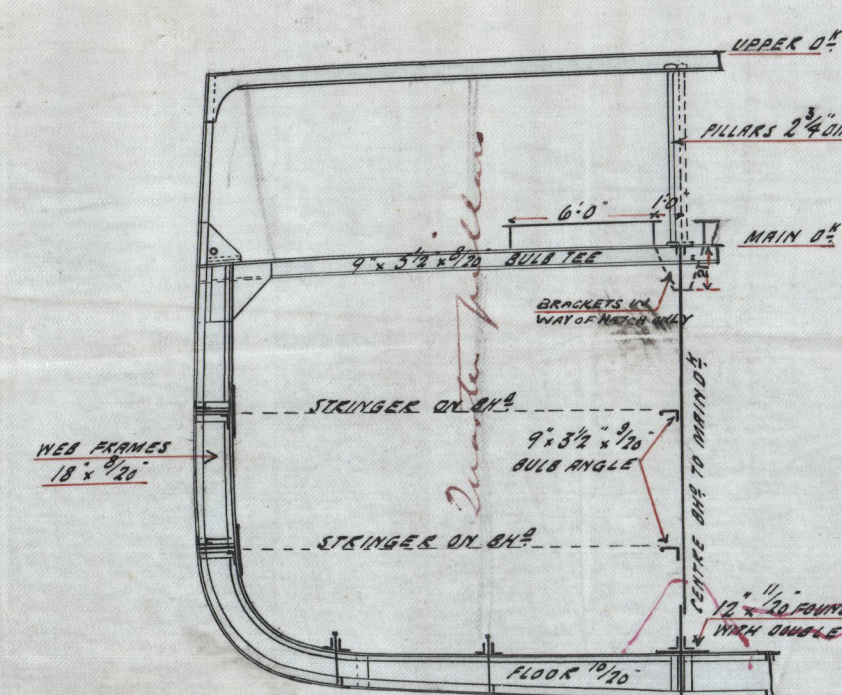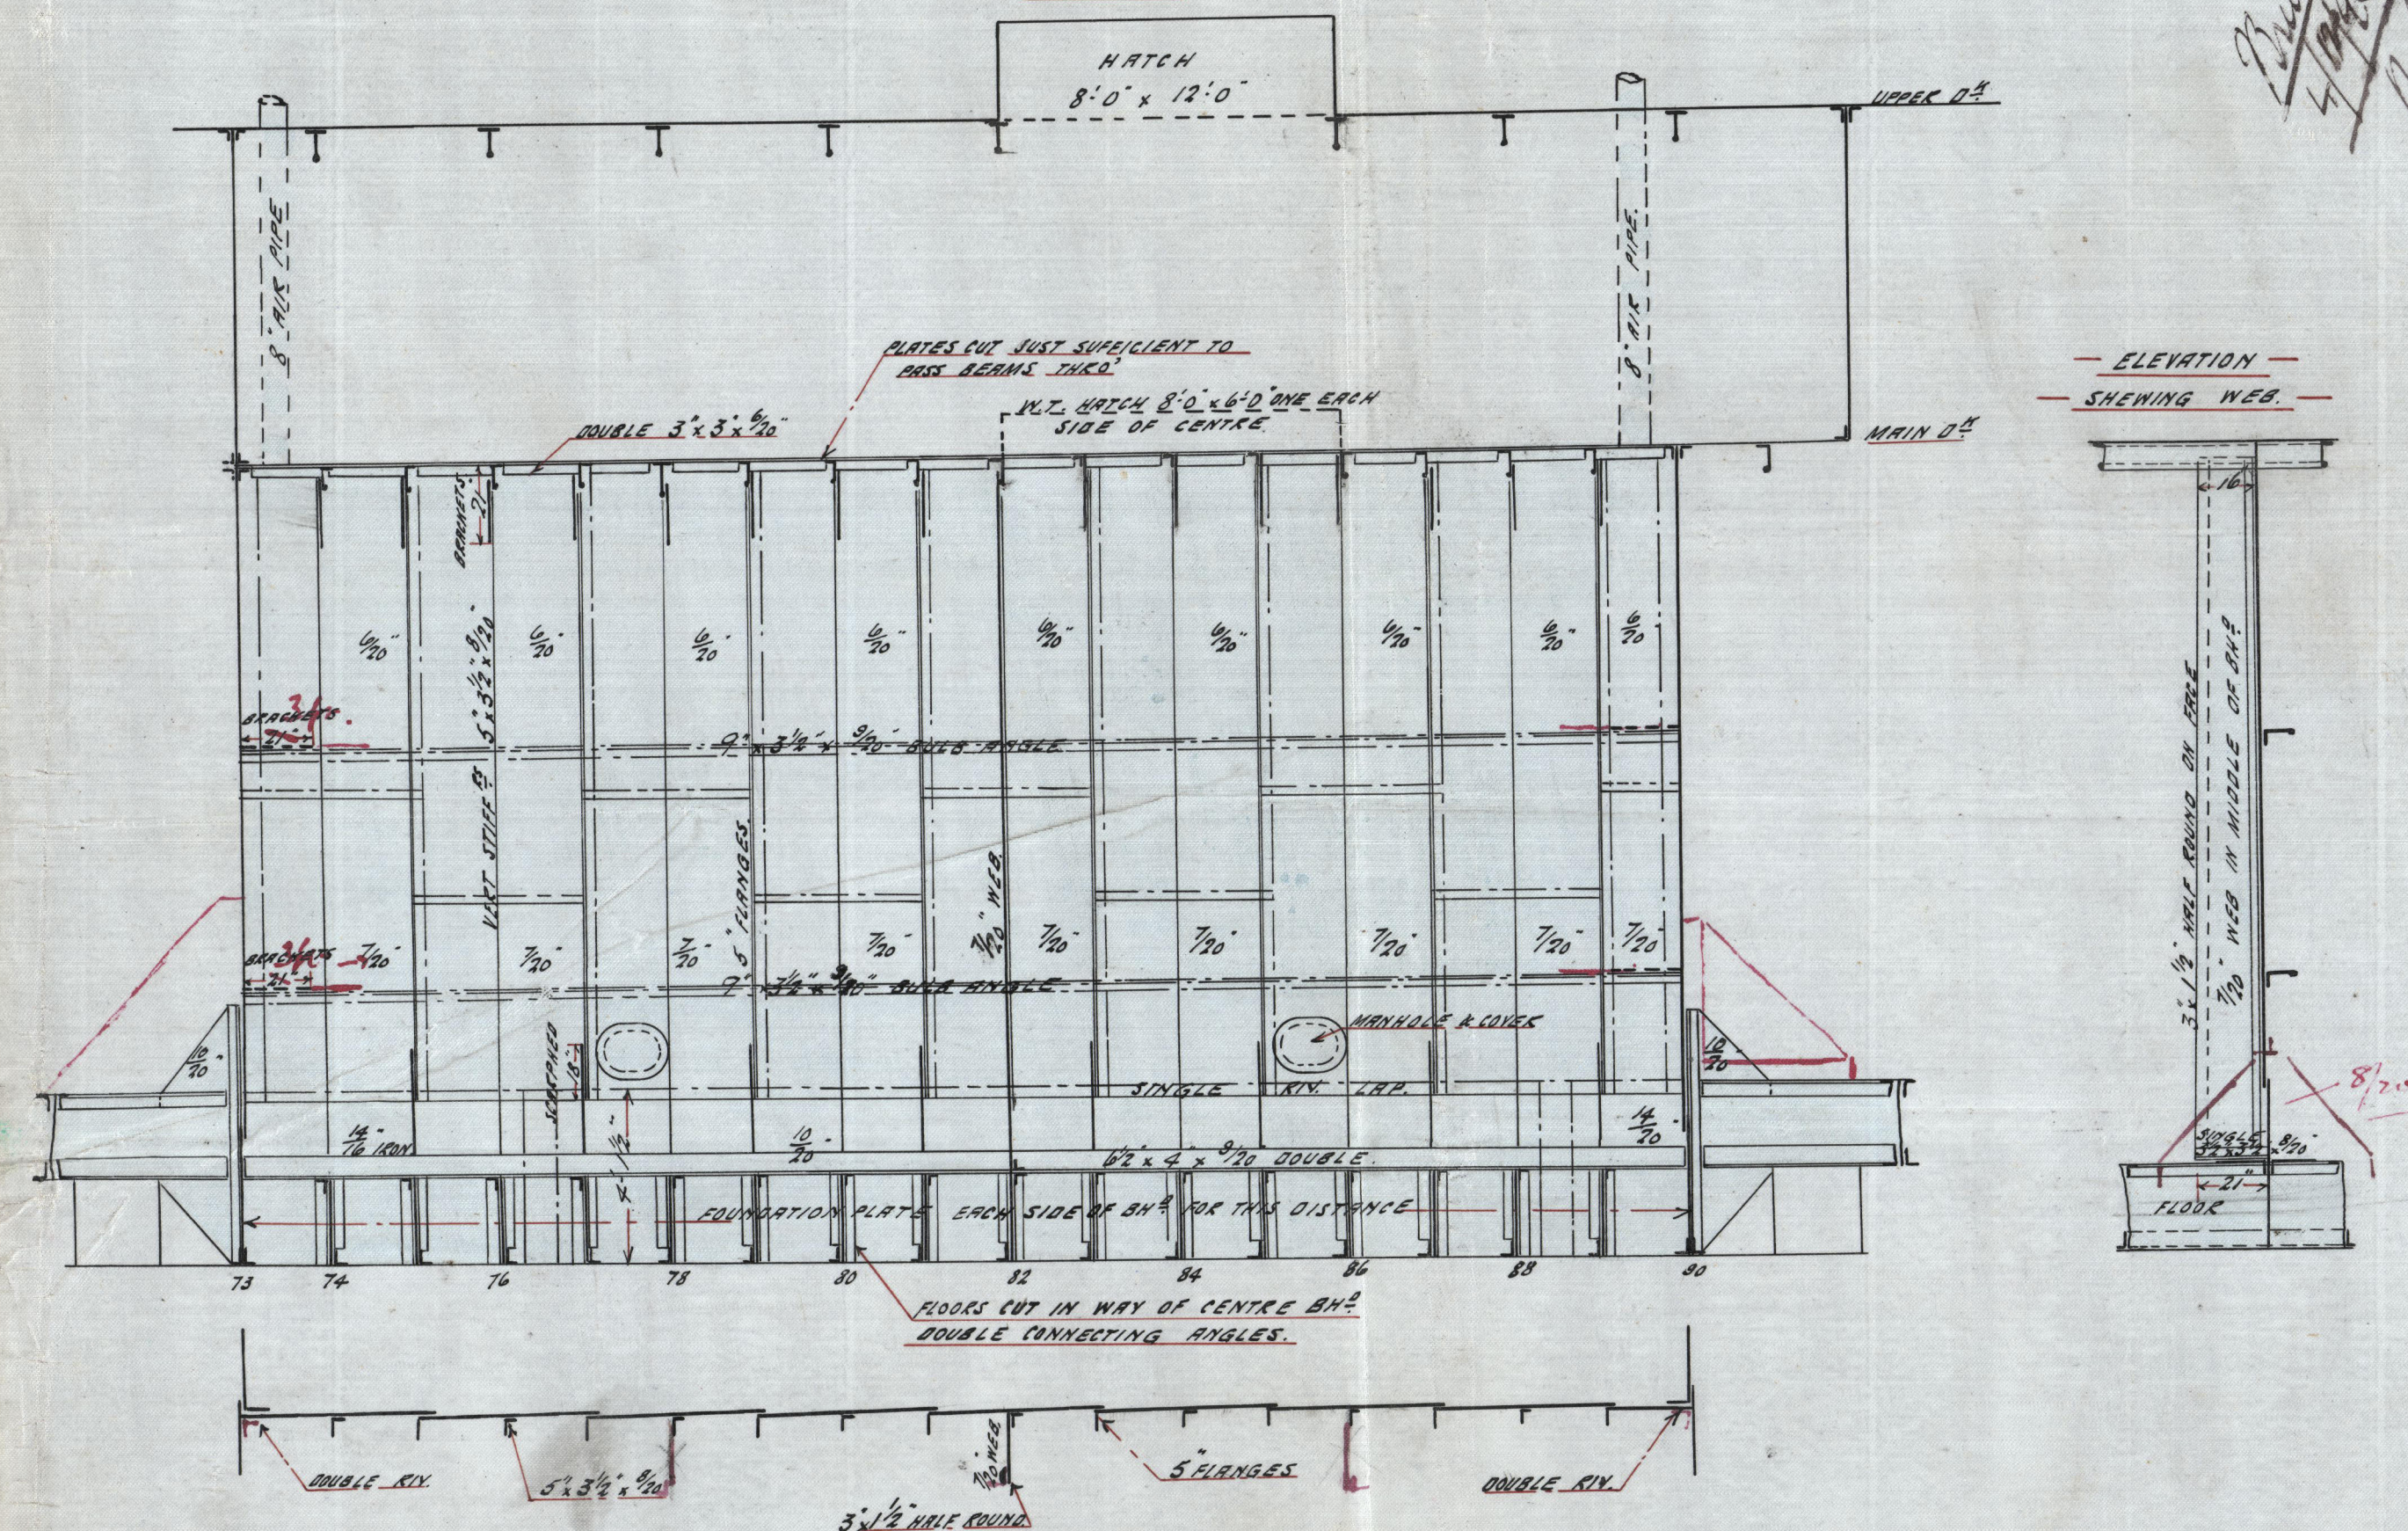

S.S. N^{os} 227-8.

BULKHEADS IN WAY OF DEEP TANK AMIDSHIPS.

SCALE 1/4 INCH = ONE FOOT.

J.S. "Glan Ross"
Brw Rept. N^o 607.