



N^{os} 227-8-9.

BRIDGE FRONT STIFFENING.


== SCALE $\frac{1}{4}$ " = 1 FOOT. ==

S.S. Glen Ross
Bur Rept. No 609.


~~24/4/24~~

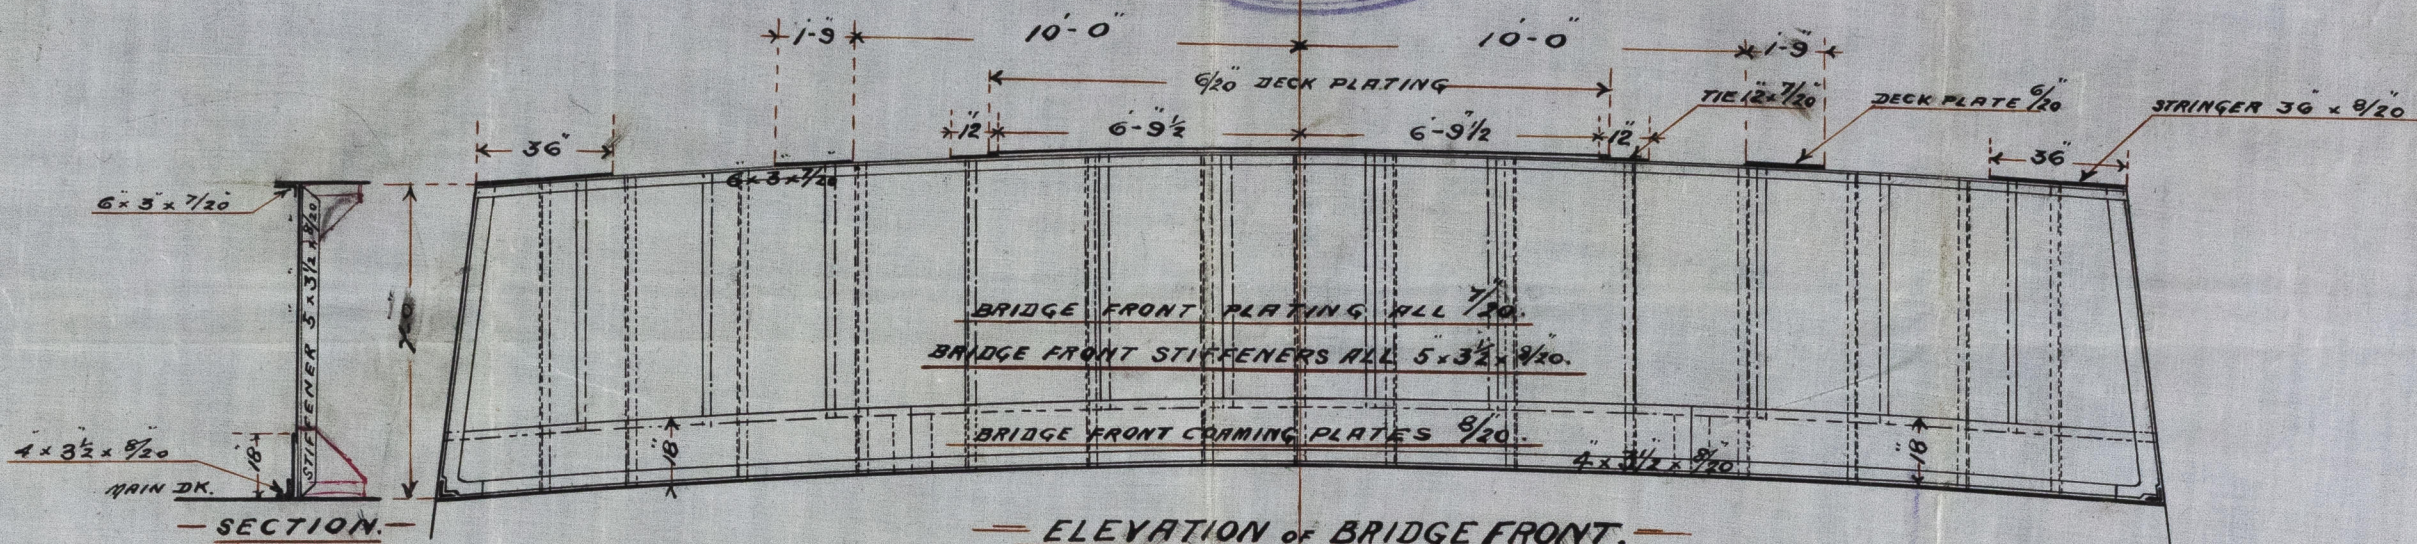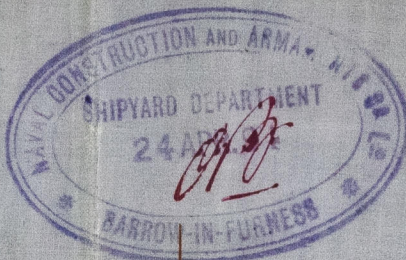

Stiffeners to be bracketed top & bottom

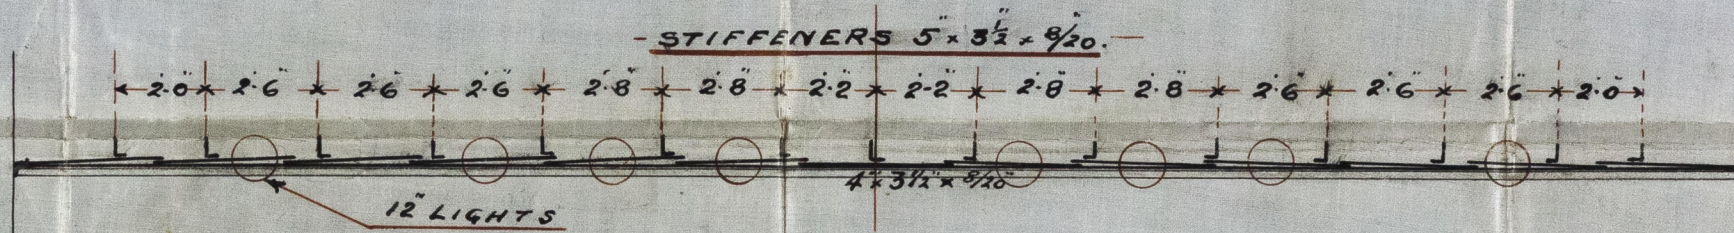

PLAN OF BRIDGE FRONT AT UPPER D^K.

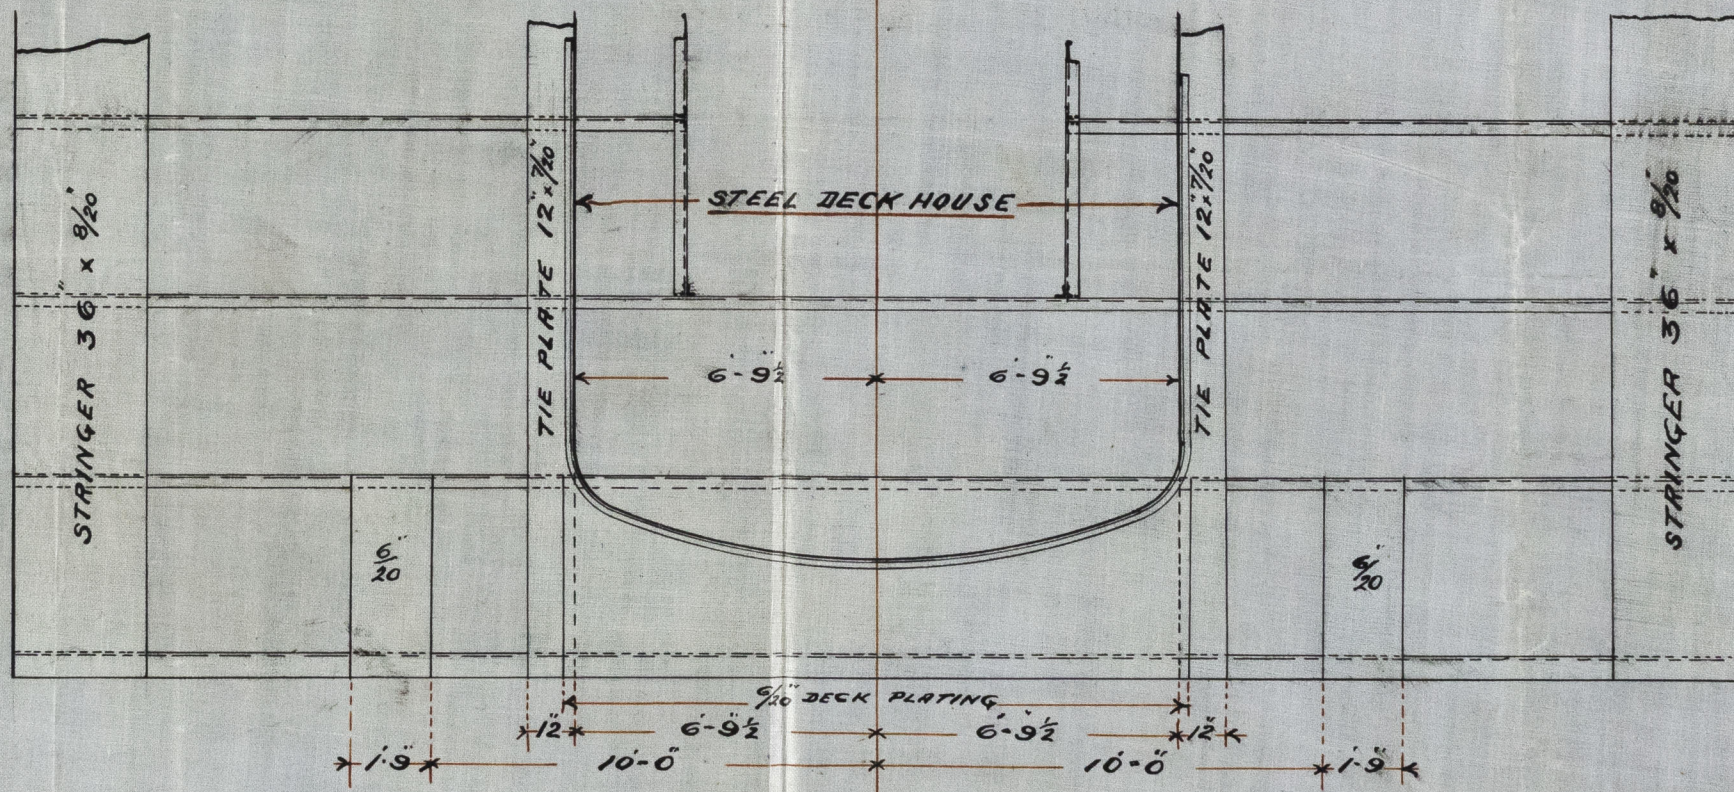

PLAN OF DECK PLATING IN WAY OF BRIDGE FRONT.

BRIDGE DECK.