

Shanghai
Hague Registry of Shipping
London
17. 22. 12. 93

S/S "Glen Mackay"
Bris Rept. No. 6311.
S.S. Nos 227-3 & 9.
312'-0" x 40'-0" x 26'-2" MLD
BILGE AND BALLAST PIPING
SCALE 1/8" = ONE FOOT


502
MARITIME INSURANCE AND ARRIVALS
SHIPWRECK DEPARTMENT
23 NOV 94
BARRON-DE-PUNIER

copy of this plan sent to owners 9/1/94

Note: All hand pumps, sections and sounding pipes which are against bulkheads are to be carried up as close to bulkhead as possible, through horizontal stiffeners, and to be kept as close together as possible to make the pipe casing occupy as small a space, and to be as few as possible. Pipes which do not come against bulkheads are to be arranged as close to bulkheads as possible.
This note was put on plan sent to owners 9/1/94.


TONNAGE UNDER DECK = 2400
RISE OF FLOORS = 10"

BILGE PIPES COLOURED THUS
BALLAST
AIR & SOUNDING PIPES

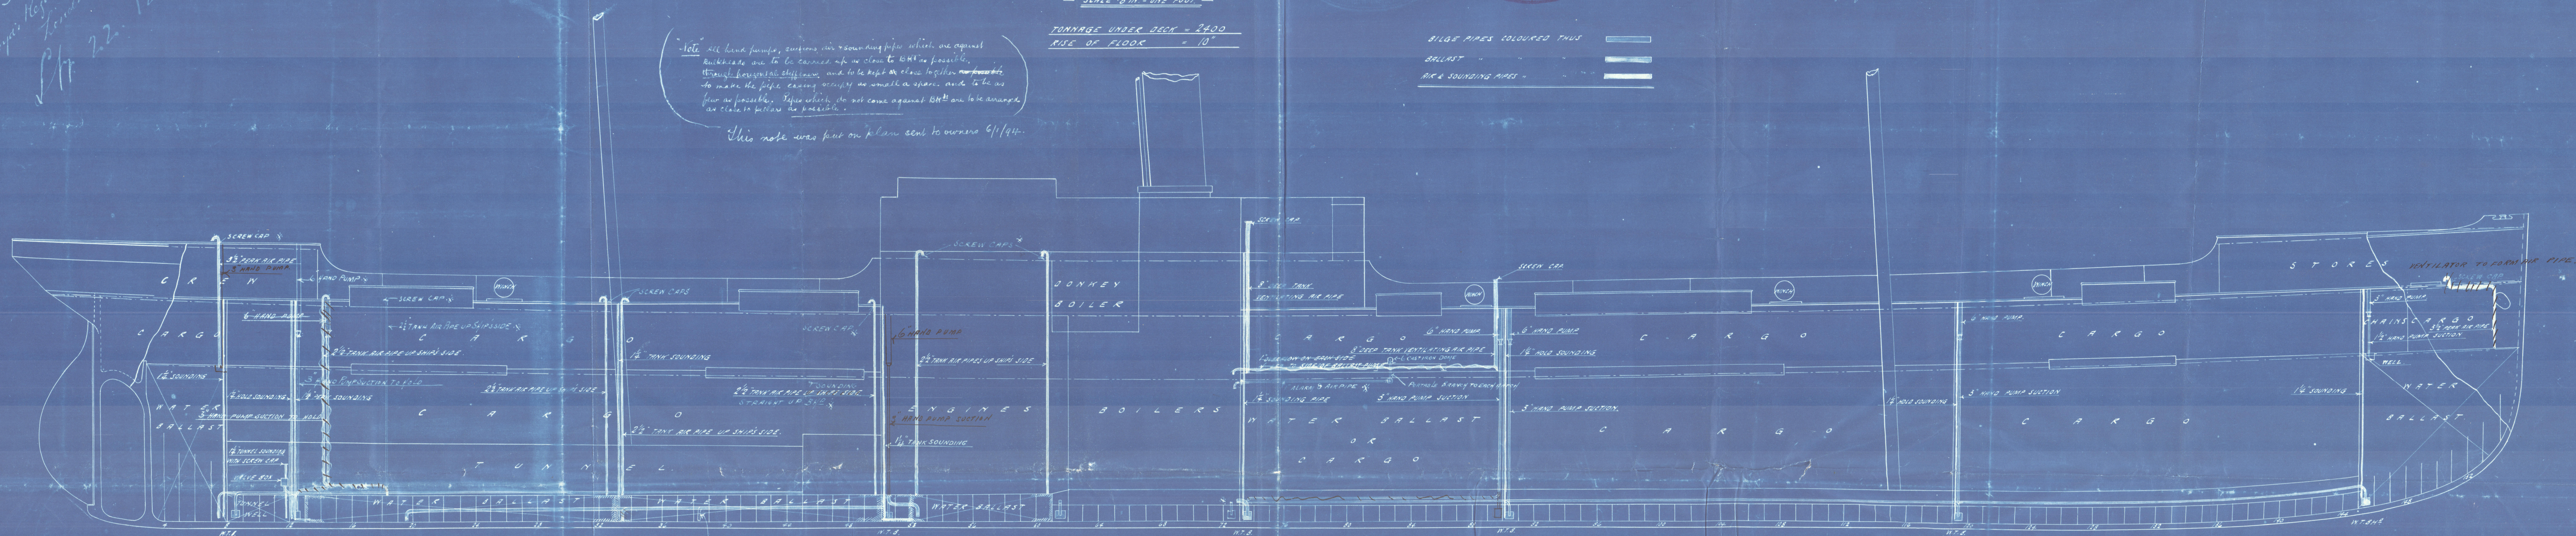

Section shown sloping
down on plan sent to owners 6/1/94

Hand pump sections shown on plan sent to owners 9/1/94
shown in blue

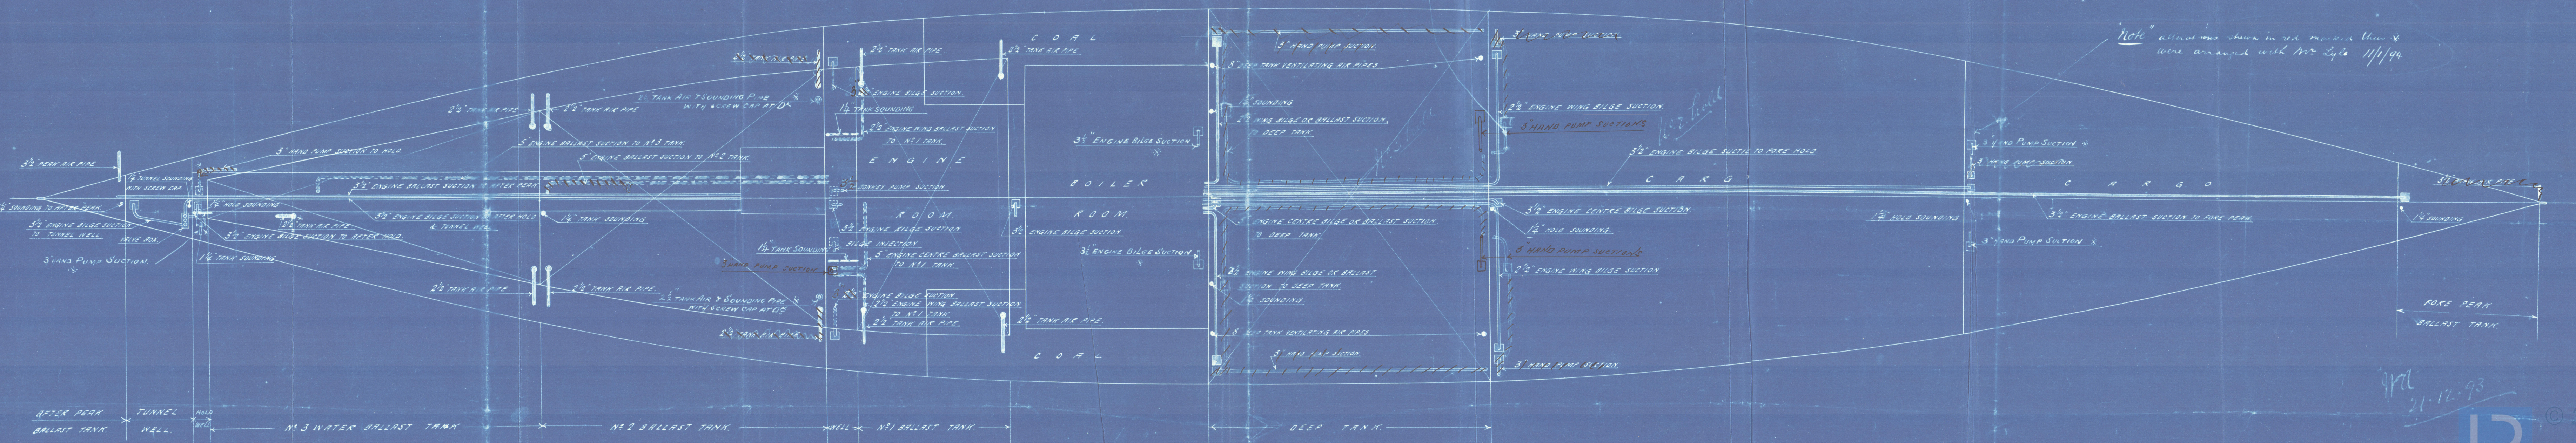

Note: all pipes shown in red plan were arranged with Mr. Lyle 1/1/94

17. 21. 12. 93

S.S. "Claw Mackay"
Brow. no. 631.



© 2020

Lloyd's Register
Foundation