



Received at

189

Lloyd's Register of British and Foreign Shipping.

(Report on Vessel No. _____ Port _____)

No. 4060 SHIP FORGINGS ~~OR CASTINGS~~

I have to report that the undermentioned Iron or Steel Forgings or Castings,
 manufactured by *The Portland Forge Coy*
 of *Kilmarnock* for the Vessel No. *101*, being built
 by *Messrs R Williamson & Co of Warrington*
 have been inspected by me as set forth below, and found to be, so far as can be seen,

Mark on Forgings.

Lloyd's

No. 4060
*W.H.**William Hamilton**Glasgow 3/10/93*

STERN FRAME.

RUDDER FRAME.

STEM.

Material* ...

How made ...


Dimensions ...

Progress on Inspection

Date when Inspected

*Scrap iron
Forged**7 1/2 to 4 1/2**Forging & smithing**12. 22. 30/6/93. 11. 29/8/93**19. 22/9/93. 2. 3/10/93*

SKETCHES OF FRAMES SHOWING POSITION AND DESCRIPTION OF WELDS OF FORGINGS, OR PARTICULARS OF
 TESTS APPLIED TO CASTINGS.

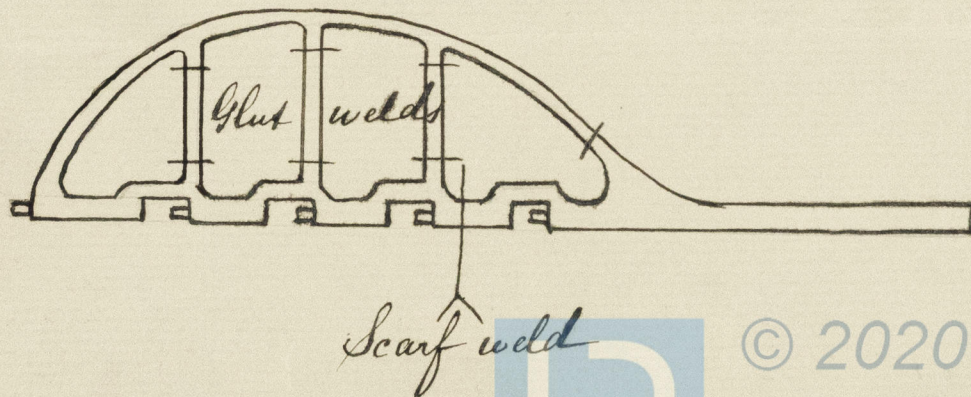

© 2020

Lloyd's Register
Foundation