

s/s "Clan Mackay"  
Brus Rept. No. 6311.


NOS 227-849.

312 B.P. x 400 x 26-2 MLD

MIDSHIP SECTION.


CLASS 100 A1 AT LLOYDS 3 DECK RULE STEEL.

SCALE 1/2 INCH = ONE FOOT.

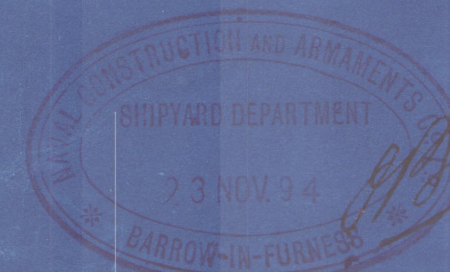

15245  
20/11/94

*Longitudinal Section  
30.11.93*

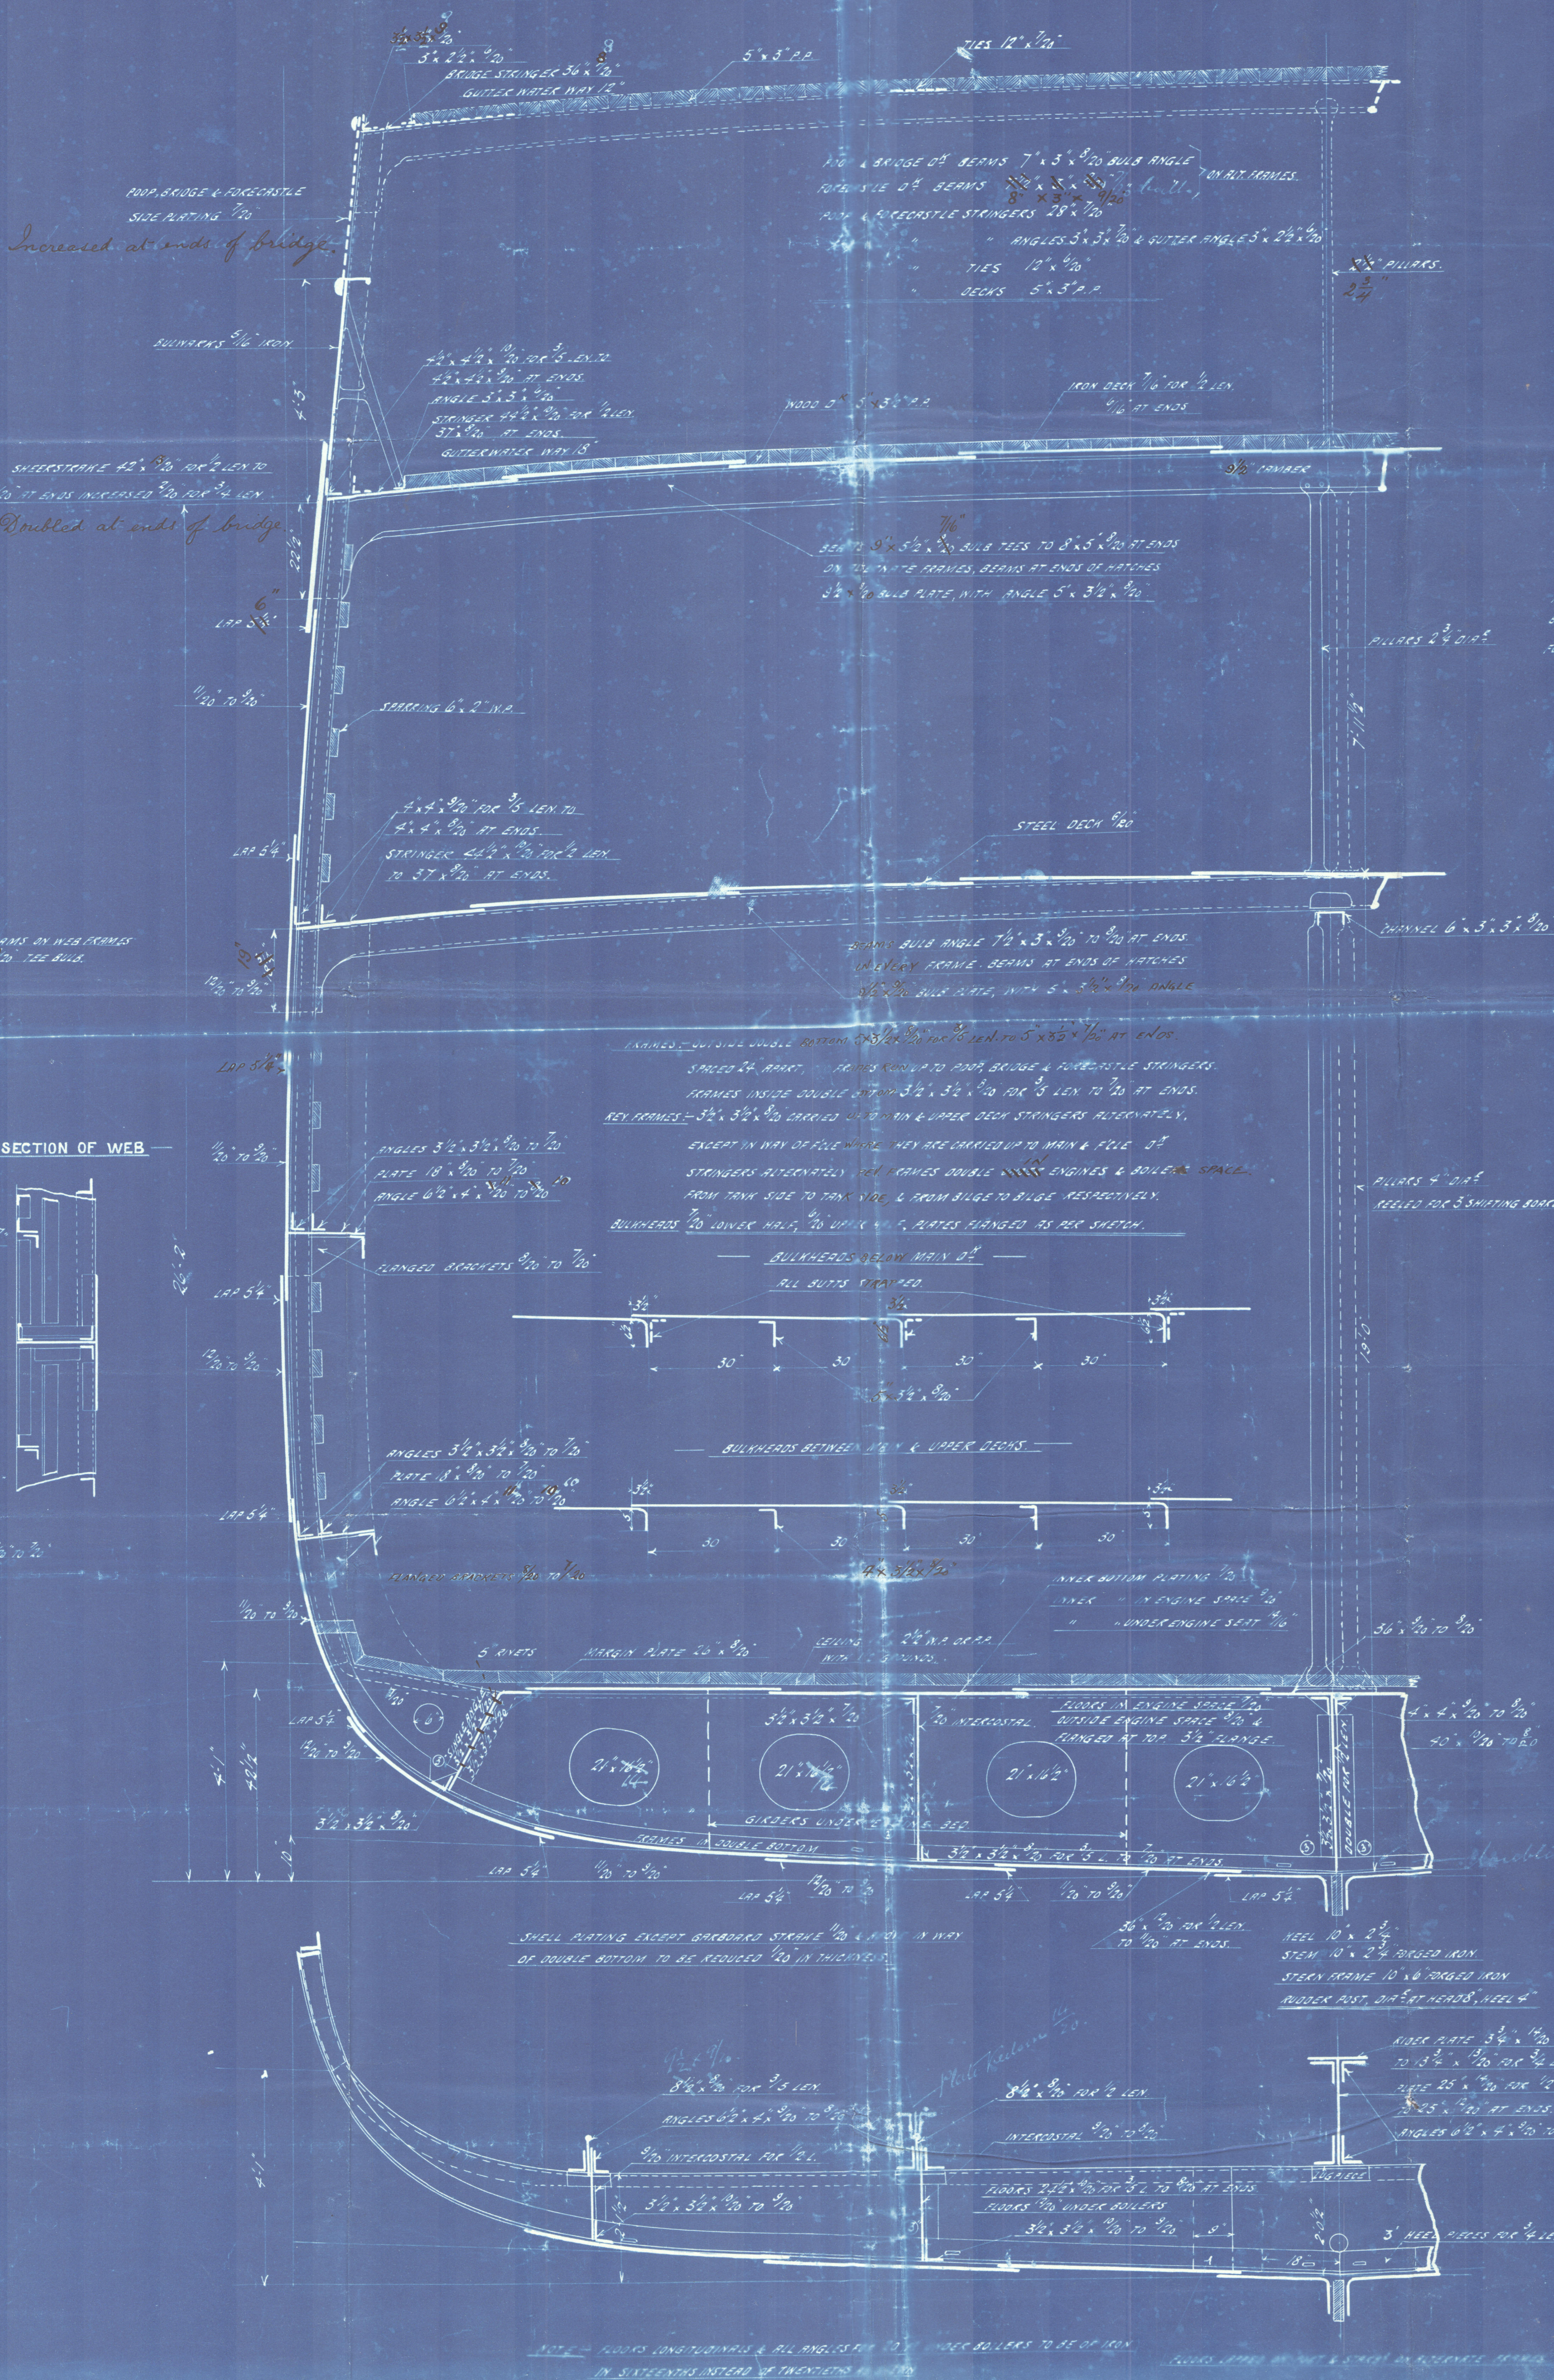

LLOYDS NUMERALS

1/2 GIRTH	42.87
1/2 BREADTH	20.00
DEPTH	26.86
	88.85
	7.00
1st NUMBER	82.83
2nd NUMBER	310.53
3rd NUMBER	25704.63

EQUIPMENT NUMBERS

310.53	7.70	SEAMS
410.53	11.81	SEAMS
510.53	16.80	SEAMS
610.53	21.79	SEAMS

EQUIPMENT

28' 0"	80.83 x 310.53	= 27876.84
31' 0"	127.8	
38' 0"	310.53 x 3484.6	= 1435.0
107' 8"		28311.84

EQUIPMENT

1 BOW ANCHOR	34 INT. EX. STOCK
1	32 1/2
1	30 1/2
1 STREAM	10 1/2
1 KEEG	5 1/2
240 FATHOMS 1 1/2" STUD CHAIN CABLE	
75 FATHOMS 1 1/2" STREAM CABLE	
30	6" STEEL WIRE TONING
30	3" HANGER
30	2 1/2" HANGER

**RIVETING**

UPPER ST. STRINGER BUTTS, TREBLE RIV. FOR 1/2 LEN. & DOUBLE RIV. AT ENDS, TO HAVE DOUBLE STOPS FOR 1/2 LEN. REMAINDER SINGLE STOPS TO THICKER THAN PLATES THEY CONNECT. MAIN ST. STRINGER BUTTS, LAPPED & TREBLE RIV. FOR 1/2 LEN. & DOUBLE RIV. AT ENDS.

UPPER & MAIN ST. PLATING BUTTS, LAPPED & DOUBLE RIV. FOR 1/2 LEN. & SINGLE RIV. AT ENDS.

UPPER & MAIN ST. PLATING SEAMS, SINGLE RIV. ALL AFT. & AFT. SHEER STOPS & GABBOARD STOPS, TREBLE RIV. FOR 1/2 LEN. & DOUBLE RIV. AT ENDS, STOPS TO THICKER THAN PLATES THEY CONNECT. REMAINDER OF STOPS TO THICKER THAN PLATES THEY CONNECT.

REMAINDER OF SHELL BUTTS, FROM GABBOARD STOPS TO STOPS BELOW SHEER STOPS, WITHIN 1/2" LAPPED & QUADRUPLE RIV. WHERE OUTSIDE & INSIDE STOPS EXCEED 40" & 40" WIDE RESPECTIVELY, REMAINDER LAPPED & TREBLE RIV.

PODS, BRIDGE & FLE. SIDE PLATING & STRINGER BUTTS, LAPPED & DOUBLE RIV. CENTRE PLATING & UPPER PLATE BUTTS, LAPPED & TREBLE RIV.

TANK TOP PLATING, BUTTS & SEAMS OF MIDDLE LINE STOPS TO BE DOUBLE RIV. ALL AFT. & AFT. REMAINDER OF TANK TOP PLATING SEAMS, SINGLE RIV. BUTTS, DOUBLE RIV. FOR 1/2 LEN. & SINGLE RIV. AT ENDS.

TANK SIDE BUTTS, LAPPED & DOUBLE RIV. ALL AFT. & AFT.

*Location of Stems of Hull Plating  
to be in accordance with the Rules*



Bh. "Iranian"  
Barrow. 643.



© 2020

Lloyd's Register  
Foundation