

Bow Pk. No 679.
13 1/2 "Willy Reckman's"
DECK PLAN


Bru
19/1/93
R.S.

LOTOS REGISTER OF SHIPPING
HAGUE
20 JAN. 93
LONDON


LONGITUDINAL SECTION & DECK PLAN

SHIP N° 65

Scale $\frac{1}{8}$ inch = 1 foot

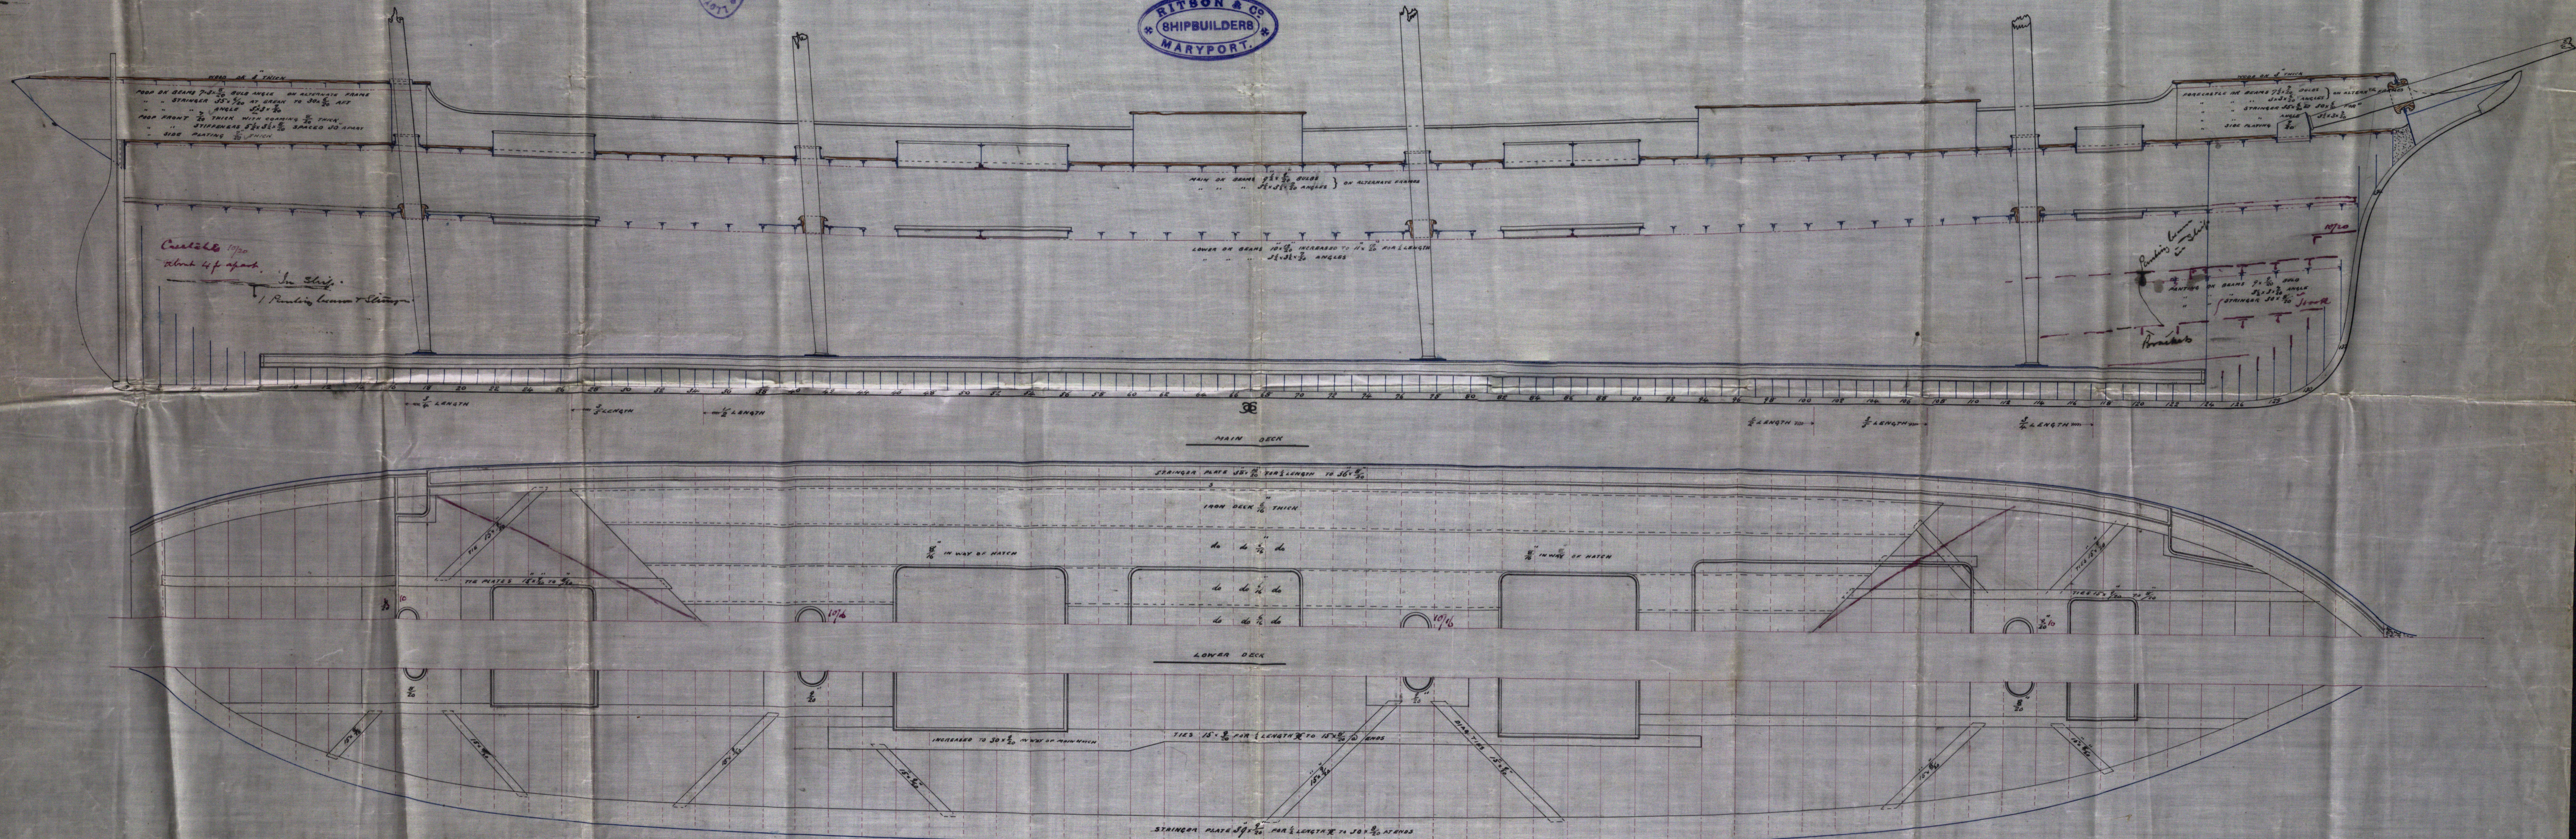

'Willy Rickmers'
Row. 649.

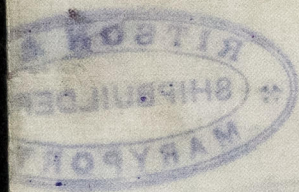

EP. 1. 25
EP. 3. 18

© 2020



Lloyd's Register
Foundation