

BRW 44-0087
26/11/93
11.9

27.7.93.
31.8.93.


RECEIVED
27 JUL 93
LONDON

LOWER PORTION OF MIDSHIP SECTION

SHEWING PROPOSED ALTERATIONS TO UPPER BILGE & SIDE STRINGERS

SHIP N° 65

Scale $\frac{1}{2}$ Inch = 1 FOOT

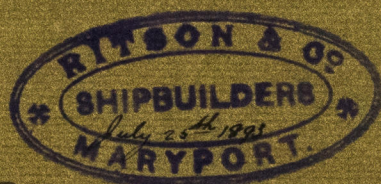

Brw. Rpt. N° 679.
Bk. "Nilly" Richardson's

BULB PLATE $13 \times \frac{10}{20}$ TO $\frac{8}{20}$
SCORED OVER FRAME 3×4
CONNECTED TO $5 \frac{1}{2} \times 3 \frac{1}{2} \times \frac{20}{20}$ TO $\frac{8}{20}$
with 3" lap
INTERCOSTAL ANGLES
ANGLES $6 \times 4 \times \frac{20}{20}$ TO $\frac{8}{20}$ ENDS
10"

until incorporated with the
next length of
BULB PLATE $13 \times \frac{10}{20}$ TO $\frac{8}{20}$ FOR
CONNECTED TO $5 \frac{1}{2} \times 3 \frac{1}{2} \times \frac{20}{20}$ TO $\frac{8}{20}$
with 3" lap
AFT OF $\frac{3}{4}$ LENGTH
10" $\times \frac{10}{20}$ TO $\frac{8}{20}$ TO FRAMES ONLY
ANGLES $6 \times 4 \times \frac{20}{20}$ TO $\frac{8}{20}$
SCORED 3" OVER FRAMES
INTERCOSTAL ANGLES
10"



© 2020

Lloyd's Register
Foundation

BRW44-0087