


19.8.95

Copy.


Brw Ppl. 719.
S/S "Clem Lindsay"

Brw
16/8/95
98.9

— S.S.N. 246 —
— STEEL SCREW STEAMER —
— TO CLASS 100 A.1 AT LLOYDS 3 DK RULE —
— SCALE 1/8" = 1 FOOT —
— AMENDED ARRANGEMENT OF BRIDGE DECK HOUSES —

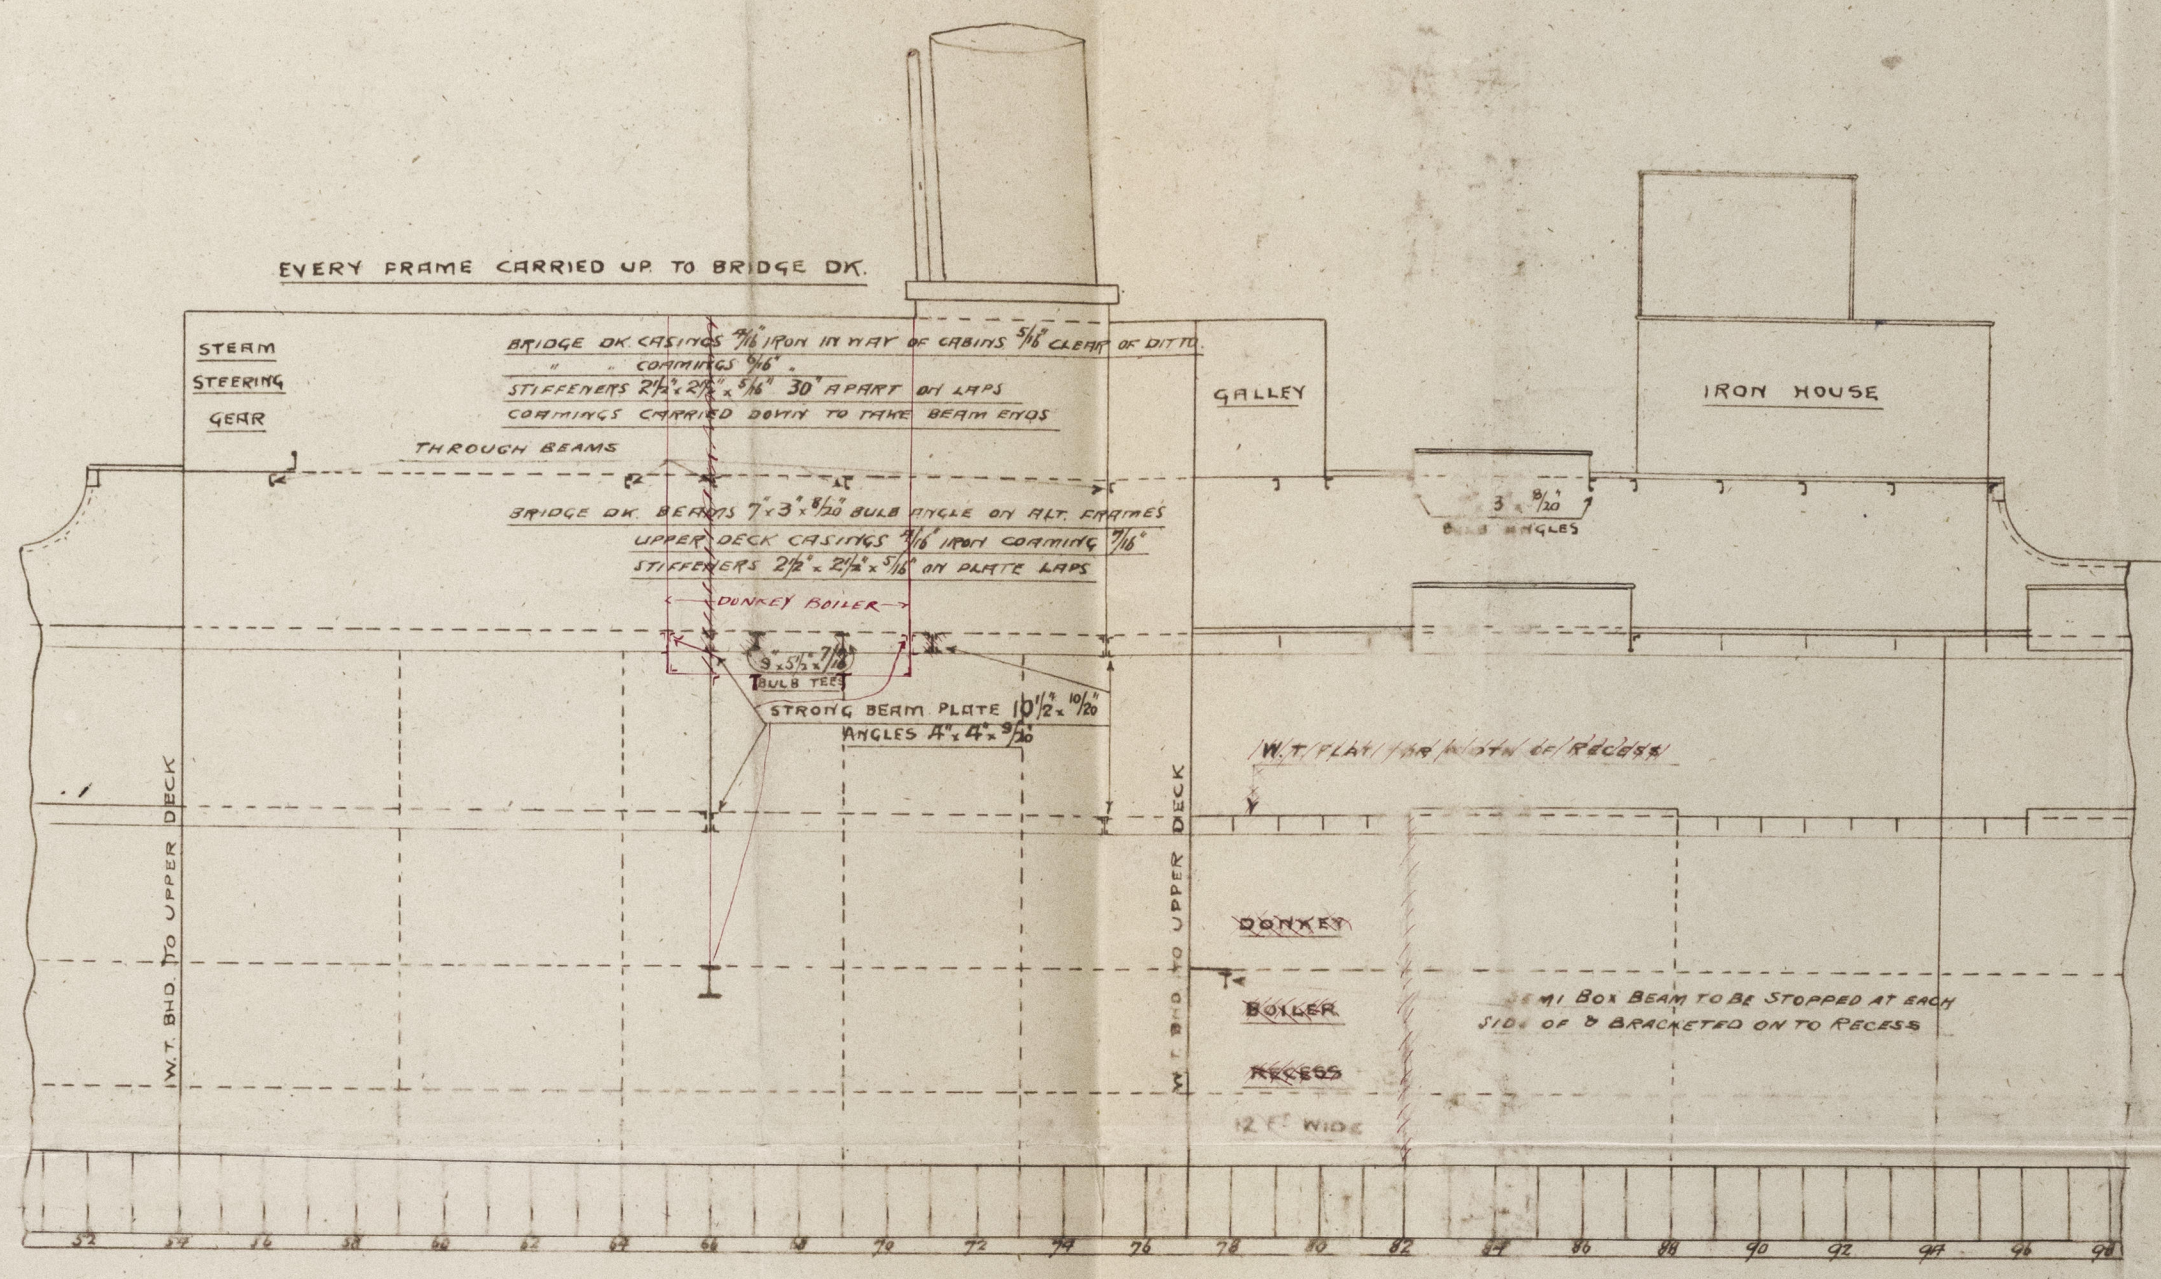

— BRIDGE DECK —

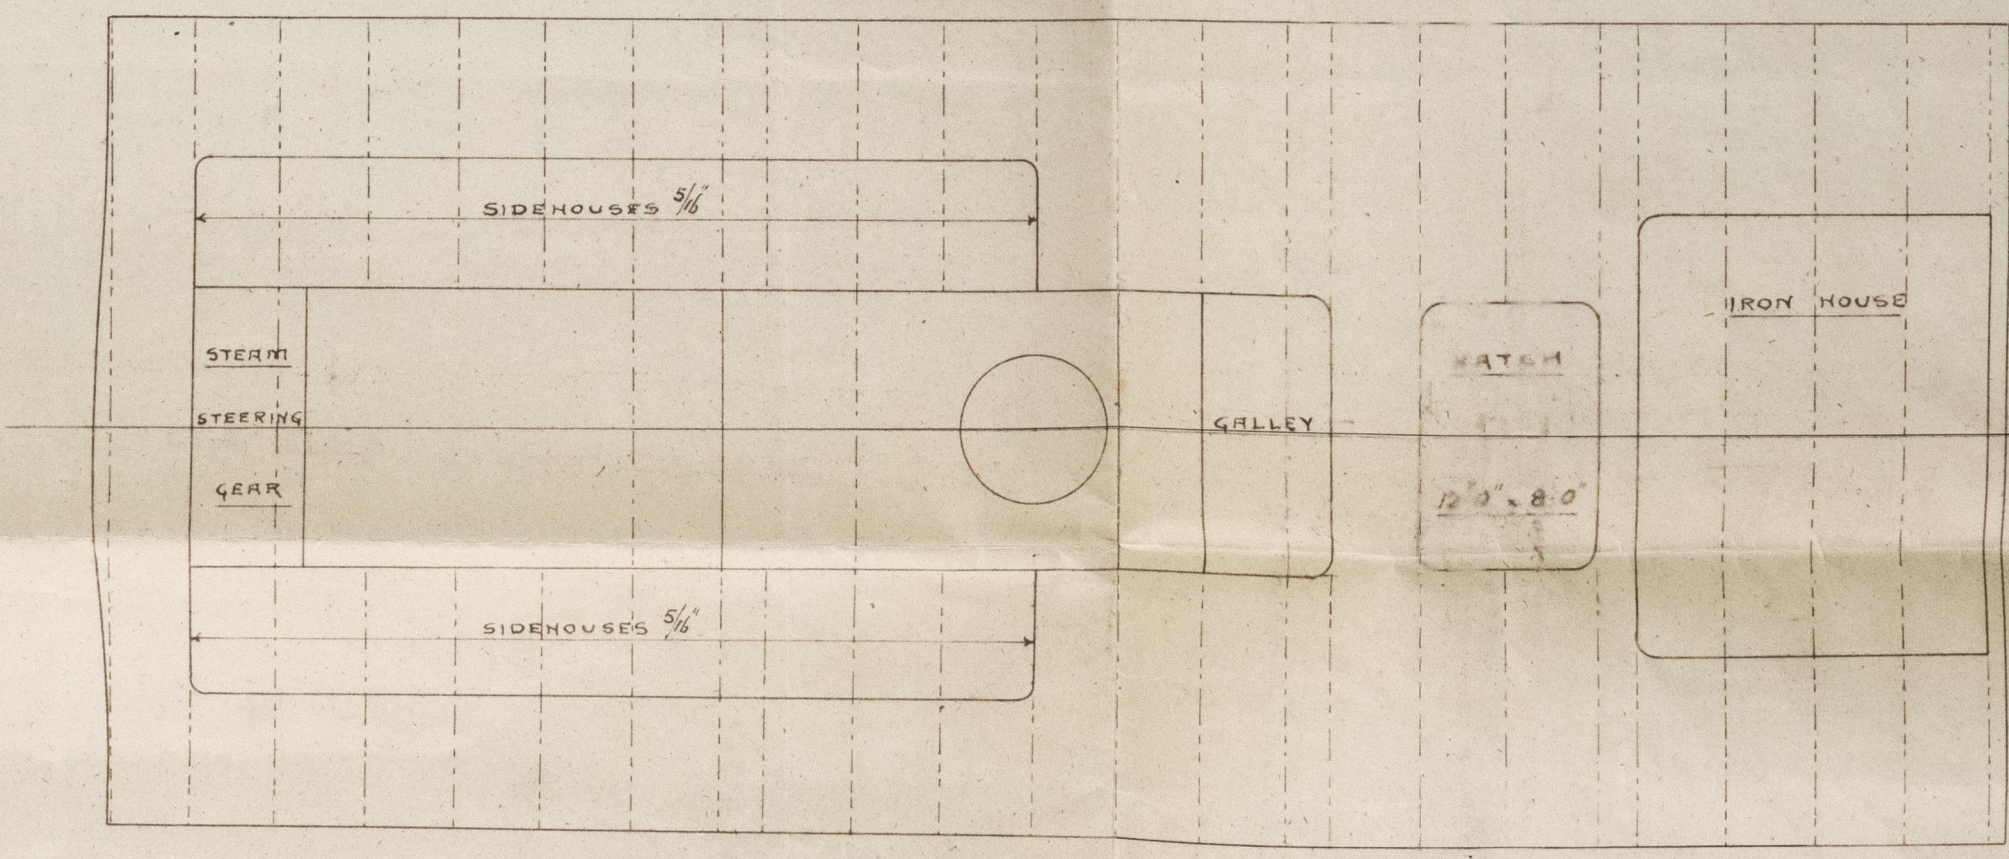

Styl
19/8/95



© 2020
Lloyd's Register
Foundation

BRW 44-0162