

(Stamp)
 Lloyd's Register
 of Shipping
 London
 23. 7. 95
 1. 8. 95

S. S. N° 246




STEEL SCREW STEAMER

To Class 100 A1. At Lloyd's 30th Rule

SCALE 1/8" = ONE FOOT

Copy. Draw No. 119

S/S *Clan Lindsay*

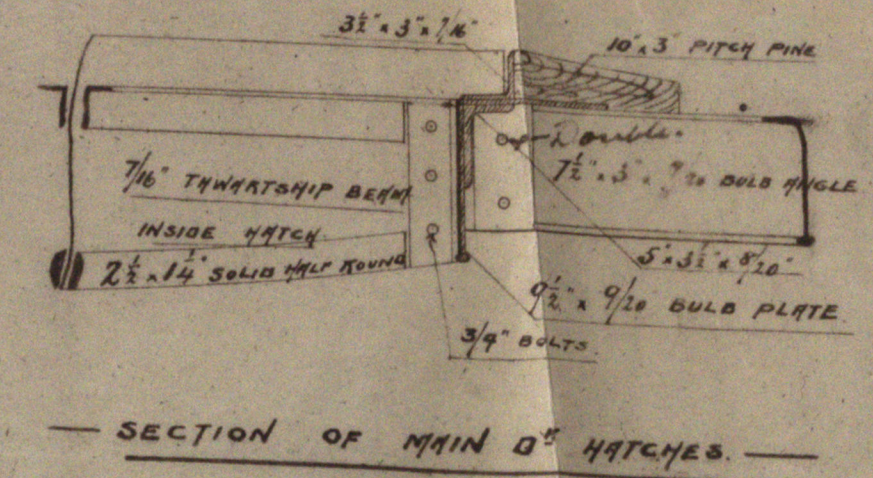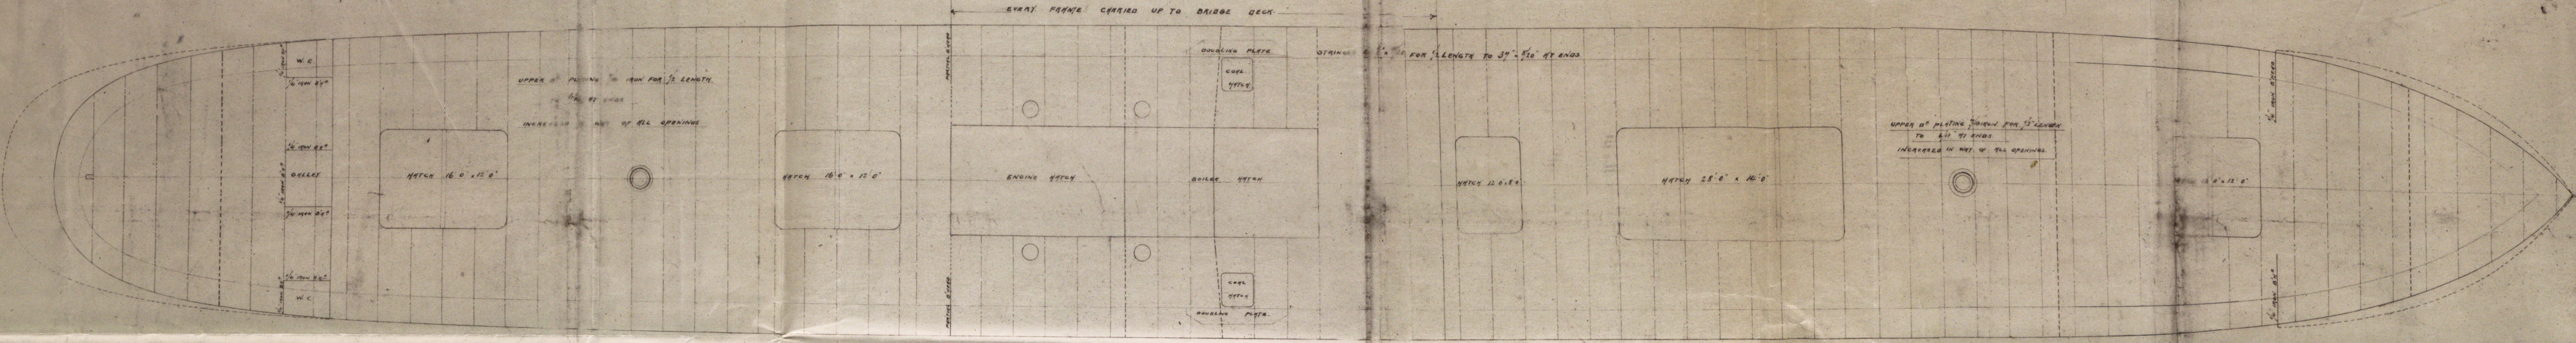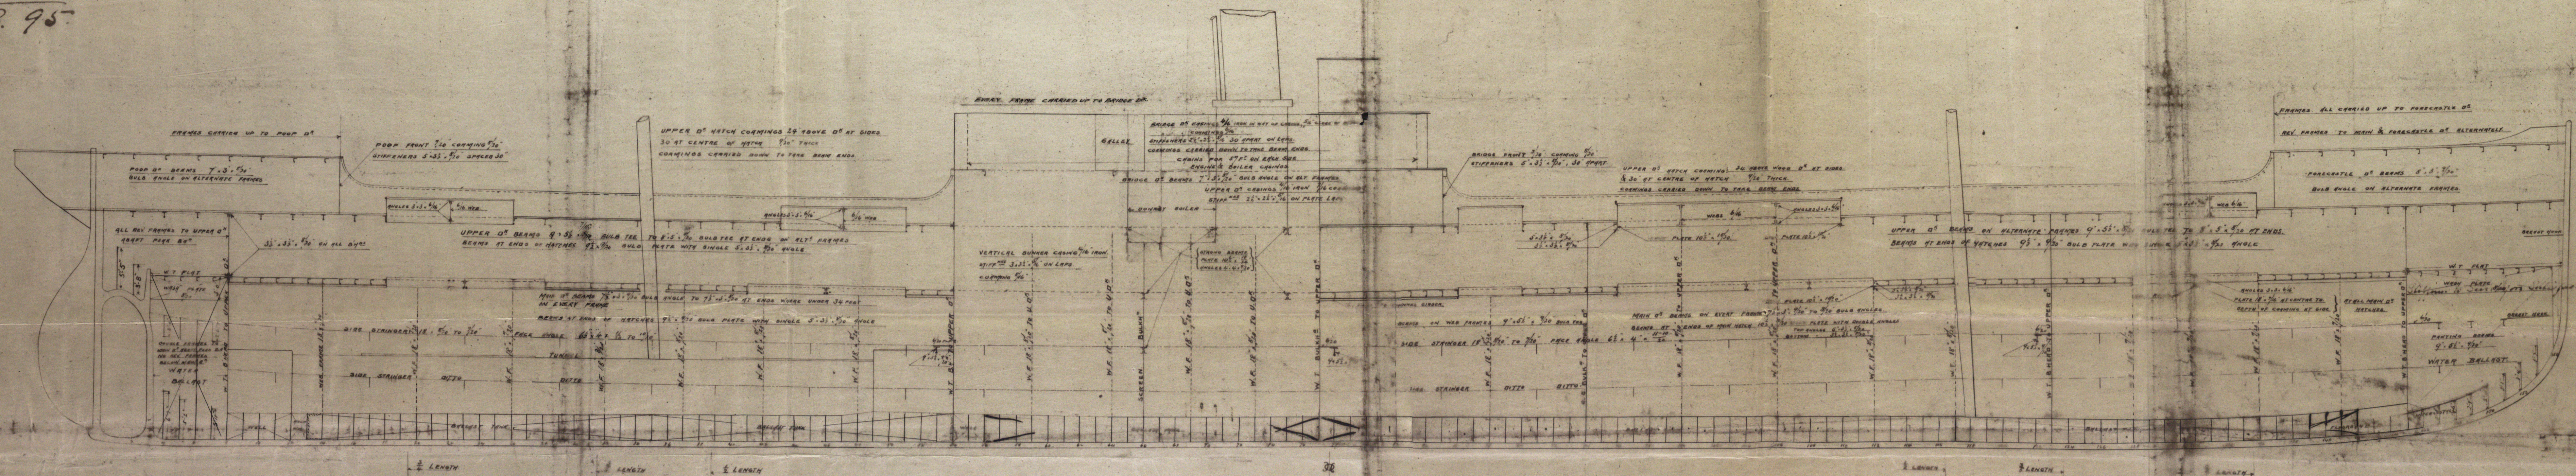

476
 2/8/95

Handwritten notes and signatures in the right margin, including a date '20/8/95' and a signature.

BRW44-0162