

19.8.95

Copy

Nº 246

Brw Rpt. N. 719.
S/S "Clan Kindra"

Brw.
16/8/95
N.S.


MIDSHIP SECTION

CLASS 100 A.1 AT LLOYDS 3 DECK RULE STEEL

DIMENSIONS 312'-0" x 40'-0" x 26'-2" MOULDED

SCALE 1/2" INCH = ONE FOOT

AMENDED ARRANGEMENT OF BRIDGE DECK HOUSES

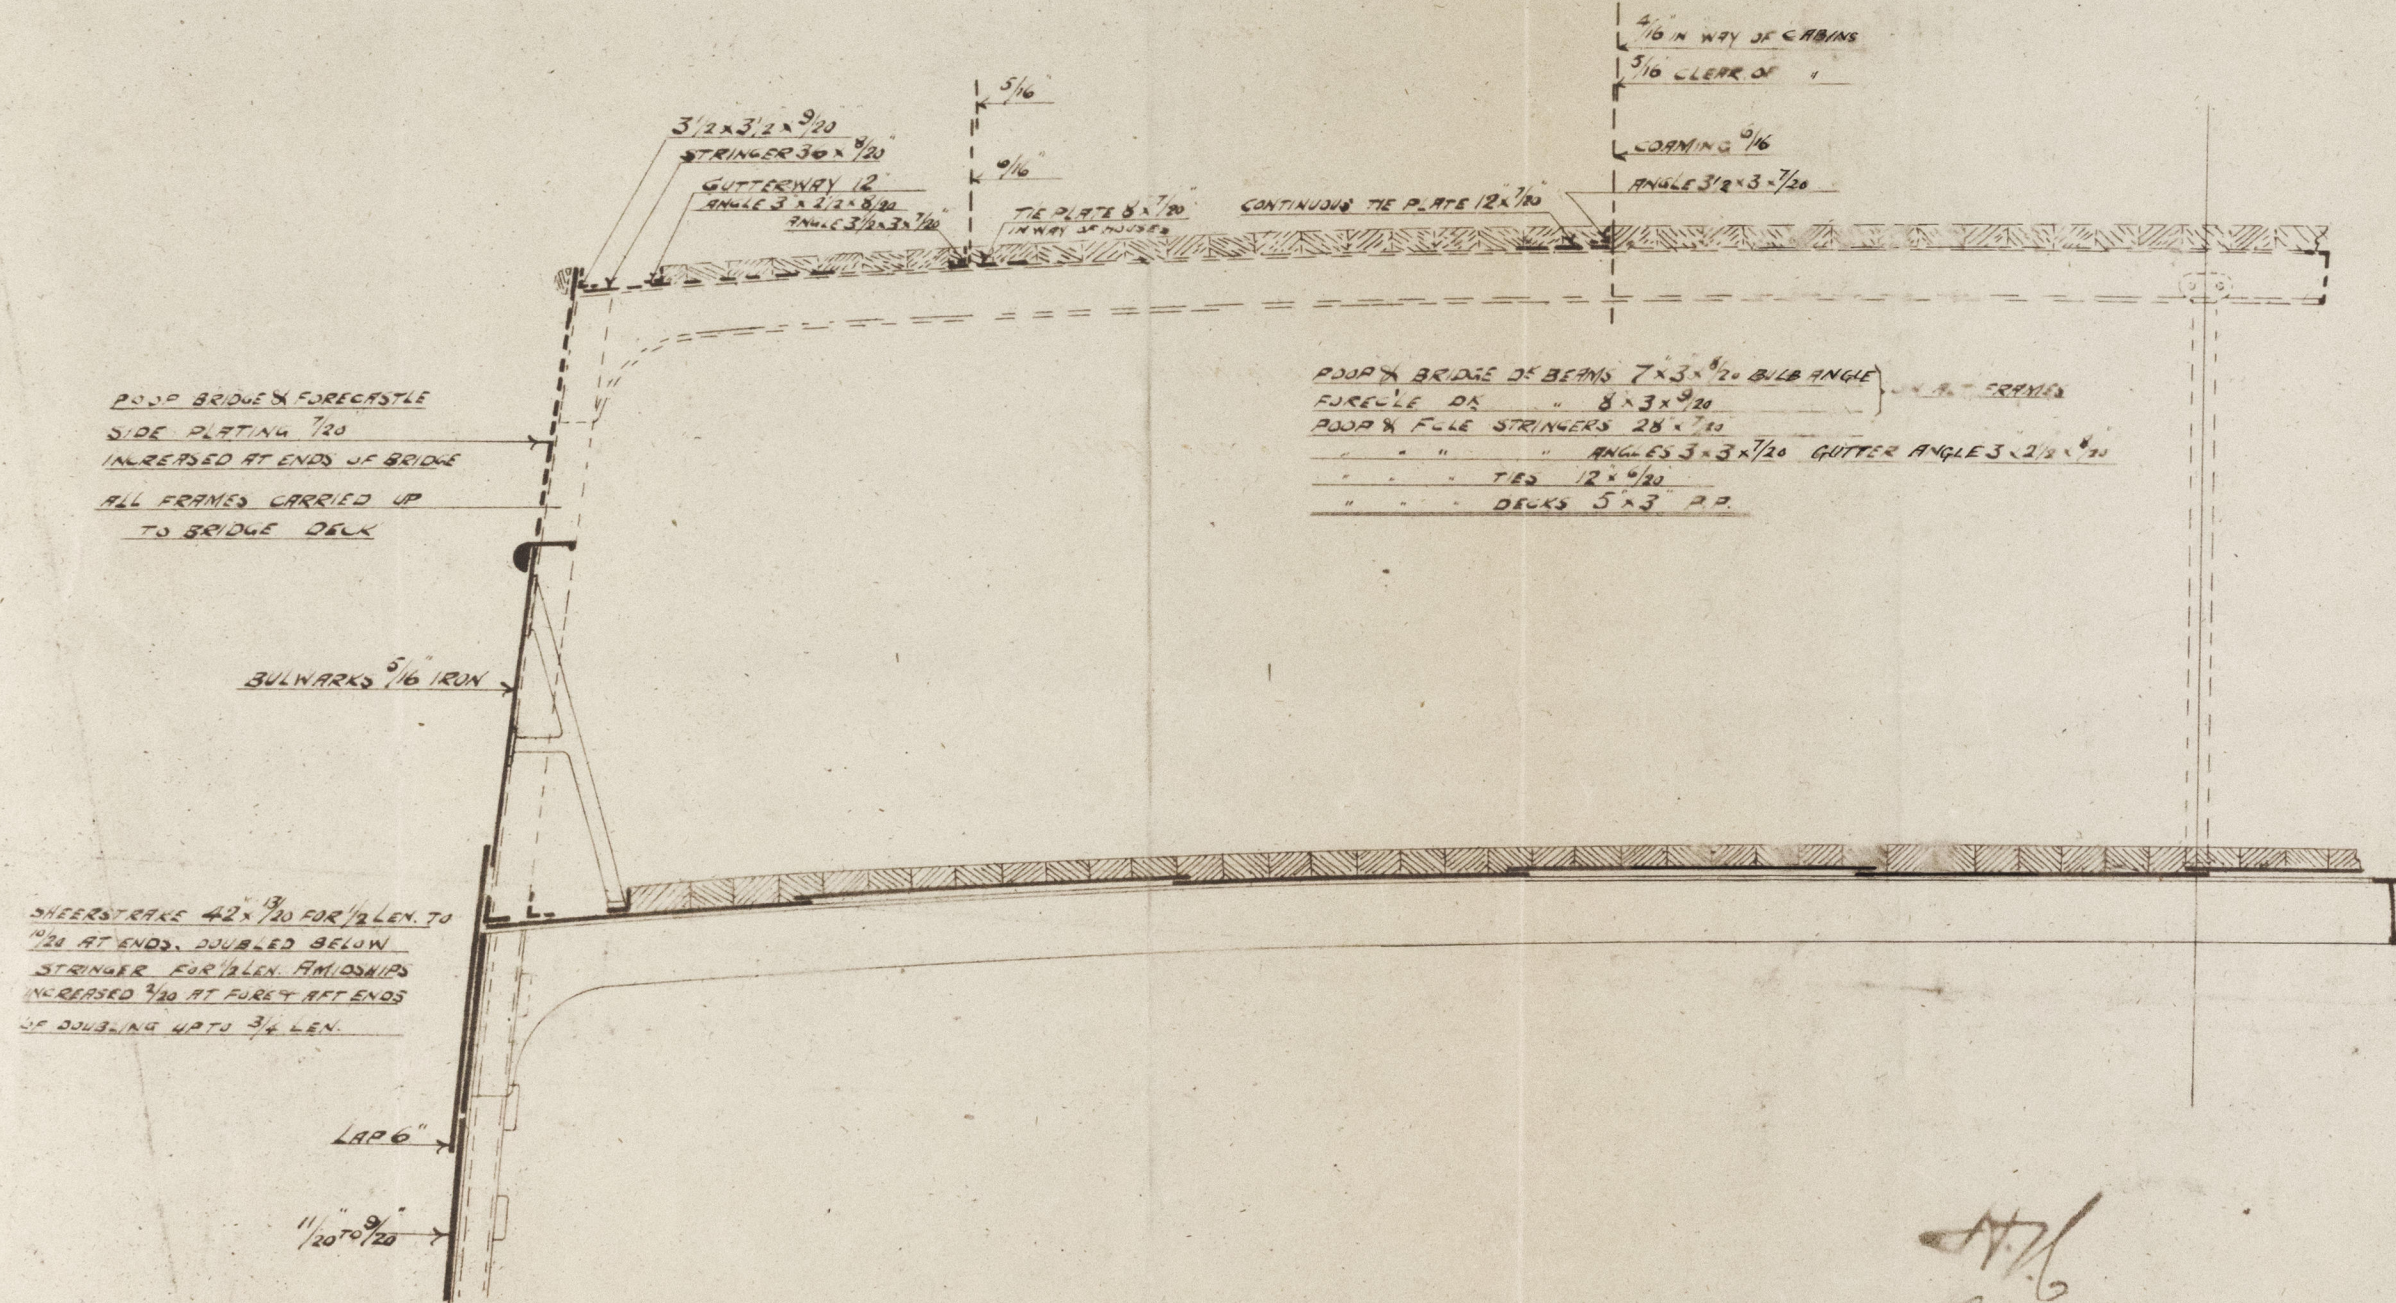

LLOYDS' NUMBERS

1/2 GIRTH	42.87
1/2 BREADTH	20.00
DEPTH	26.96
	89.83
LESS 7.00	
1 ST NUMBER	82.83
	310.33
2 ND NUMBER	25704.63

310.33	=	7.76 BEAMS
40		
310.33	=	11.51 DEPTHS TO UPPER DECK
26.96		
310.33	=	16.33 " " MAIN DECK
19.00		

EQUIPMENT NUMBERS

POOP	30.0	89.83 x 310.33 =	27876.94
BRIDGE	86.0	152.0	
FORECASTLE	30.0	310.33 x 3484.6 =	1707.45
	152.0		29584.39