

(Stamp)
Lloyd's Register
of Shipping
London.

23. 7. 95
1. 8. 95

No 246.

Buo Pph. N. 719.
S.S. "Clan Laidlaw"


Bray
10/17/95
11/1/95

MIDSHIP SECTION.

CLASS 100 AI AT LLOYDS 3 DECK RULE STEEL.

DIMENSIONS 32' 0" x 40'-0" x 26'-2" MOULDED

1/2 INCH = ONE FOOT

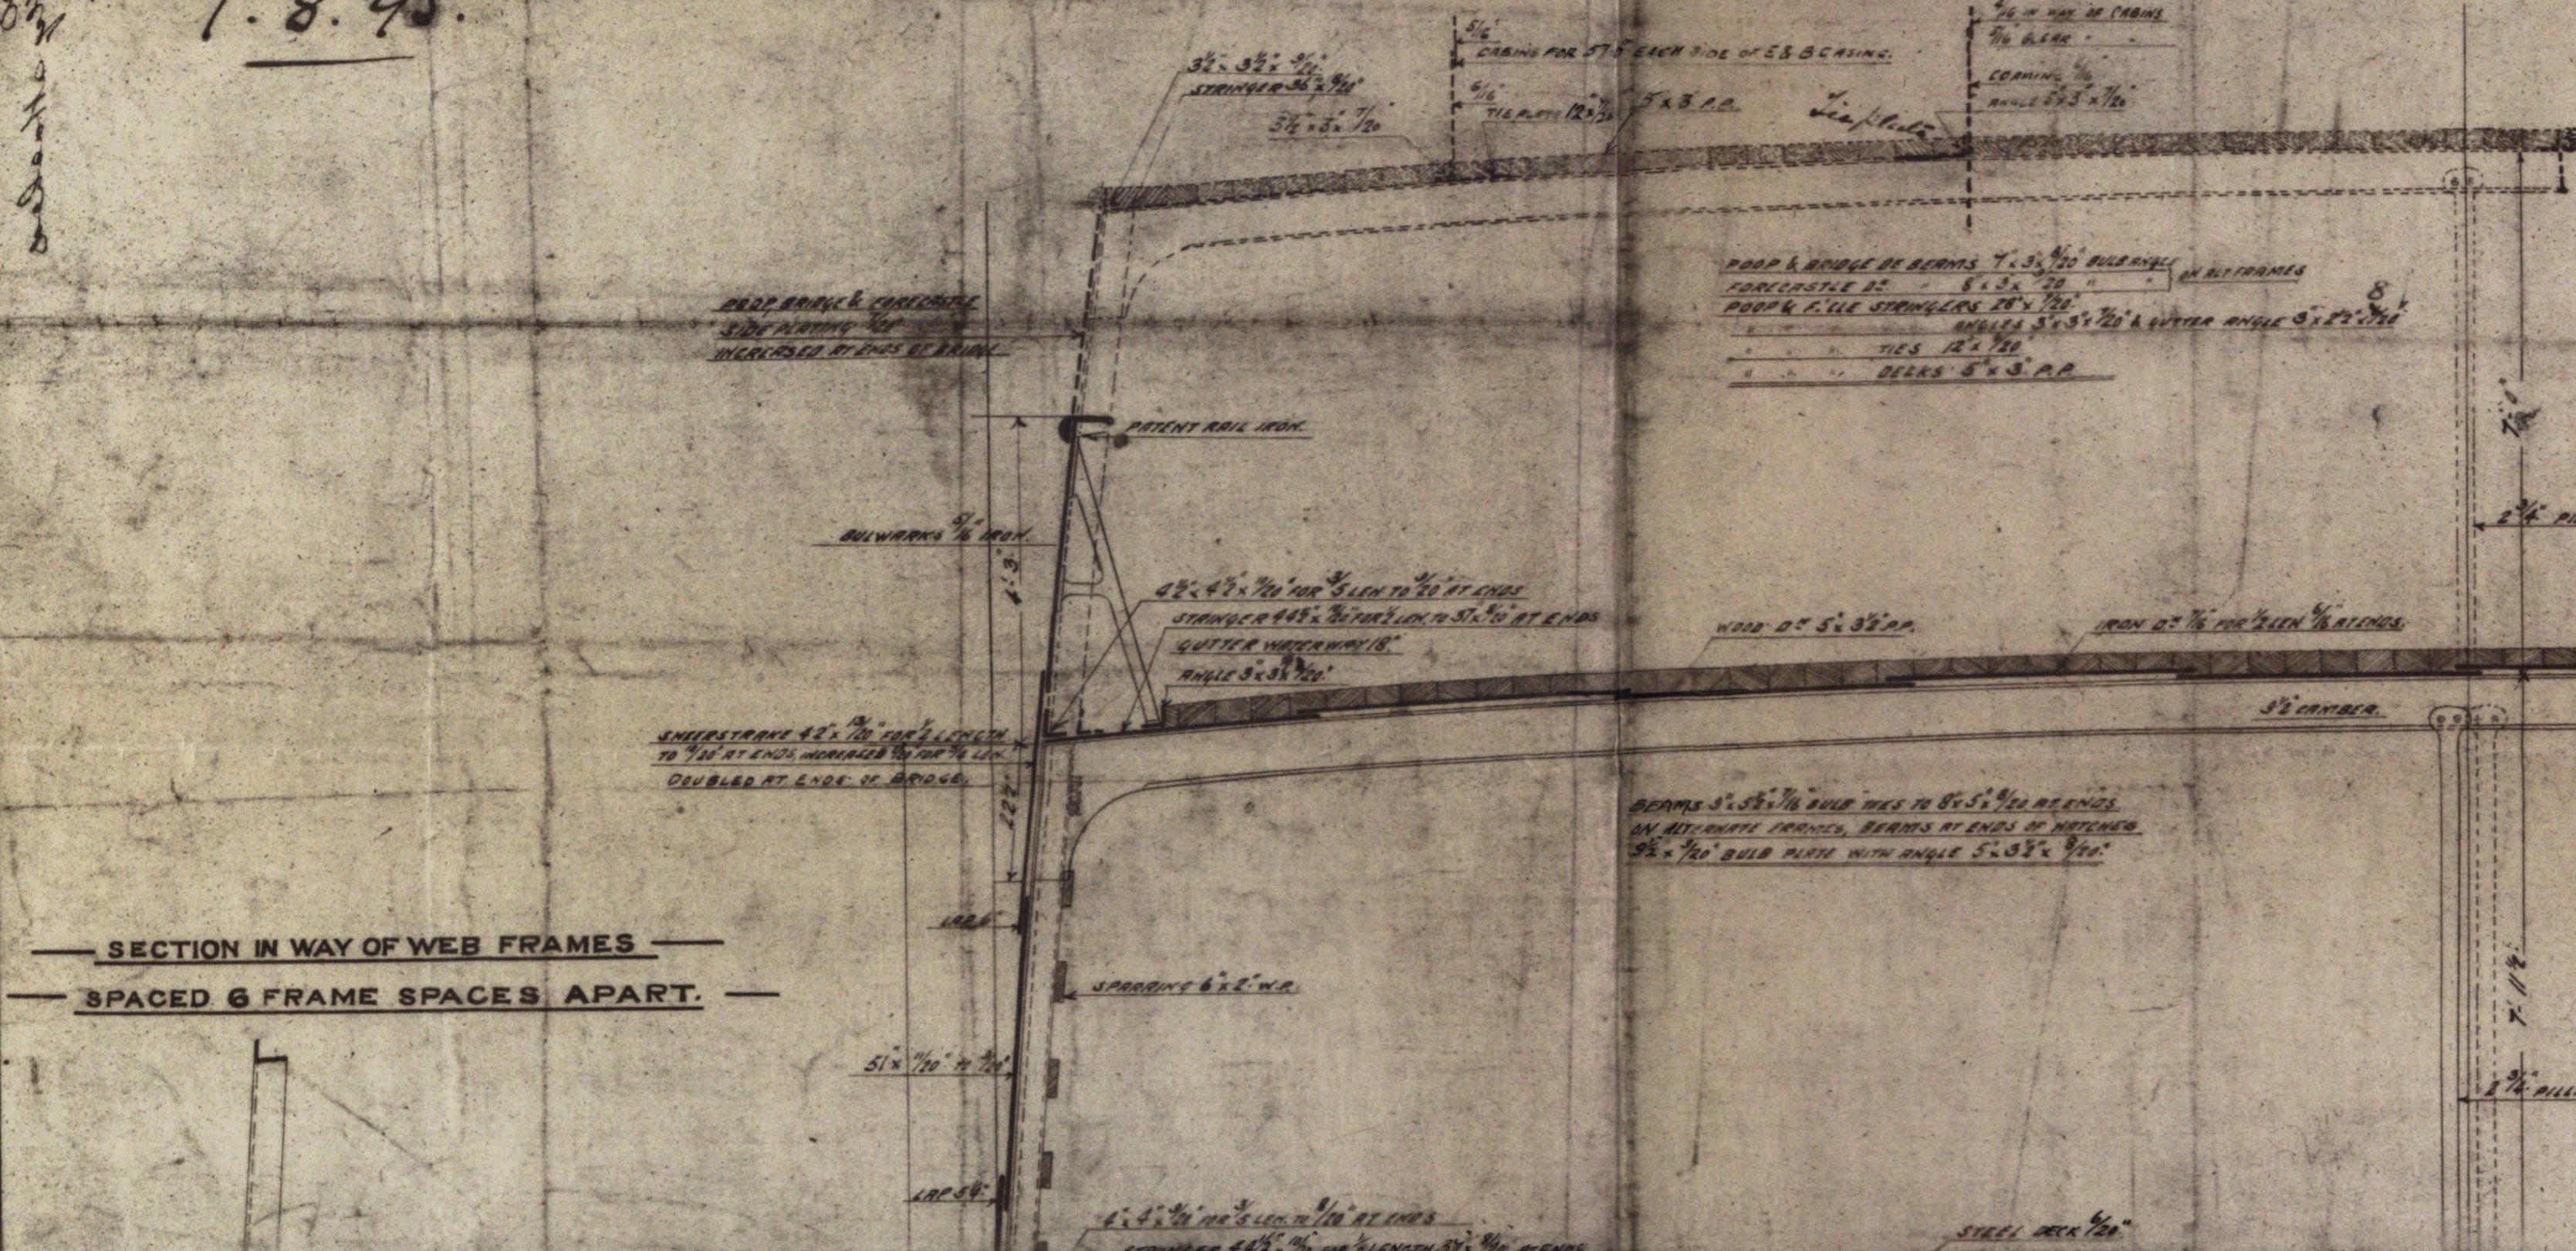


LLOYD'S NUMBERS	
1. GIRTH	62-87
2. BREADTH	20-00
DEPTH	14-46
3. DRAUGHT	8-83
4. T.S.	7-10
5. CARGO	8-11
6. DECKS	31-38
7. NUMBER	26744-63

3/0 83	= 775 SCARFS
3/0 83	= 11.51 SCARFS TO 1000 FT
3/0 83	= 14-33, 1. MARCH 96

EQUIPMENT NUMBERS	
BOAT	30-0
BRIDGE	61-8
COLECAVE	36-0
DOCK	27-5

EQUIPMENT	
1."	32 1/2 "
1."	30 1/2 "
STEAM	10 1/2 "
1."	8 1/2 "
1."	6 1/2 "

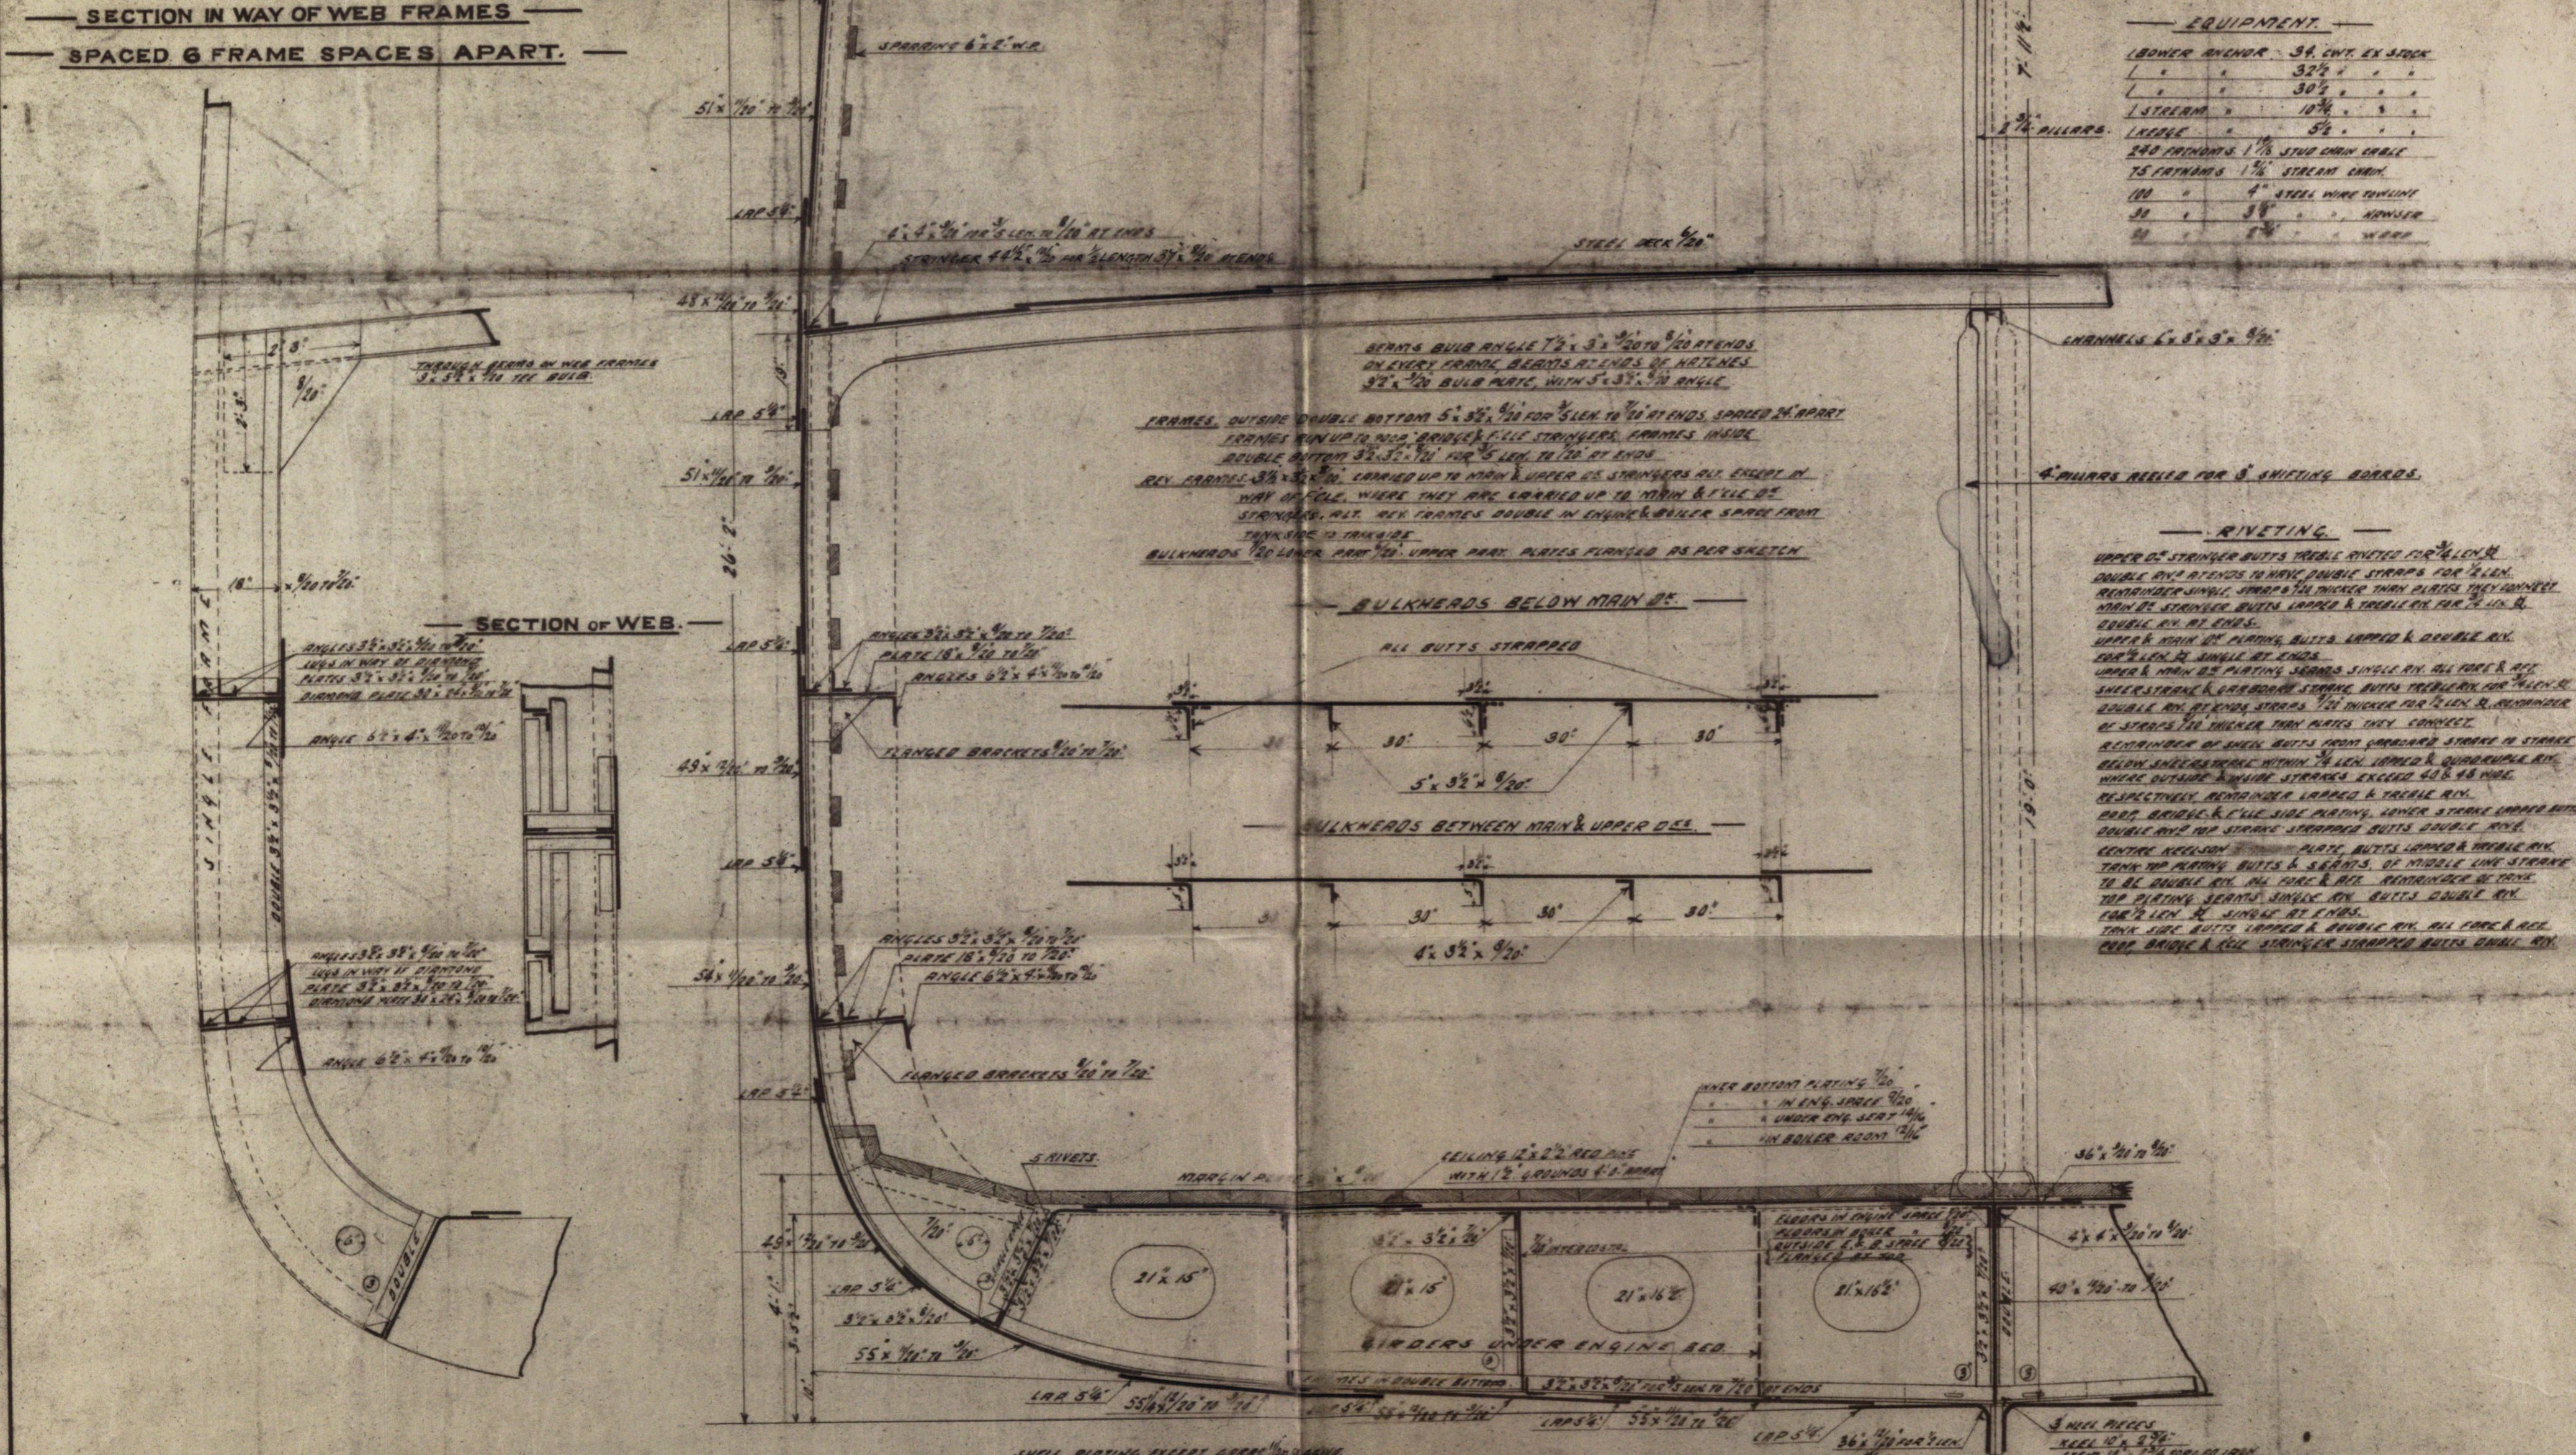

RIVETING.




TWO 1/2 INCH PLATES, BUTTS, ANGLES & REINFORCED RIB,

UPPER DECK A 1/2 INCH STRONGER STRAPPED BUTTS, REINFORCED RIB.


BRW44-0164

12/20

Lloyd's Register
Foundation