


October 12/97

— MIDSHIP SECTION S S N<sup>o</sup> III — *S/S Lodes' Brw Rpt. No 803*

SCALE  $\frac{1 \text{ IN}}{2} = 1 \text{ FOOT}$

—TO CLASS 100A1 AT LLOYDS—

— LENGTH 152'-3" BREADTH 23'-6" DEPTH MLD. 11'-3" —

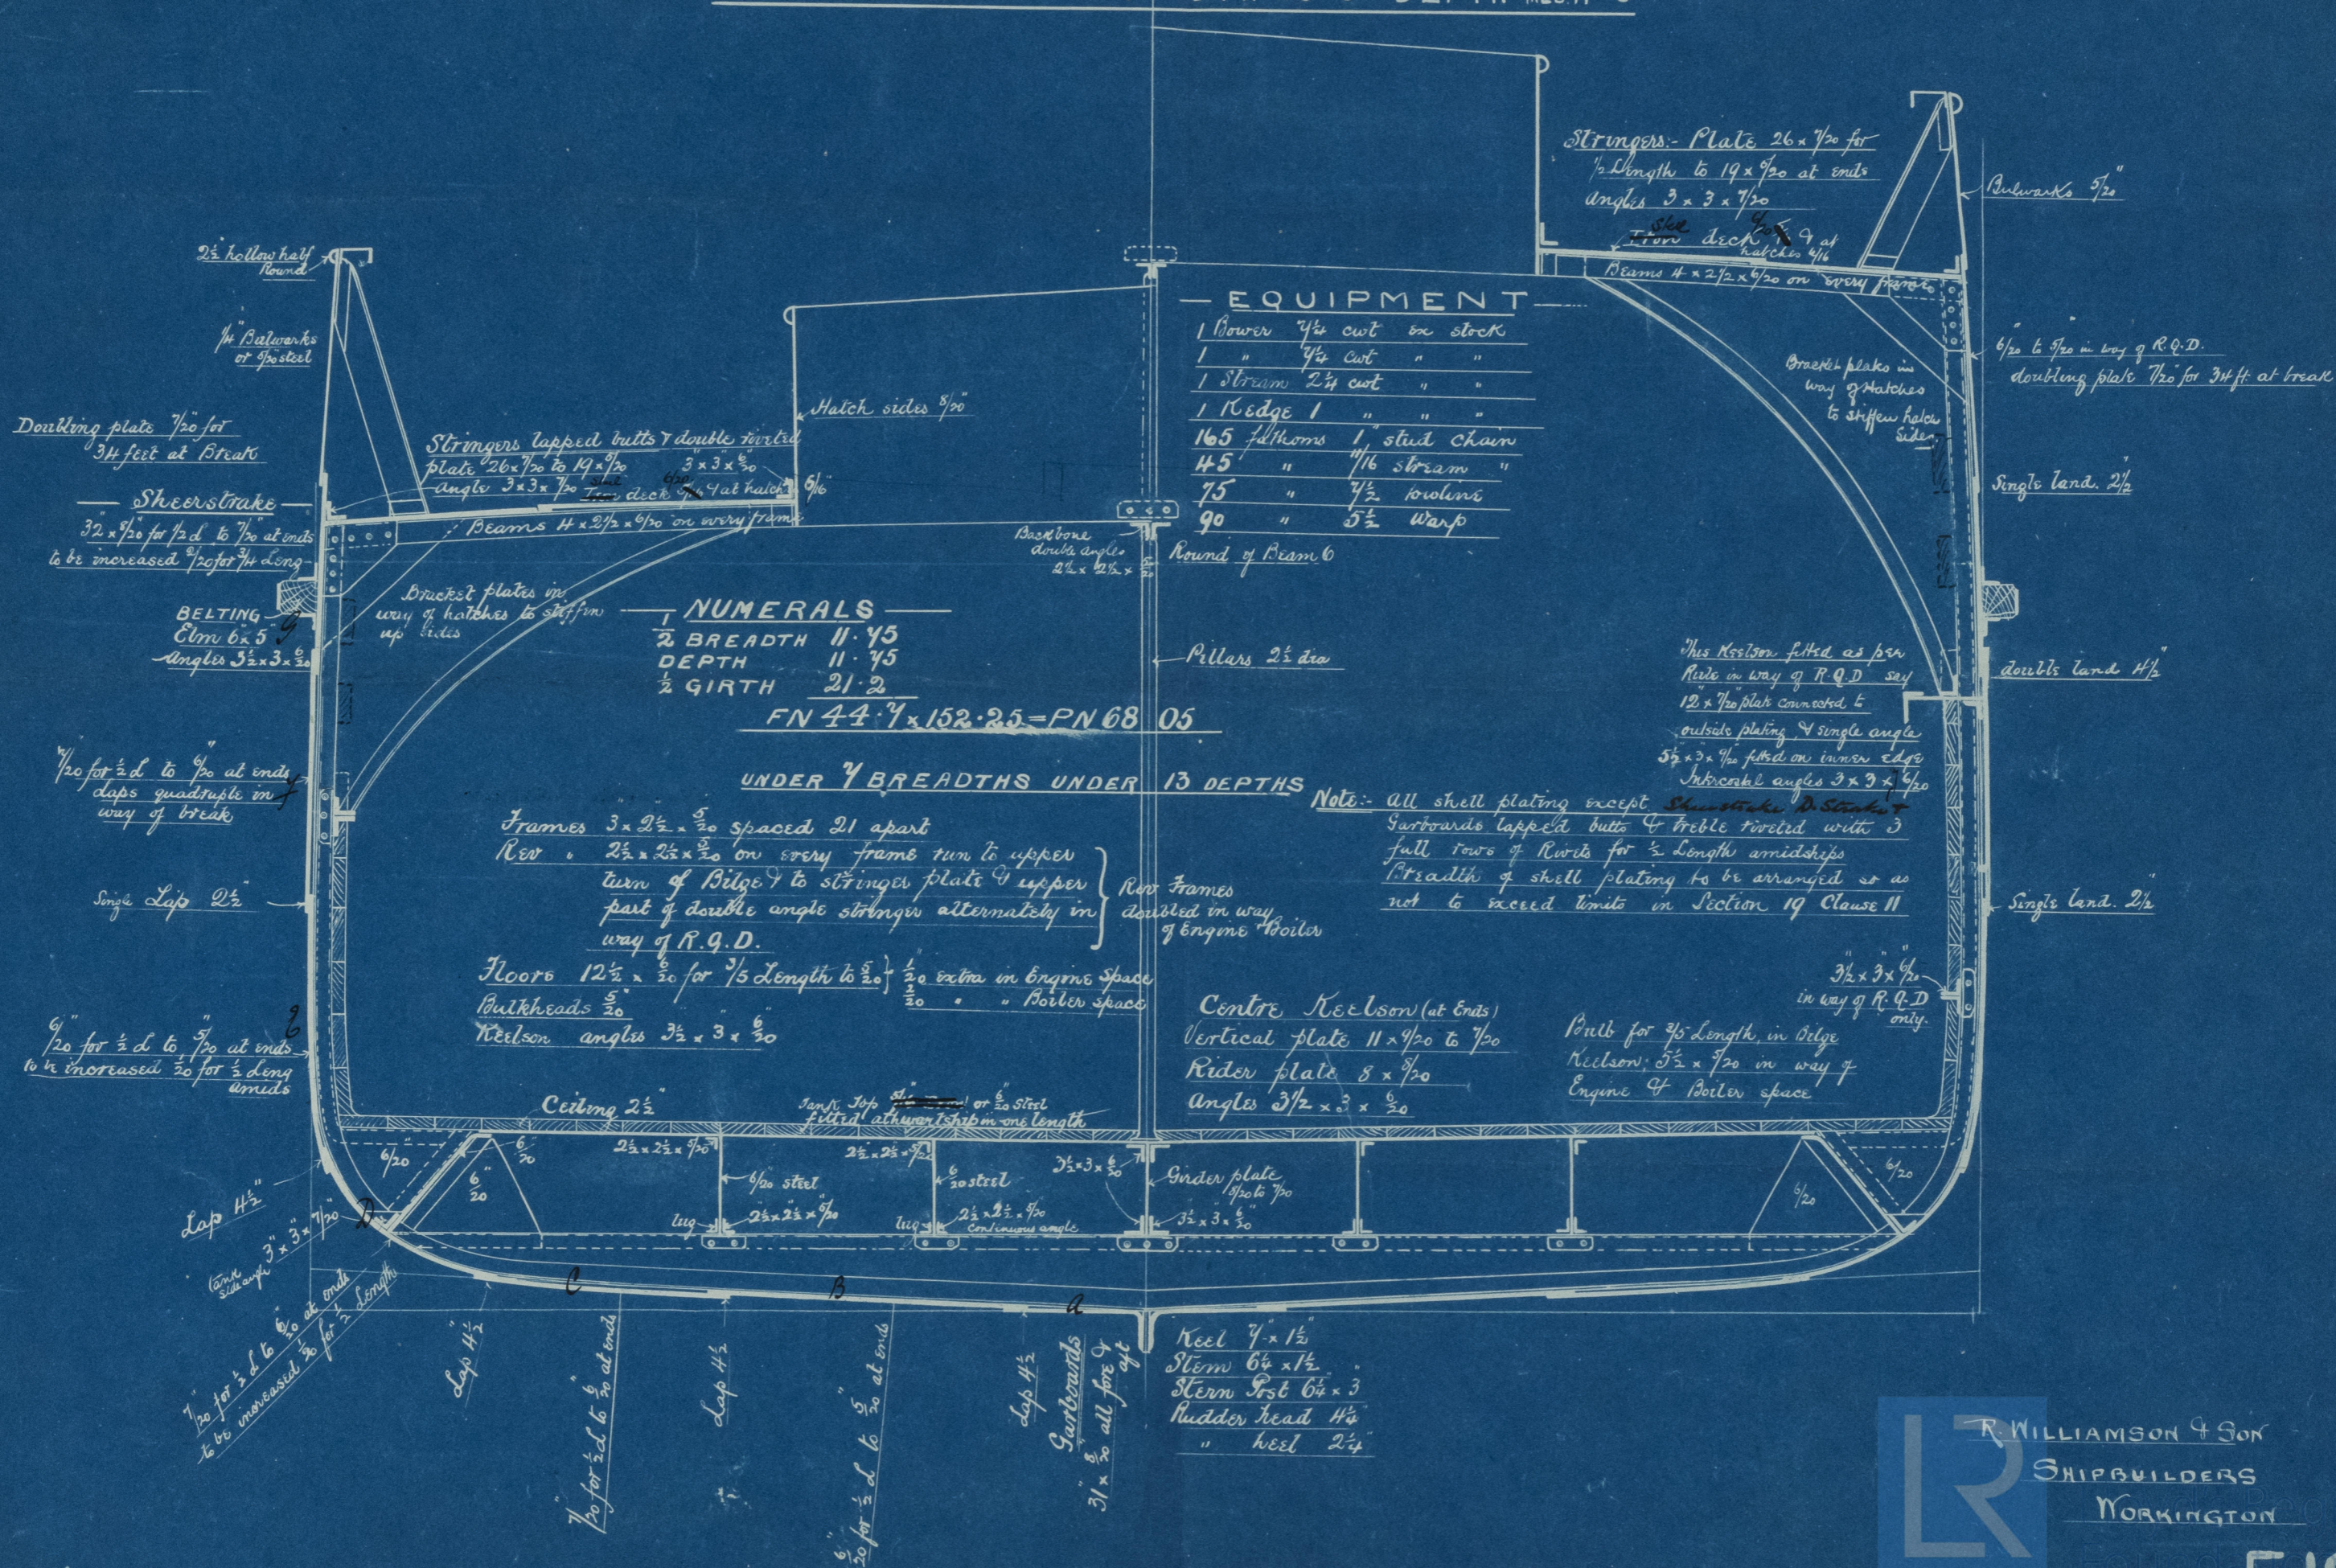

**R. WILLIAMSON & SON**  
**SHIPBUILDERS**  
**WORKINGTON**

E19

Middle Section  
S/S Codes

Brw Rpt. No 803

BRW 45-0089.1

© 2021

Lloyd's Register  
Foundation