
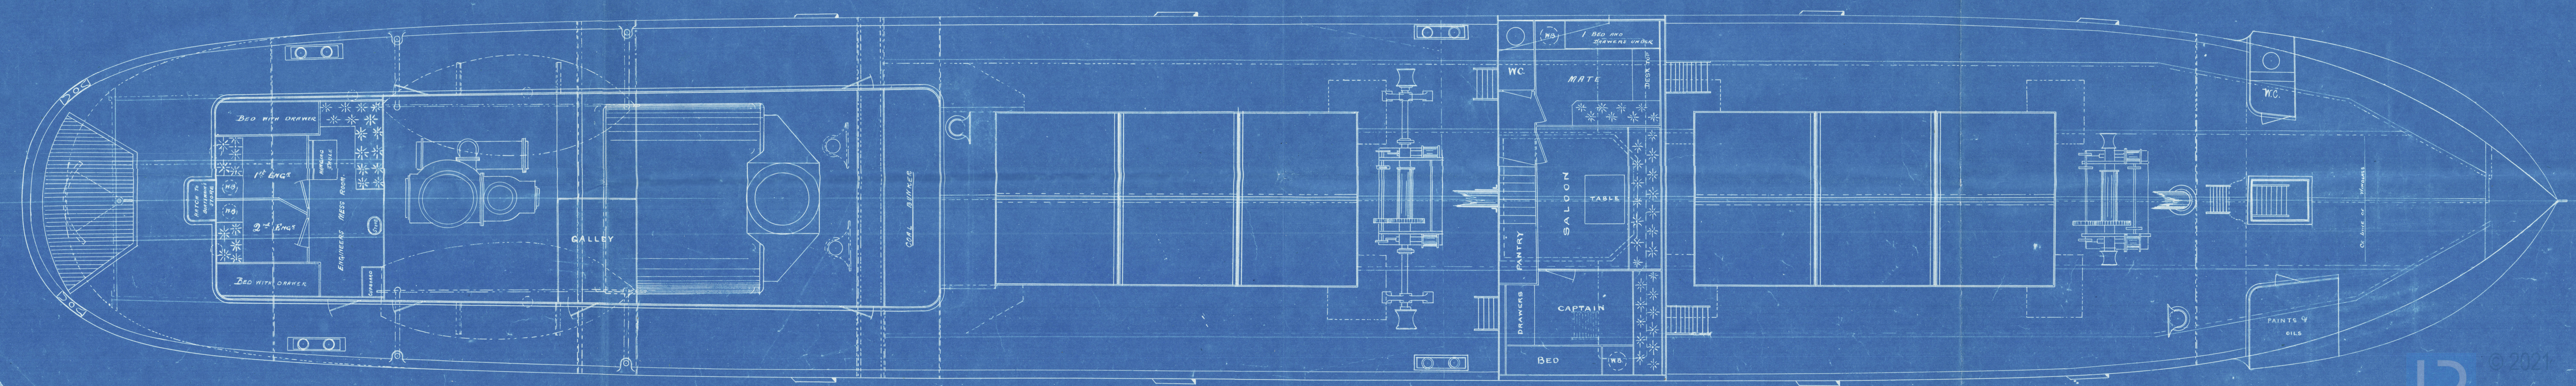


TRACING N° 941
Oct 12/97

— PROFILE AND DECK PLAN S. S. N° III *3/5 "Lodes" Buw Rpt. N° 803* —
— SCALE $\frac{1}{4}" = 1 \text{ FOOT}$ —
— LENGTH 152'-3" BREADTH 23'-6" DEPTH MOULDED 11'-3" —

R. WILLIAMSON & SON
SHIPBUILDERS
WORKINGTON.

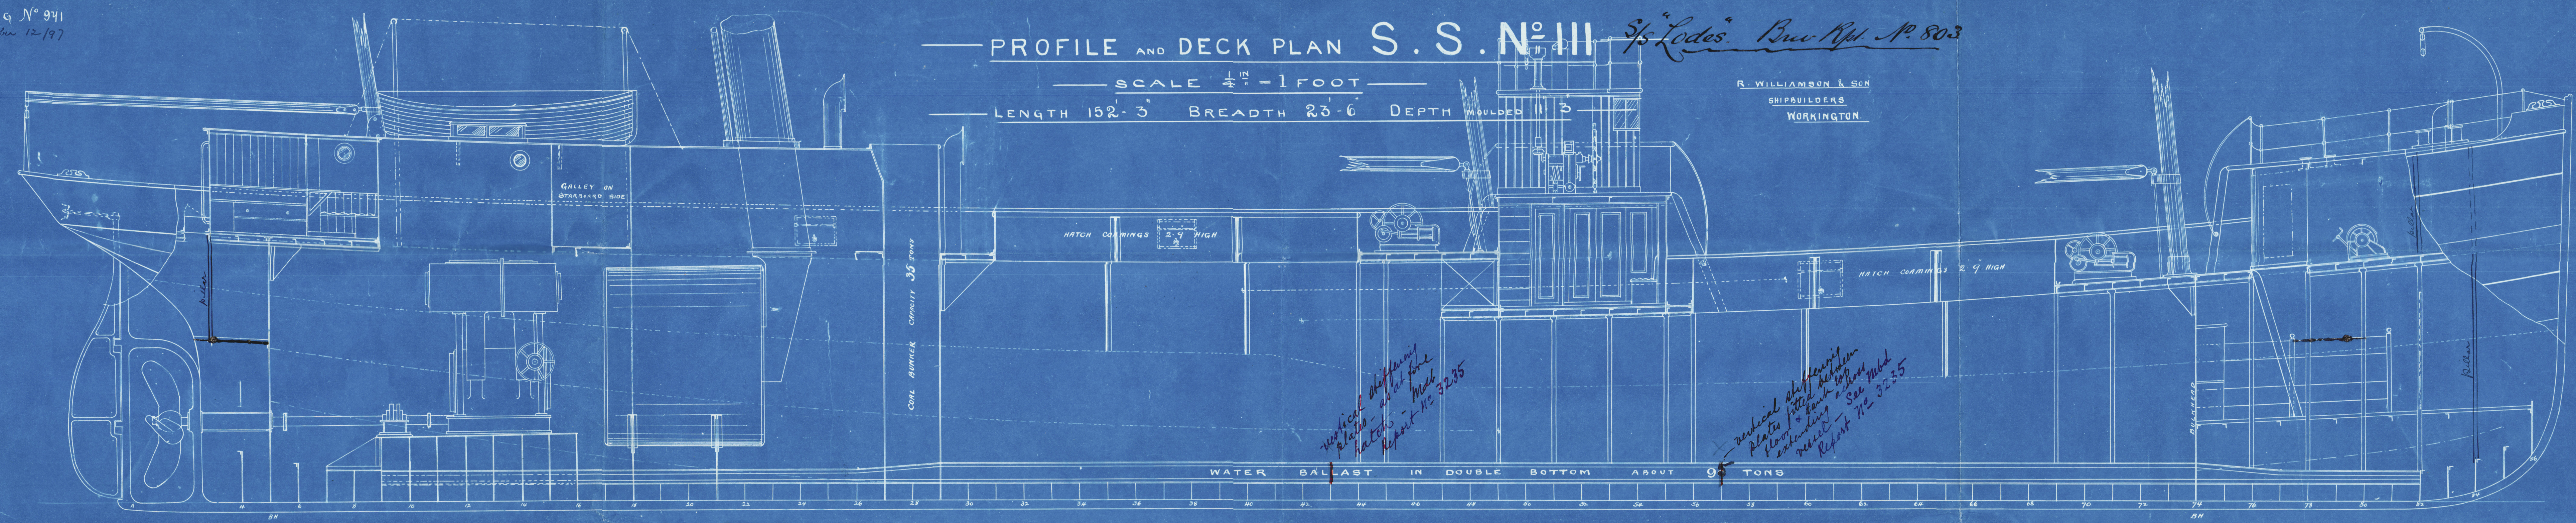

*vertical stiffening
plates - as at fore
hatch - see
Report N° 3235*


*vertical stiffening
plates fitted between
floor & bulk heads
extending - see mtd
Report N° 3235*

Profile & Deck plan.

S/S Lodes

Bur Rpt. No. 803

BRW45-0091

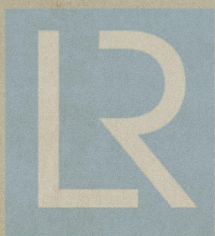

© 2021

Lloyd's Register
Foundation