

Lloyd's Register of British and Foreign Shipping.

(Report on Vessel No. _____ Port *Barrow-in-Furness*.)

No. 2862 SHIP FORGINGS OR CASTINGS.

I have to report that the undermentioned Iron ~~or Steel~~ Forgings ~~or Castings~~,
 manufactured by *Messrs Emerson Walker & Thompson*
 of *Dunston* for the Vessel No. *111*, being built
 by *Messrs Williamson & Co* of *Workington*
 have been inspected by me as set forth below, and found to be, so far as can be seen,
sound

The words FORGINGS or CASTINGS, IRON or STEEL, should be struck out as may be required.

Mark on Forgings.


Lloyd's
No. 4913B
JK

John C Craig
Newcastle

17.12.95

	STERN FRAME.	RUDDER FRAME.	STEM.
Material* ...	<i>Scrap Iron</i>	<i>Scrap Iron</i>	/
How made ...	<i>Forged</i>	<i>Forged</i>	
Dimensions ...	<i>6 1/4 - 3</i>	<i>4 1/4 - 2 1/4</i>	
Progress on Inspection	<i>Smoothed & Finished</i>	<i>Smoothed & Finished</i>	
Date when Inspected	<i>October 10-15-23-31/95</i>	<i>November 16-25 27/95</i>	

SKETCHES OF FRAMES SHOWING POSITION AND DESCRIPTION OF WELDS OF FORGINGS, OR PARTICULARS OF TESTS APPLIED TO CASTINGS.

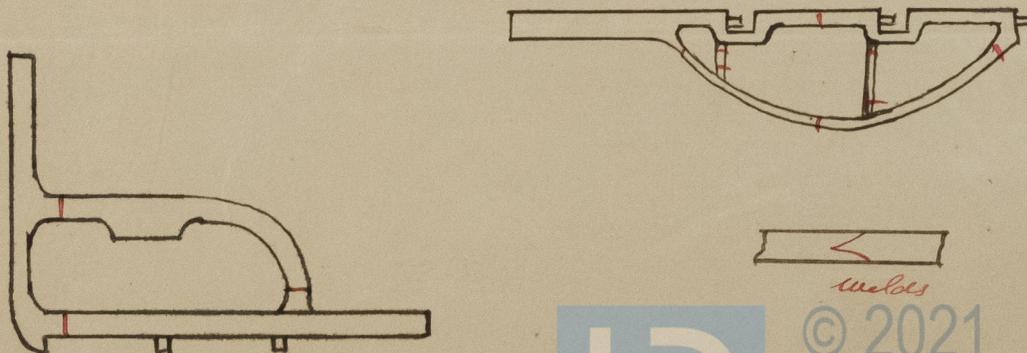

© 2021

Lloyd's Register
Foundation