
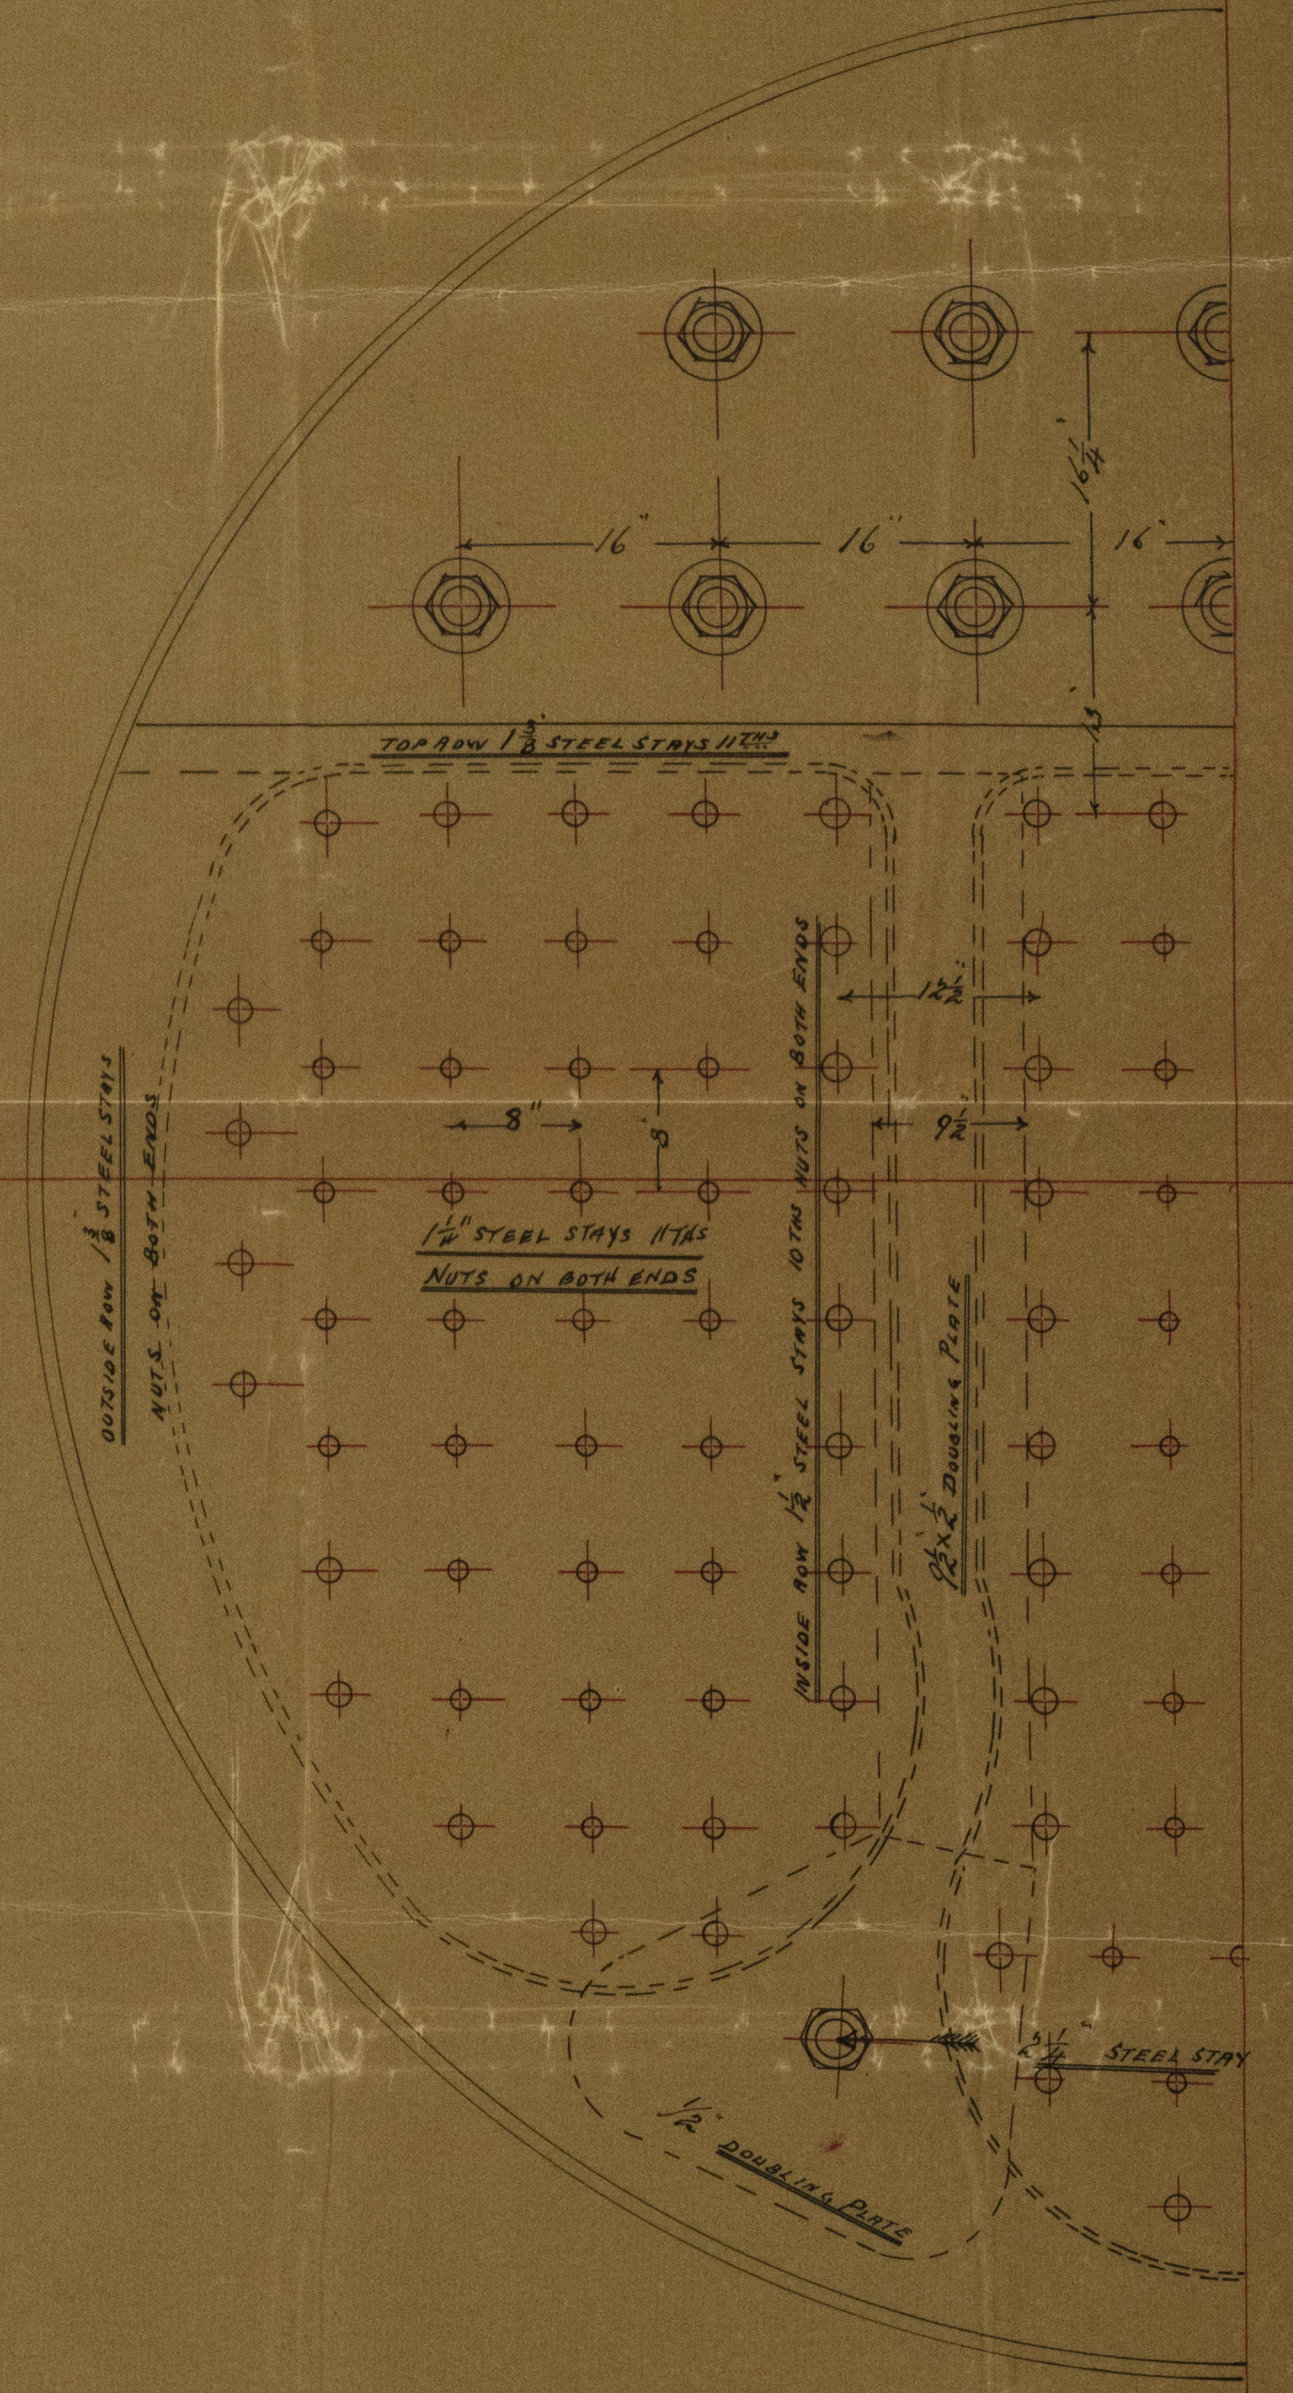
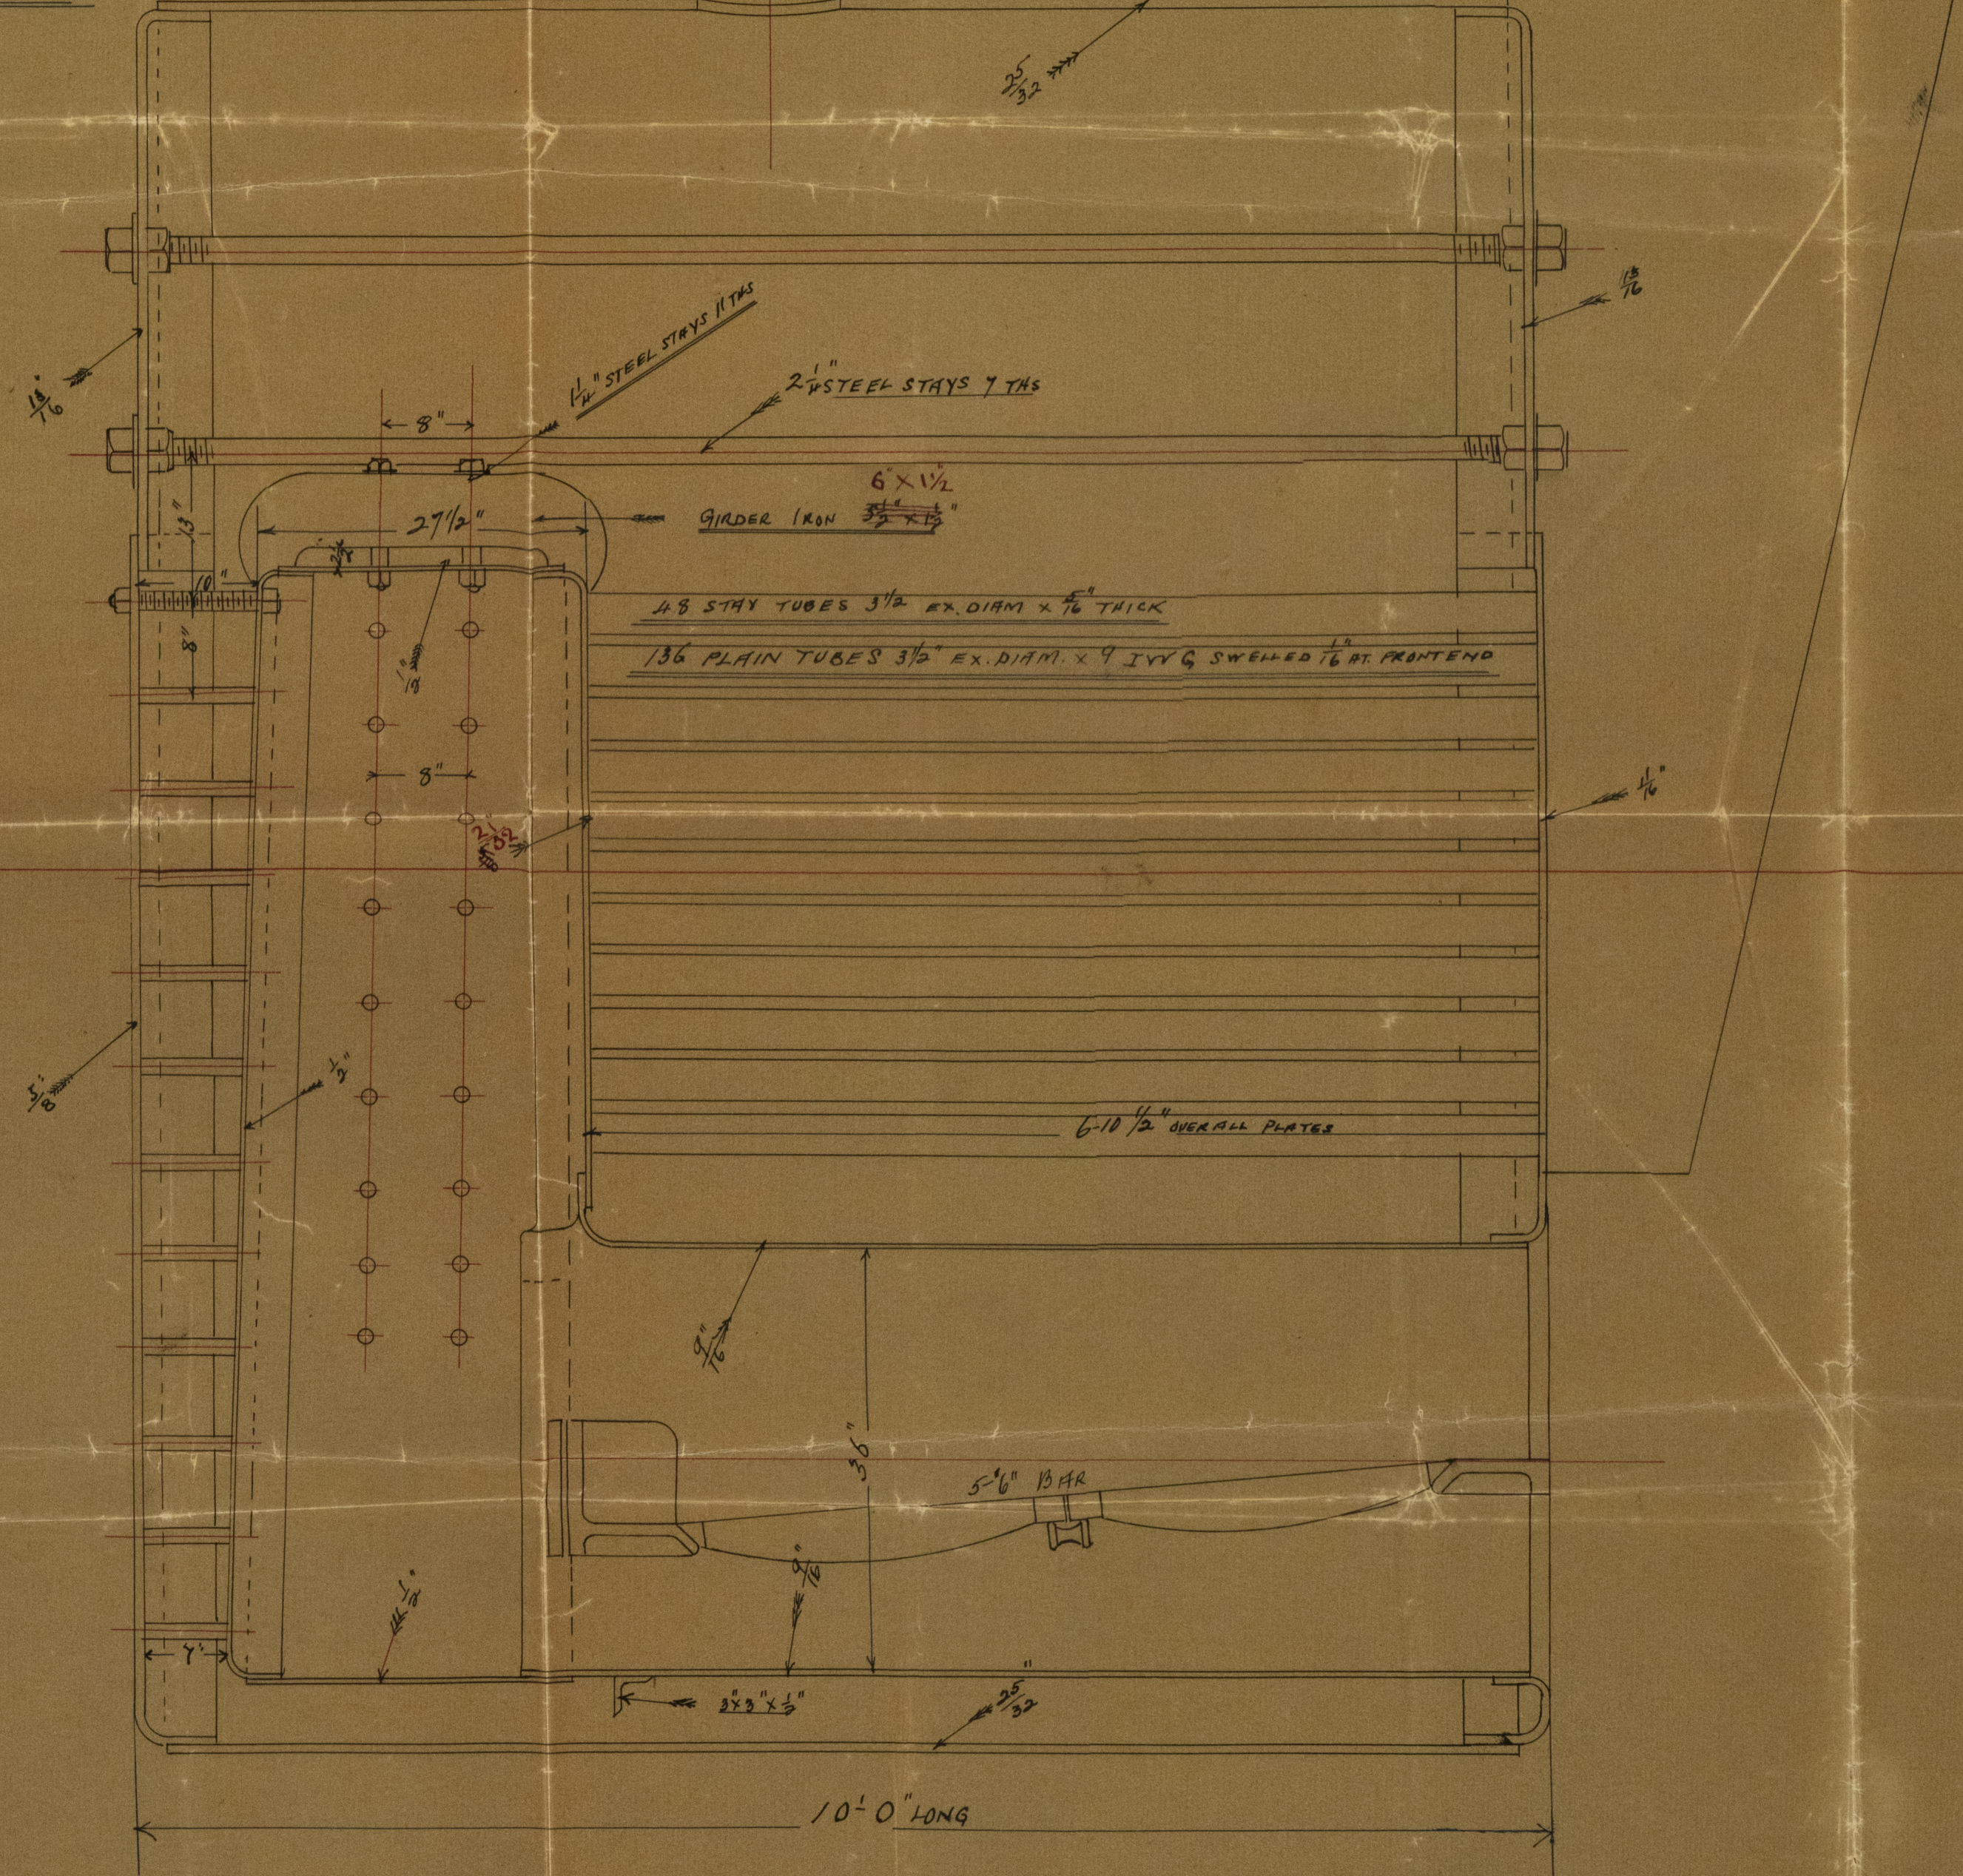


17:12:96

STEEL PLATES, BARS AND RIVETS  
ALL HOLES DRILLED IN PLACE

CH 3 SEAMS DOUBLE RIVETED  
5/8" HOLES 5/8" PITCH 2 1/2" DIA


LONG SEAMS BUTT JOINTS DOUBLE STAMP  
5/8" DRILLED HOLES 5/8" PITCH  
BUTT STAMPS 3/4" THICK

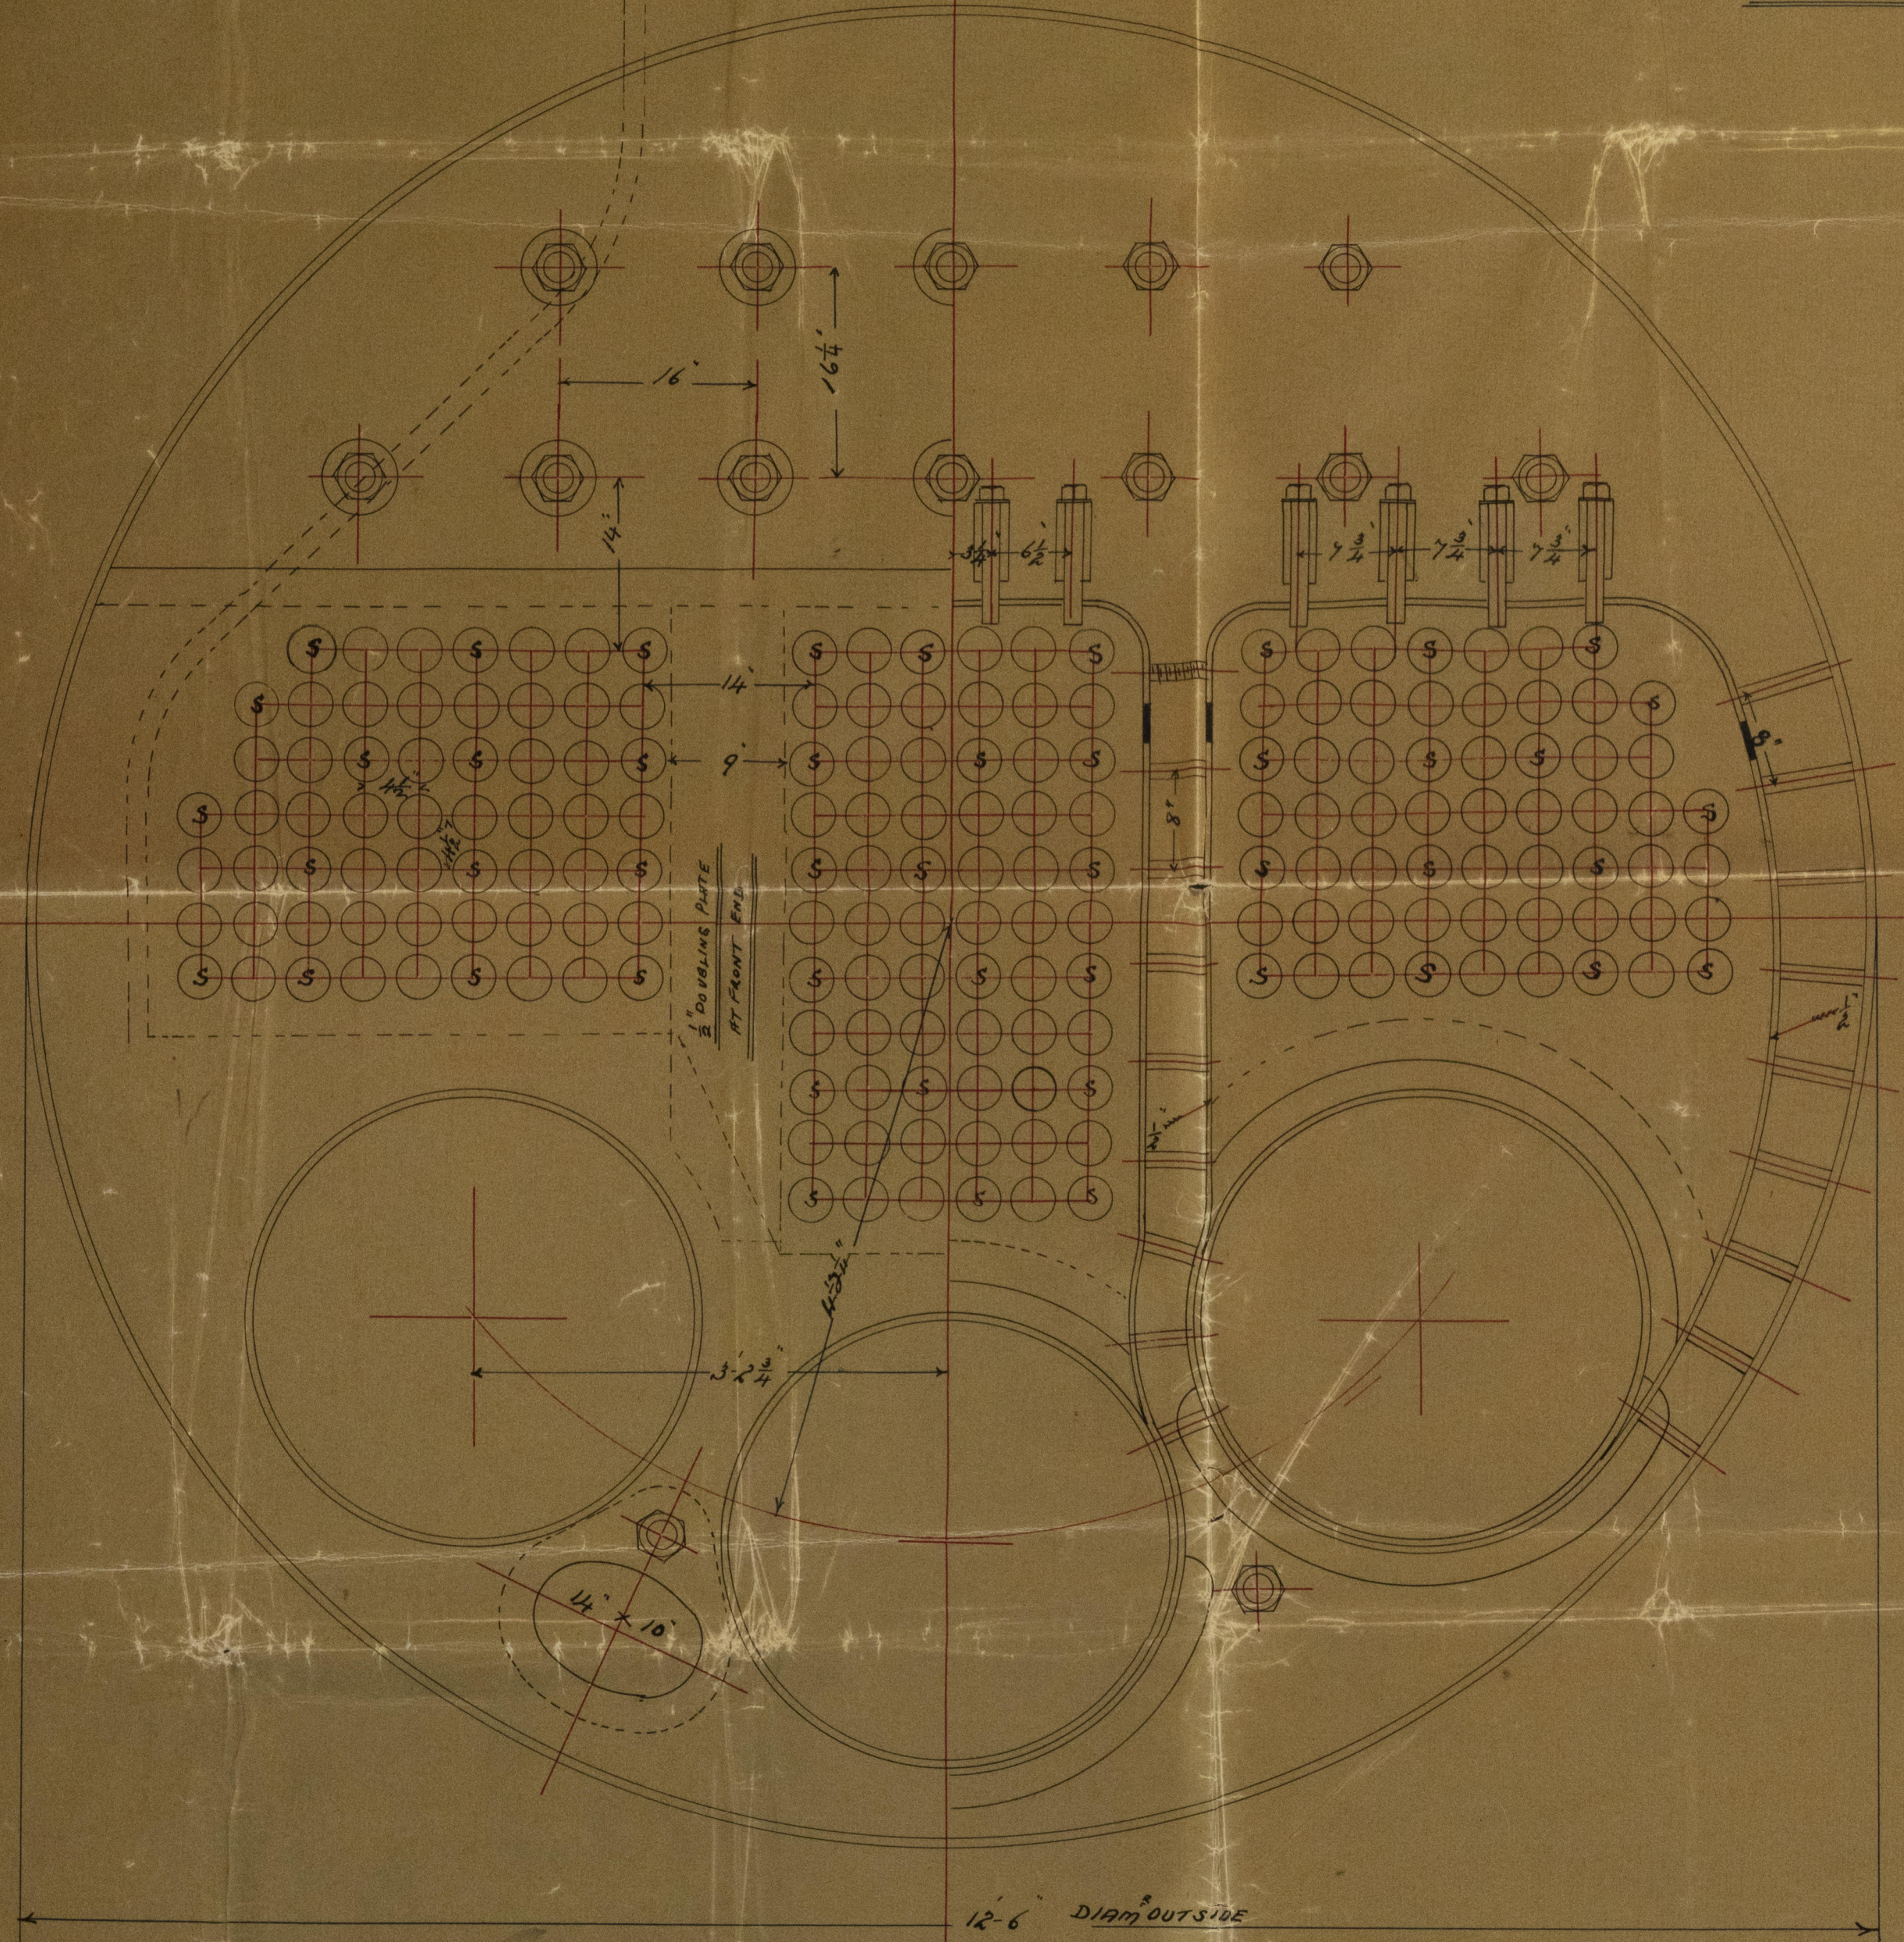

BOILER N° 701

WORKING PRESSURE 115 LBS PER SQ INCH  
SCALE INCH - ONE FOOT

TO HAVE LLOYD'S CERTIFICATE

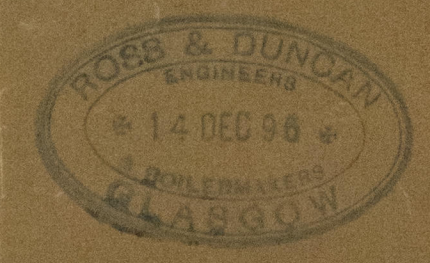

17:12:96

17:12:96



© 2021  
BRN45-00493-001  
Foundation