

*Used as built.*

**MIDSHIP SECTION**

S/S N<sup>o</sup> 72

SCALE 1/2 INCH = 1 FOOT.

**SCANTLING N<sup>os</sup>**

1/2 BREADTH 10.25

1/2 GIRTH 17.67

WHOLE DEPTH 12.00

39.92 1<sup>ST</sup> N<sup>o</sup>

LENGTH 104

4271.44 2<sup>ND</sup> N<sup>o</sup>


U.D. TONNAGE 146.79 TONS.

*Bro. Rpt. N<sup>o</sup> 823.*


*Steam Trawler "ABOO."*



**SECTIONS THROUGH TANK.**

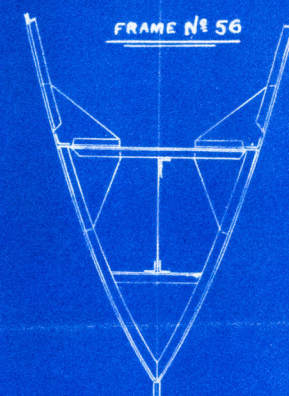


SCALE 1/4" = 1 FOOT.

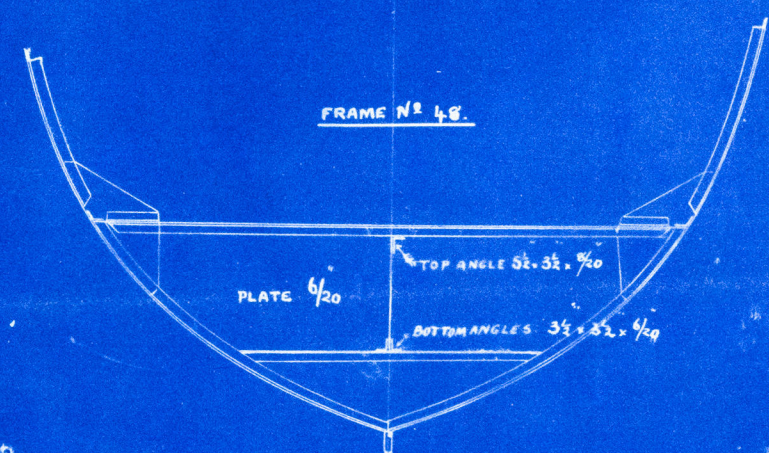

**RIVETING.**

BUTTS OF SHEERSTRAKE & GARBARD TO BE DOUBLE RIVETED WITH STRAPS 1/20 THICKER THAN THE PLATES THEY CONNECT.  
OTHER STRAKES TO BE LAPPED & TREBLERIVETED FOR 1/2 LENGTH 30.  
OTHER PARTS OF SHELL TO BE DOUBLE RIVETED.  
STRINGERS LAPPED & DOUBLE RIVETED.

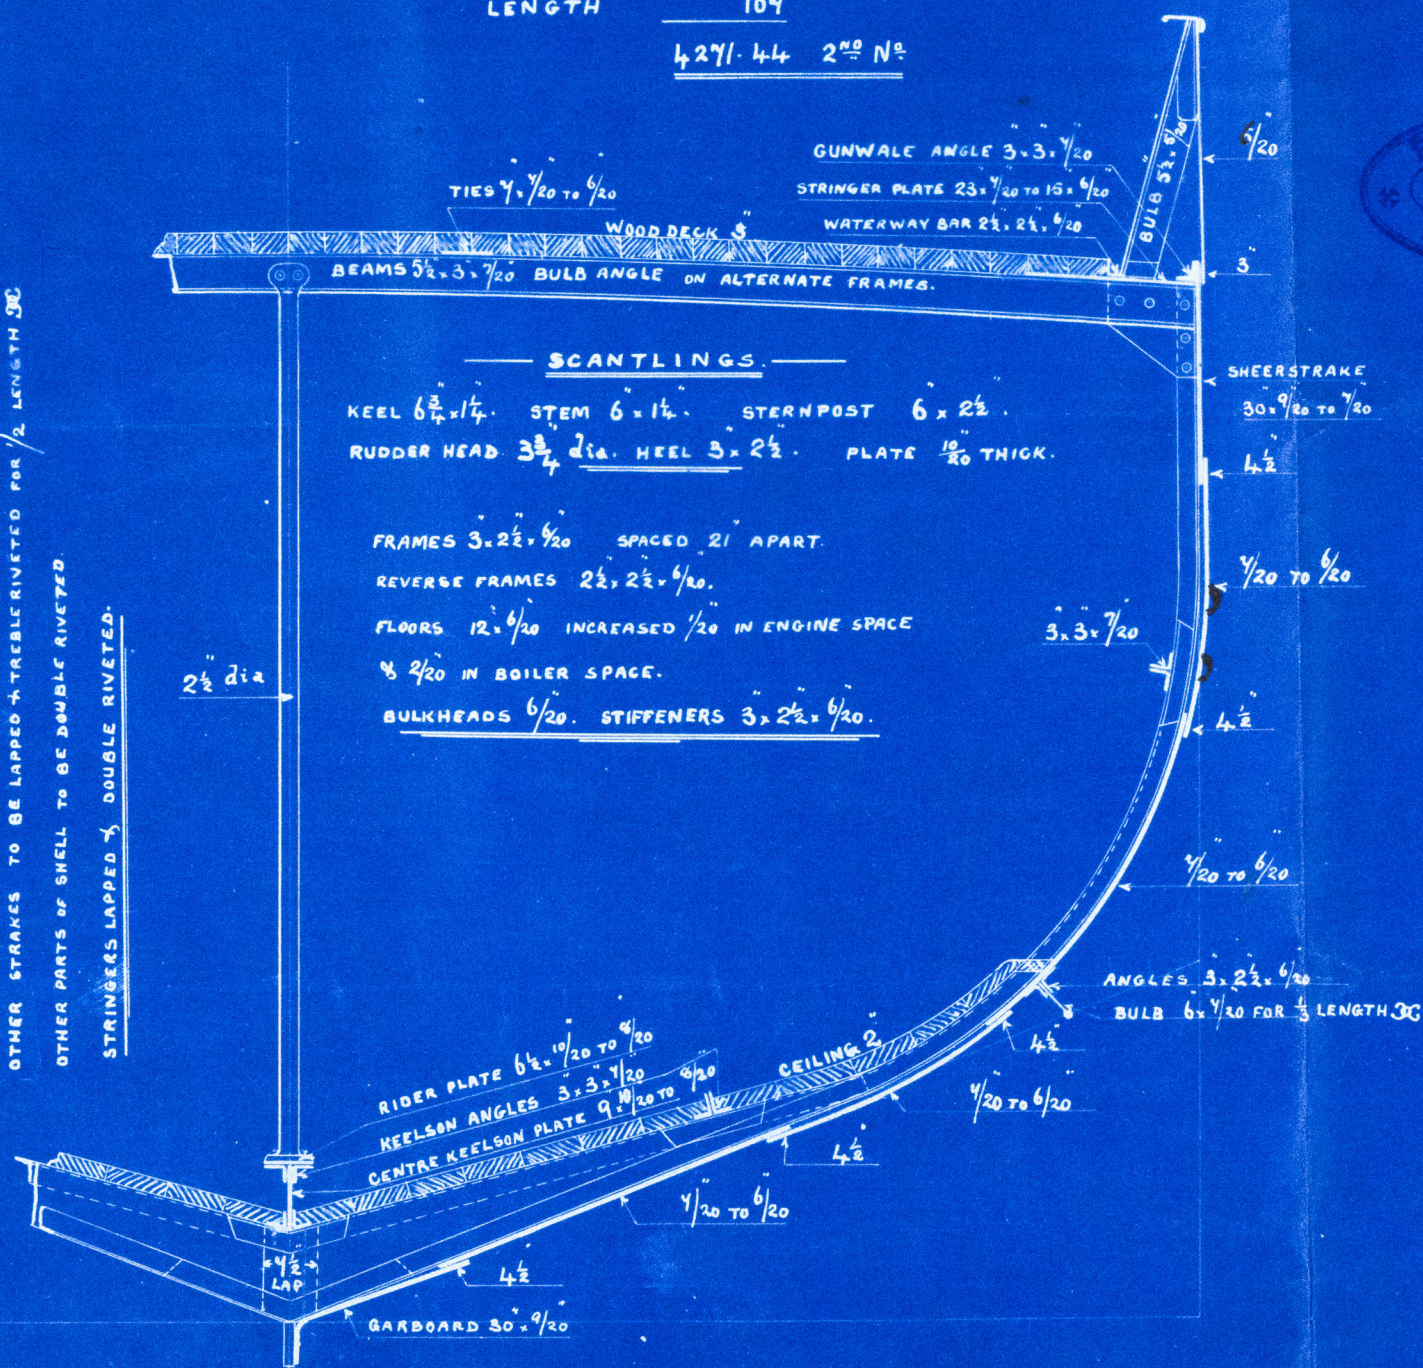

© 2021 Lloyd's Register Foundation



Barrow. Rpt. No. 823.

Steam Trawler "JABOO"

BRW46-0019



© 2021

Lloyd's Register  
Foundation