



Vessel as built.  
 — PROFILE & DECK PLANS.—  
 — S/S N<sup>o</sup> 72.—  
 — SCALE 1/4 INCH = 1 FOOT.—

Proc. Rpt. N<sup>o</sup> 823.  
 Steam Trawler "JABOO."

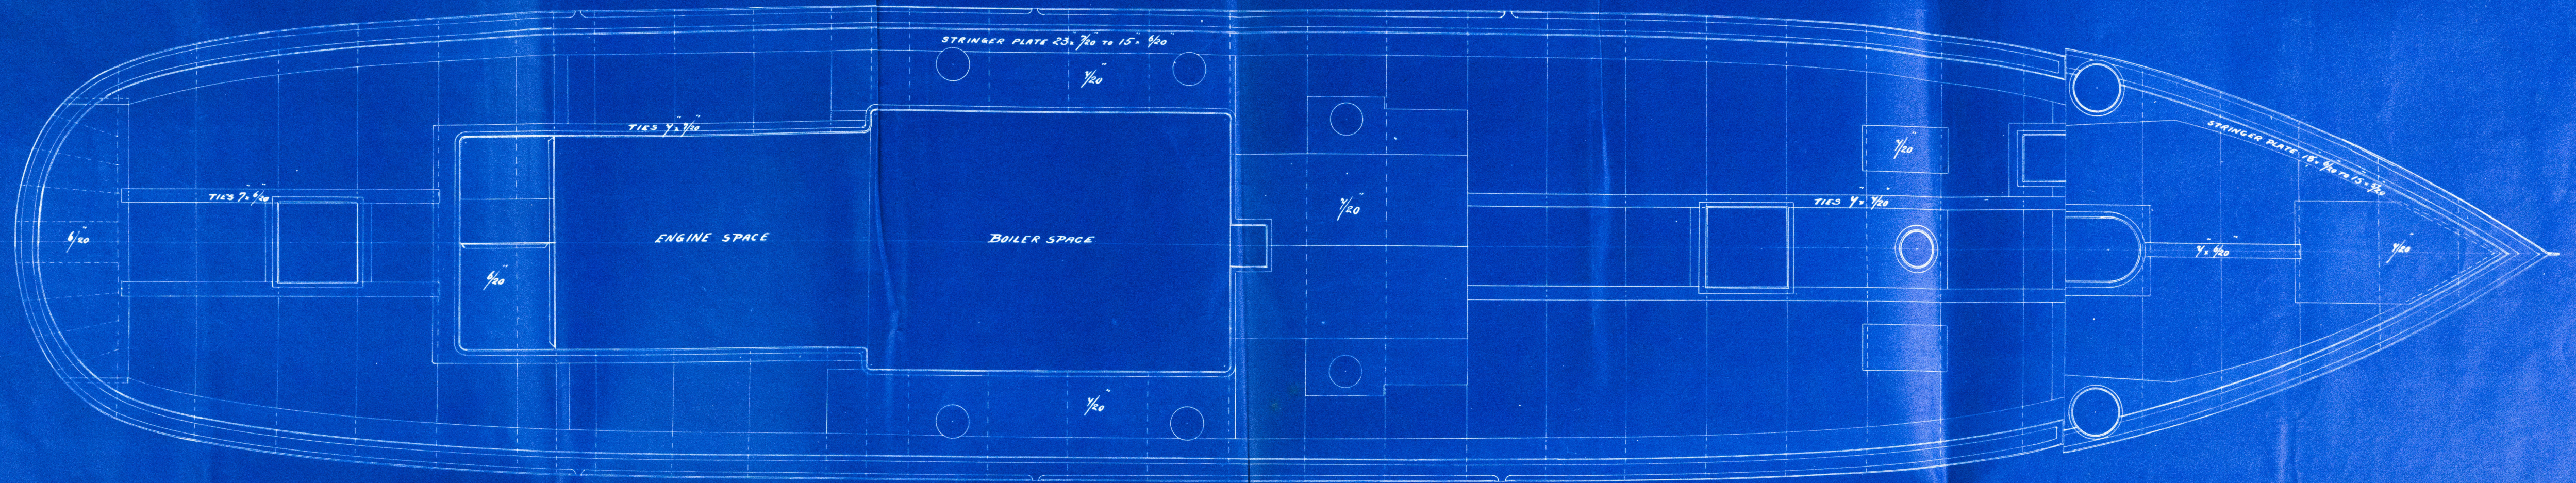

RITSON & CO.  
 SHIPBUILDERS  
 WARYPORT

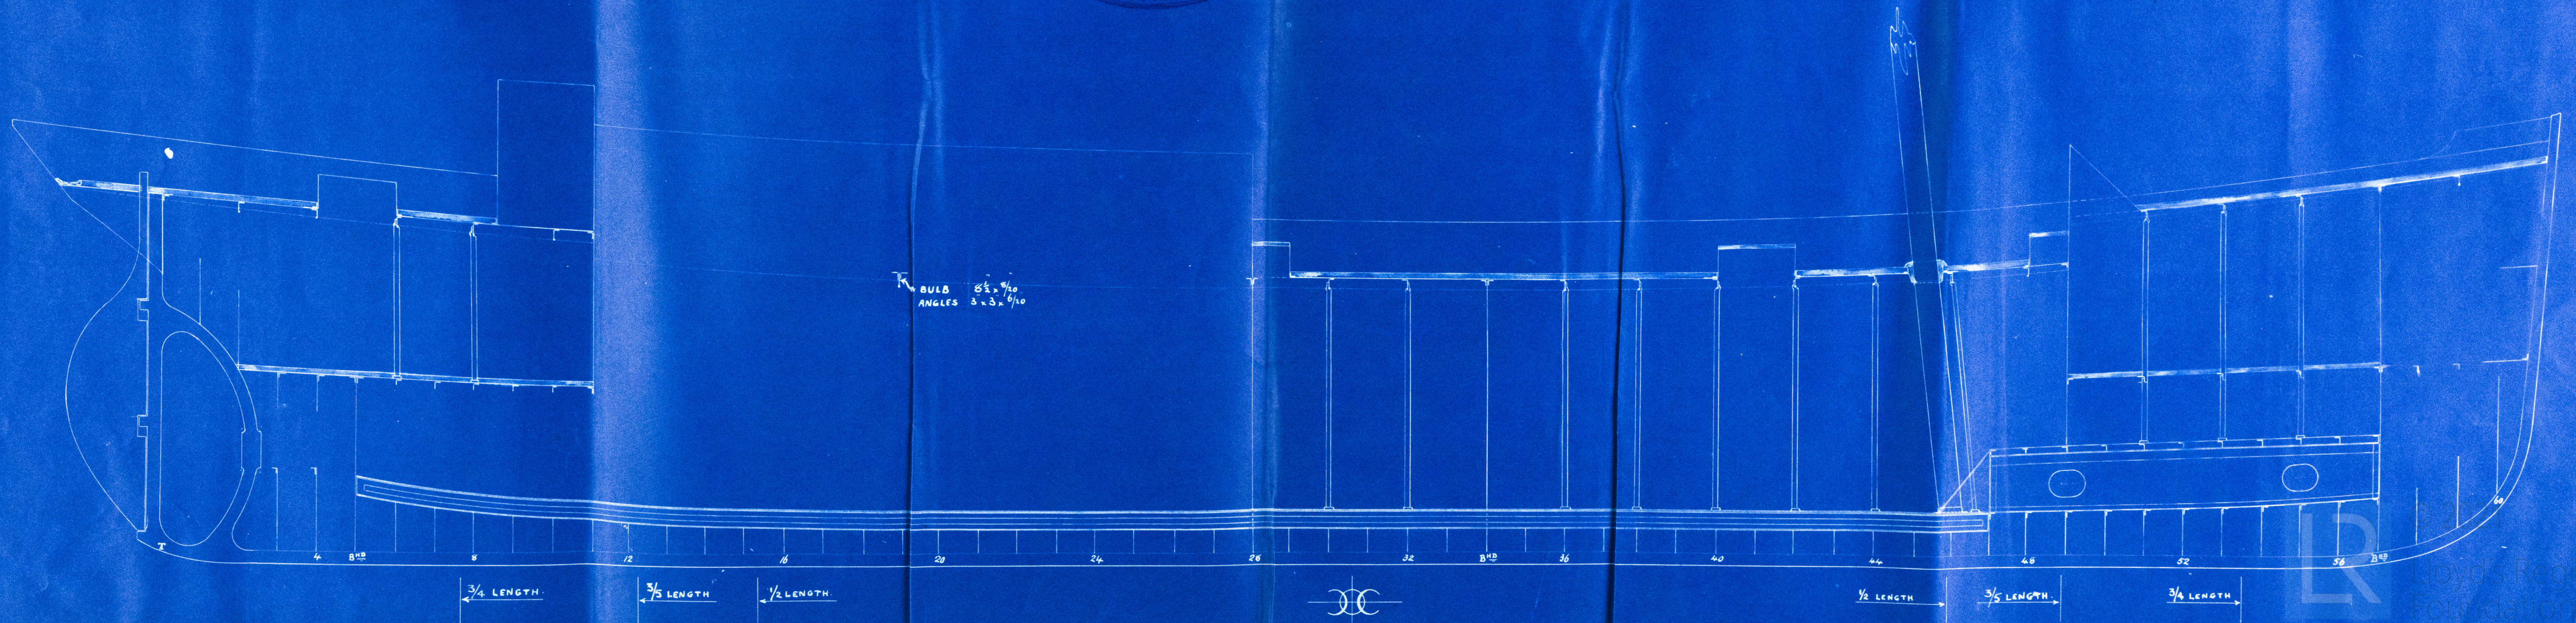



Barrow Rpt. No. 823.  
Steam Trawler "JABOO"

BRW46-0023



© 2021

Lloyd's Register  
Foundation