


FOR ENCLOSURE.

To Lloyd's.

BRW46-0058 (1/2)

20/6/98
J.M.C.

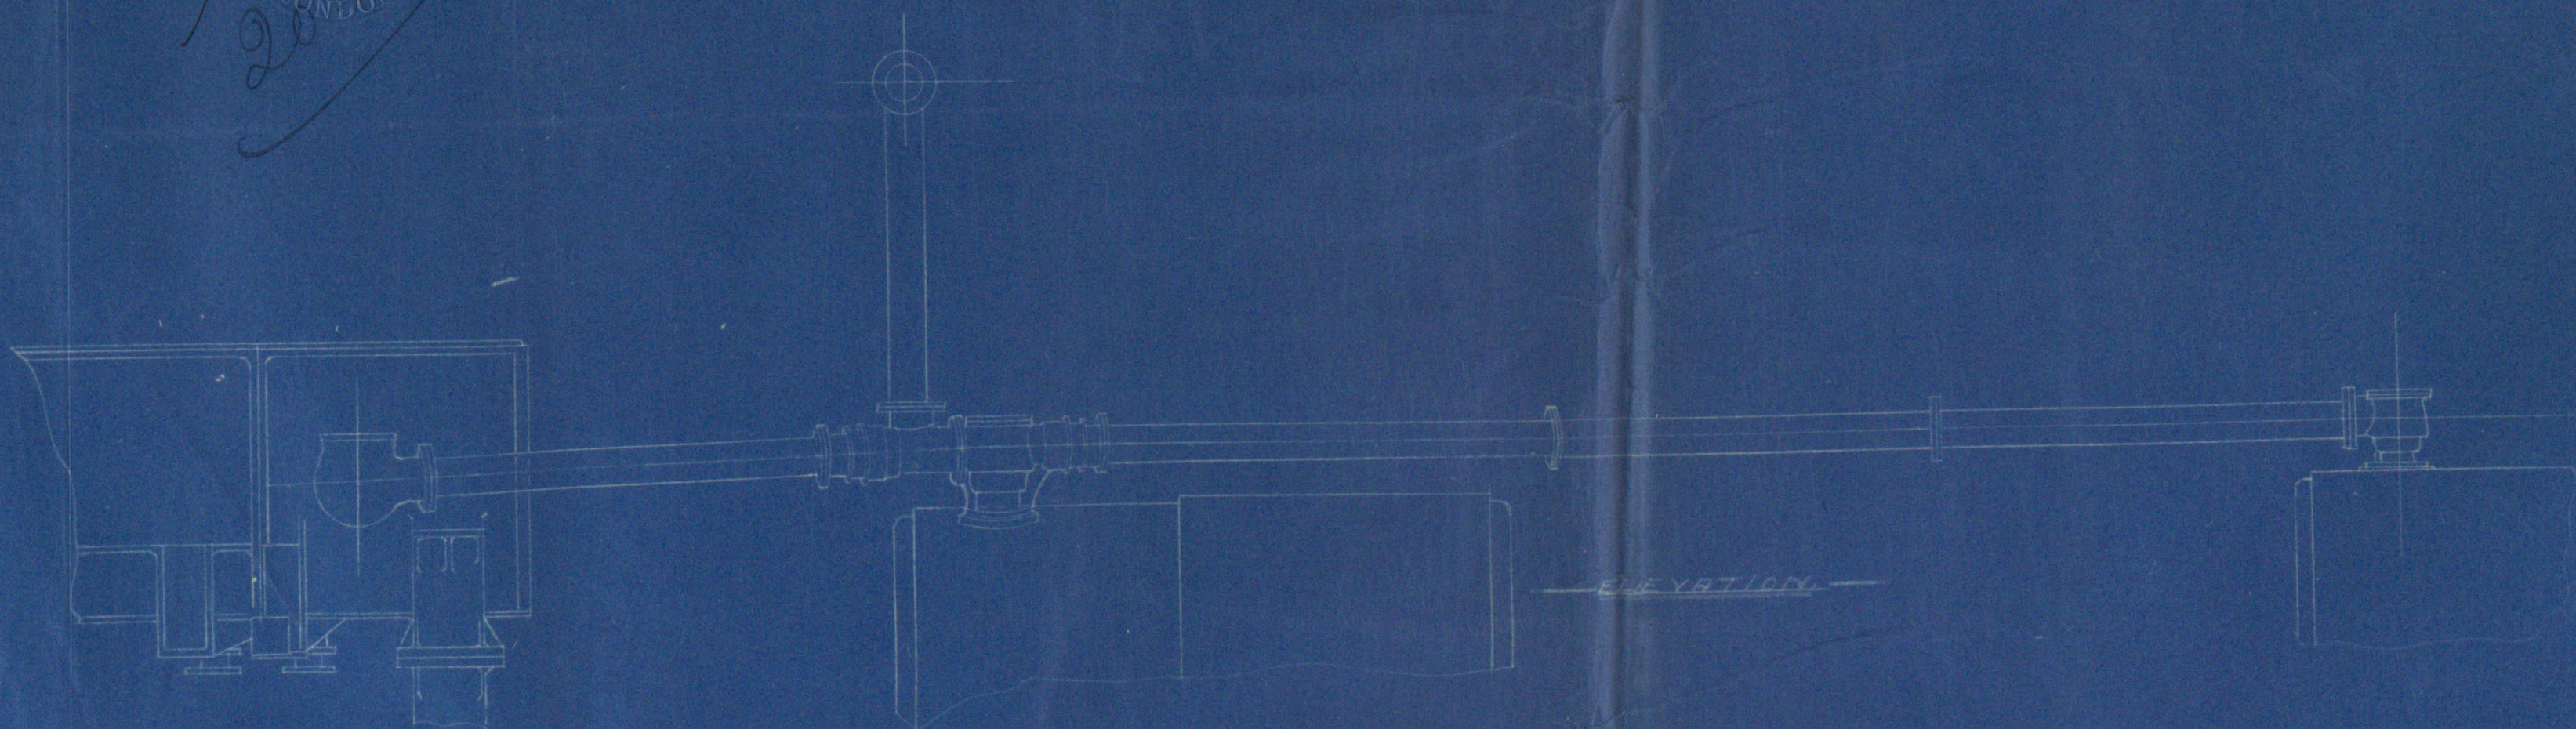

20/6/98
J.M.C.

CENTRE LINE OF ENGINE



Expansion joint
The main exhaust
to the main exhaust



Expansion joint
The main exhaust
to the main exhaust


PLAN

ARRANGEMENT OF MAIN STERN PIPES

SCALE 1/2" = 1 FT

ENGINES N° 266

J.M.C.
20/6/98

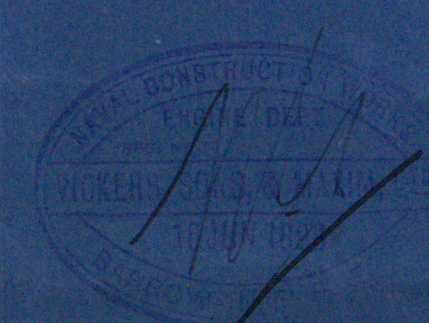

BRW46-0058 (2/2)



Lloyd's Register
Foundation

Vickers Sons & Maxim
Main Steam Pipes

No 2 66 Vessel


Brw Rpt No 849

SS Anglia



BRW46-0058

(2/2)

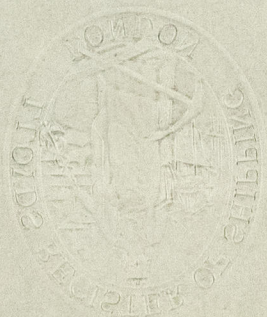

© 2021

Lloyd's Register
Foundation