

TRACING, N° 1244  
20<sup>K</sup> OCTOBER 20/98

**MIDSHIP SECTION N<sup>o</sup> 118**


R. WILLIAMSON & SON  
SHIPBUILDERS  
WORKINGTON.

SCALE  $\frac{1}{2}'' = 1$  FOOT

TO CLASS 100 A1 AT LLOYDS

Barrow Report No. 853.  
S.S. "LUDDICK"

**DIMENSIONS** LENGTH 166-0 BREADTH 26-0 DEPTH 13-5 LLOYDS  
" 12-10 1/2 MOULDED

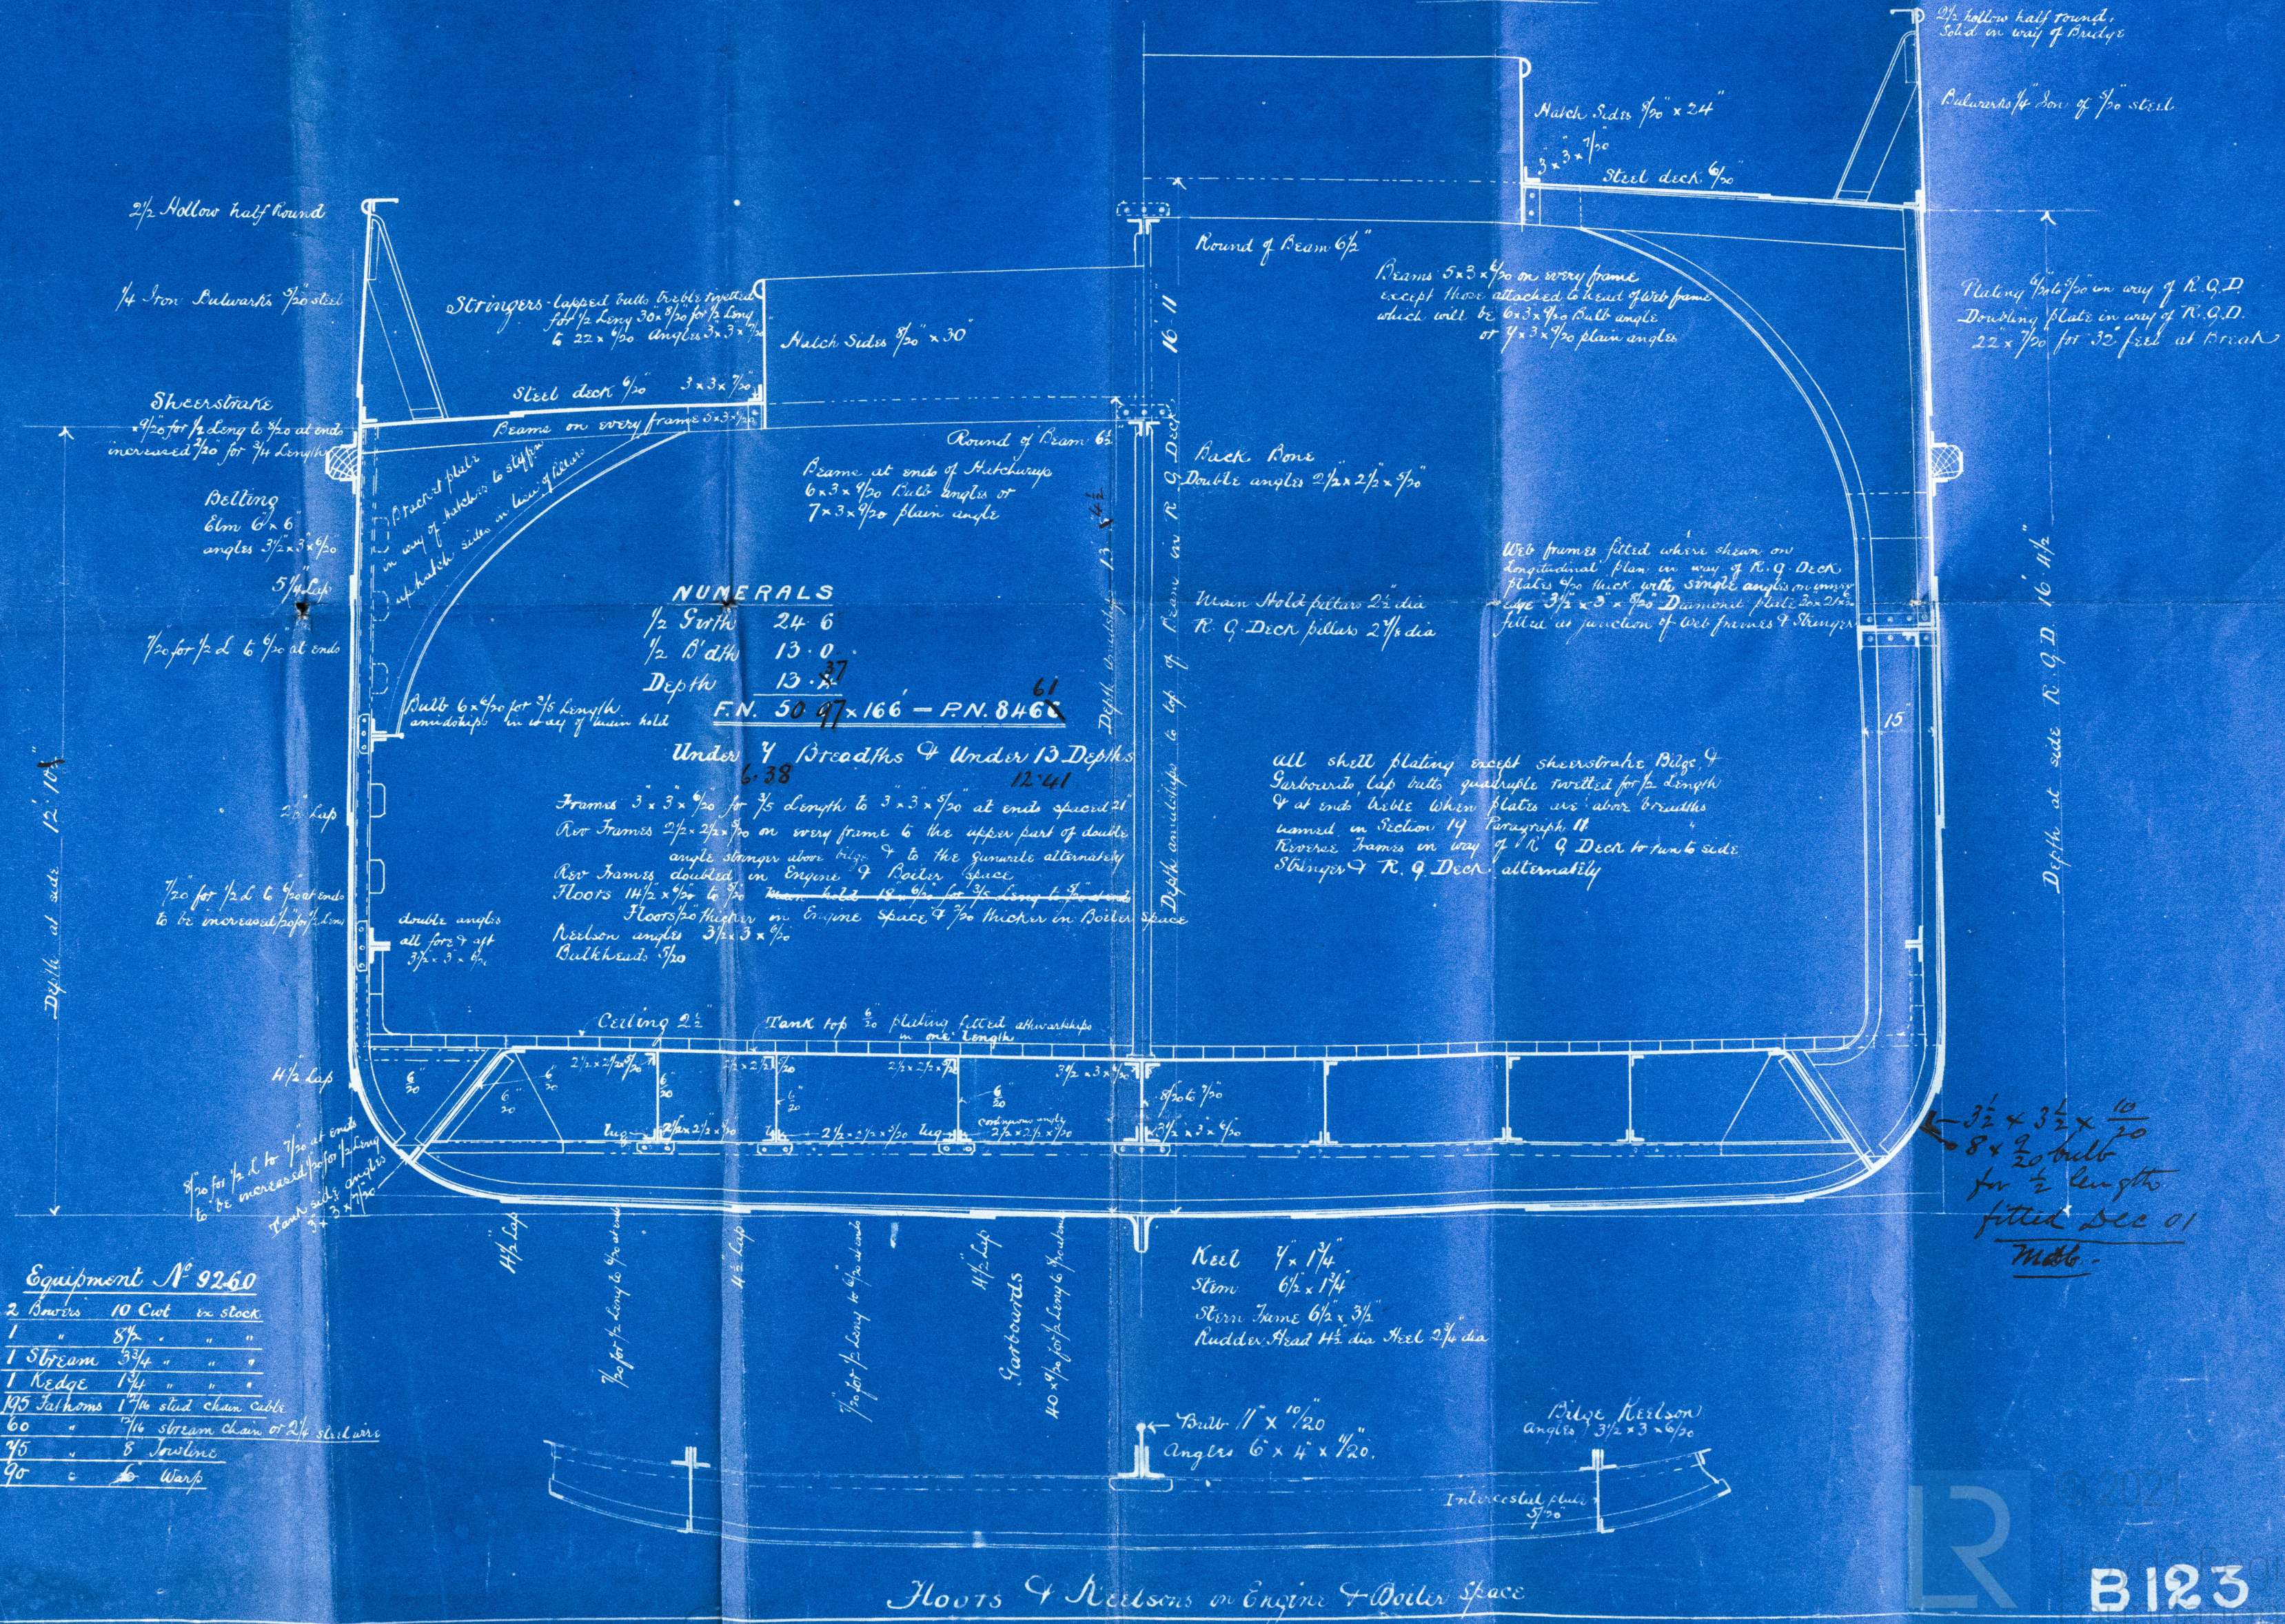



R. Williamson & Son

S/s N° 118

S/s Luddick

Midship Section

Barrow Report N° 853

BRW46-0073



© 2021

Lloyd's Register  
Foundation