

TRACING N° 1204.
MARCH 25-198.

SCALE $\frac{1}{4}$ IN. = 1 FOOT

R. WILLIAMSON & SON
SHIPBUILDERS
WORKINGTON.

93m 98
23-3-98
V. J.


ILM
 29/3/98

PLAN OF PUMPING ARRANGEMENTS

R. Williamson & Son's No. 118.

S.S. "LUDDICK"

BARROW REPORT NO. 853.

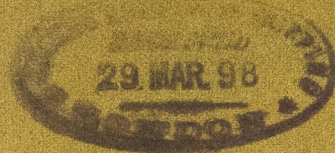

Sketch 1000

ENGINE & BOILER



over tank:

BRIDGE



© 2021

Lloyd's Register
Foundation