


TRACNG. N° 1213.

APRIL 21-98.



93rw  
23.4.98  
M.S.

25.4.98

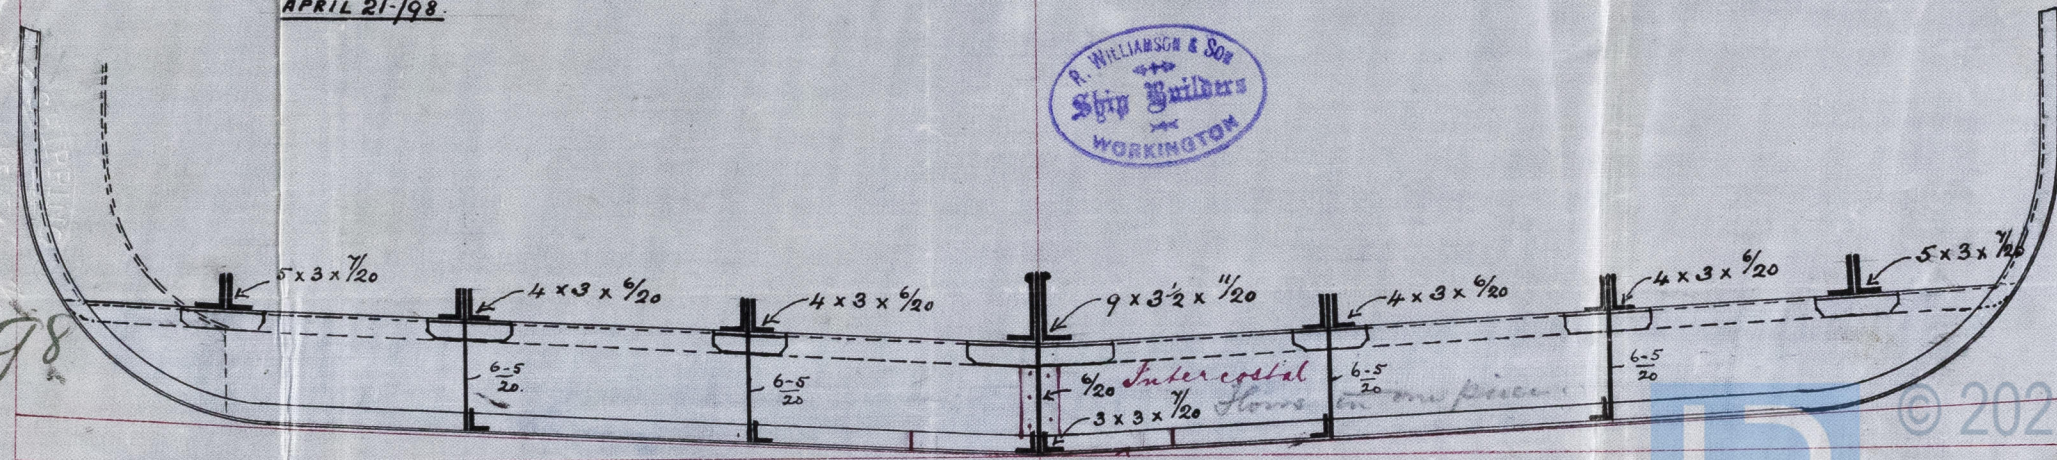

heel pieces / Keel to be straight  
— S.S. N° 158. —  
SCALE 1/2" = 1 FOOT.

Lloyd's Register  
Foundation  
25/4/98  
BRW46-0120