

MARCH 28/98

19. 4. 98  
25. 4. 98 (p. 158)


7 No 158

appo. 2874/98.

Brow  
14/4/98  
11.9

scale  $\frac{1}{2}'' = 1$  foot.

TO CLASS 100A1 AT LLOYDS

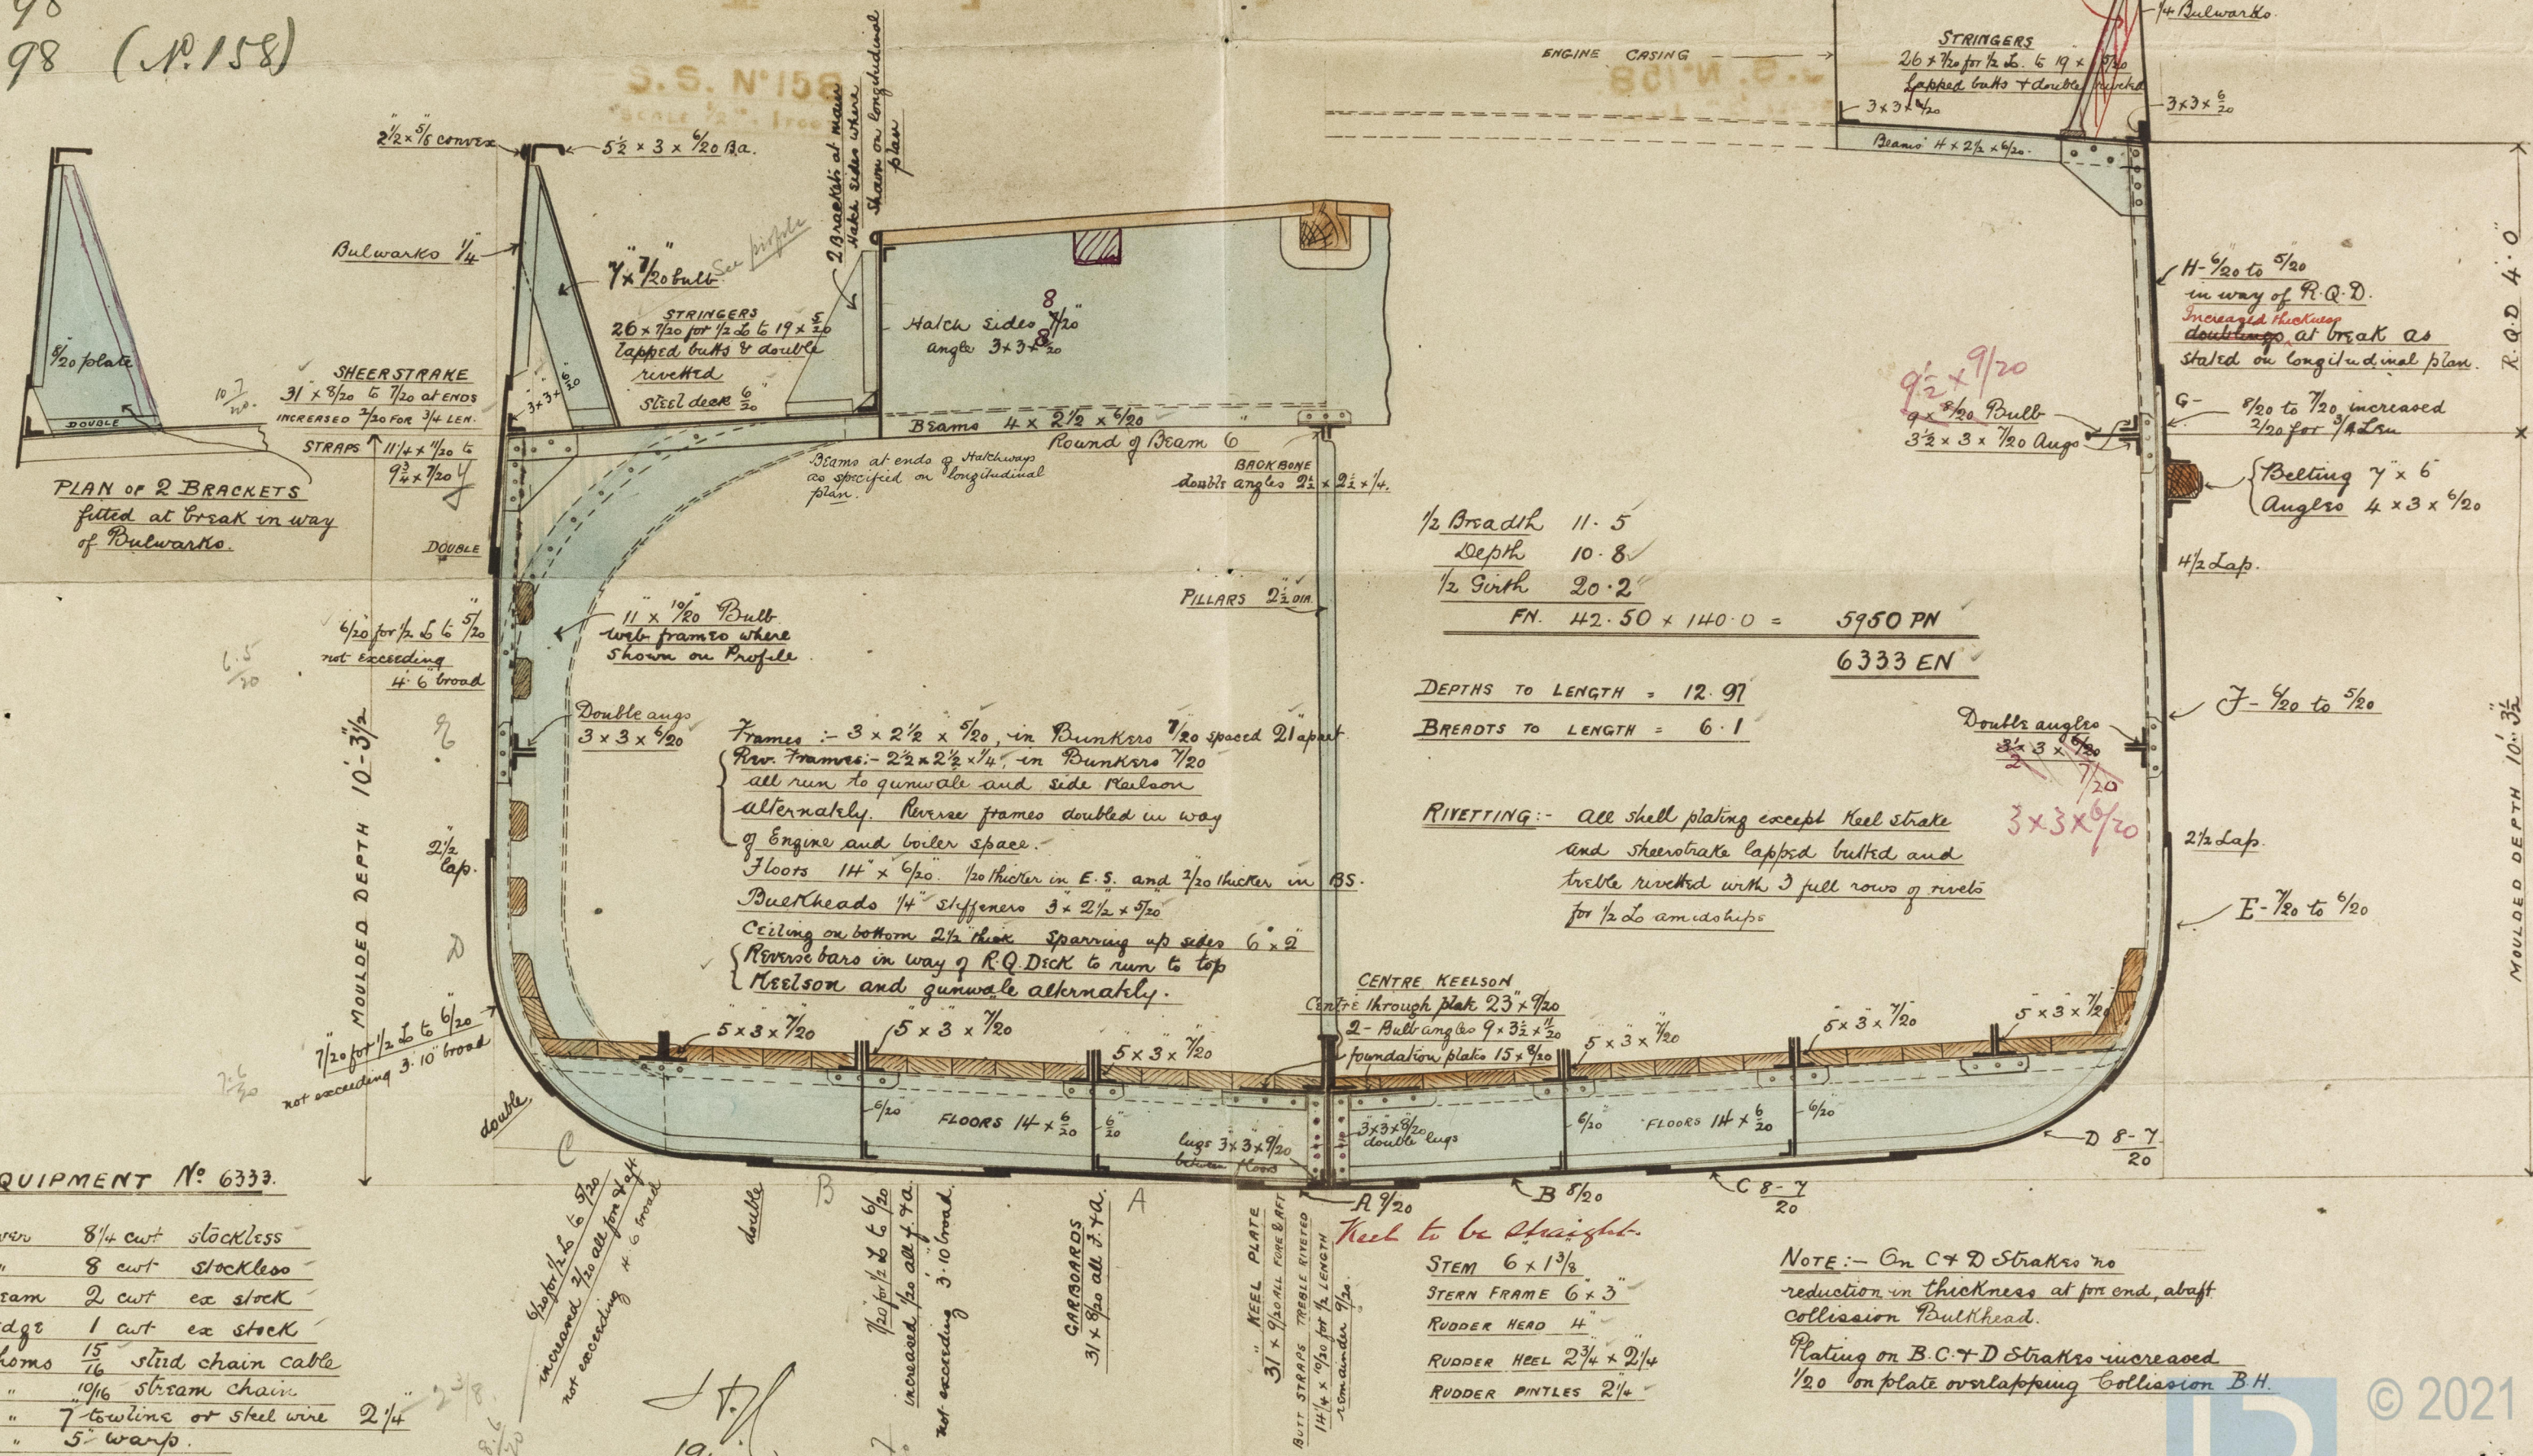

EQUIPMENT № 6333.

- |             |           |                      |       |
|-------------|-----------|----------------------|-------|
| 1 Bowen     | 8 1/4 cwt | stockless            |       |
| 1 "         | 8 cwt     | stockless            |       |
| 1 stream    | 2 cwt     | ex stock             |       |
| 1 Ridge     | 1 cwt     | ex stock             |       |
| 165 fathoms | 15<br>16  | stud chain cable     |       |
| 45 "        | 10 1/6    | stream chain         |       |
| 75 "        | 7         | towing or steel wire | 2 1/4 |
| 90 "        | 5         | warp.                |       |

NOTE:- On C & D Strakes no  
reduction in thickness at fore end, abaft  
collision Bulkhead.

Plating on B, C & D Strakes increased  
1/20 on plate overlapping Collision B.H.





Midships Section

R. Williamson & Co.

S/S N° 156 48.

Ed Fred 27/4/98

Brow P.H.

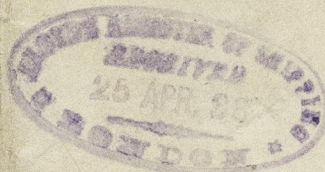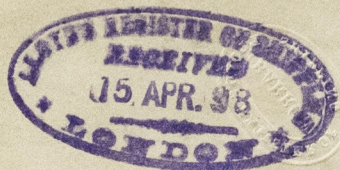

© 2021

Lloyd's Register  
Foundation