

19.4.98
25.4.98 (No. 158)

LENGTH 140.0" BREADTH 23.0" DEPTH 10.3 1/2 MOULDED

TO CLASS 100A1 AT LLOYDS

SCALE $\frac{1}{4}$ " = 1 FOOT


R. WILLIAMSON & SON
SHIPBUILDERS
WORKINGTON

appo. 2574/98

PLAN OF R. Q. DECK.

PLAN OF MAIN DECK

J.V.L.
19/4/98
25/4/98

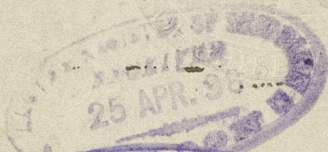

Profile & Deck plan.

R. Williamson & Linn

S/S N^o 156 48.

Fred.

21/11/98
H. Fred

Row 886.



© 2021

Lloyd's Register
Foundation