

# Lloyd's Register of British and Foreign Shipping.

(Report on Vessel No. \_\_\_\_\_ Port \_\_\_\_\_)

No. 1958 a

## SHIP FORGINGS OR CASTINGS.

The words FORGINGS or CASTINGS, IRON or STEEL, should be struck out as may be required.

I have to report that the undermentioned Iron or Steel Forgings or Castings, manufactured by Messrs G & Co Ltd of Sunderland for the Vessel No. 6, being built by Berry Dock Co. of \_\_\_\_\_ have been inspected by me as set forth below, and found to be, so far as can be seen, sound.

Mark on Forgings.

**Lloyd's**

No. 1958 a

G & Co



Hugh Cameron

Sunderland

16.5.91

	STERN FRAME.	RUDDER FRAME.	STEM.
Material* - - -	<u>Scrap iron</u>		
How made - - -	<u>Forged</u>		
Dimensions - - -	<u>6' x 2 1/2"</u>		
Progress on Inspection -	<u>Forged &amp; riveted</u>		
Dates when Inspected {	<u>April 9-11. 23-24/91</u>		

SKETCHES OF FRAMES SHEWING POSITION AND DESCRIPTION OF WELDS OF FORGINGS, OR PARTICULARS OF TESTS APPLIED TO CASTINGS.

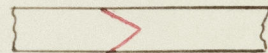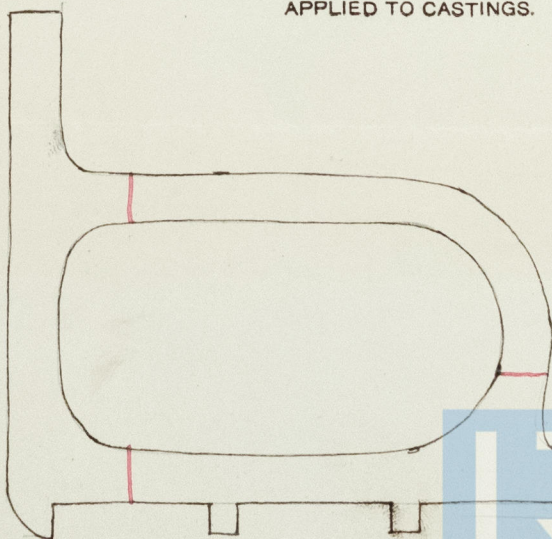

Welds

© 2021

Lloyd's Register  
Foundation