

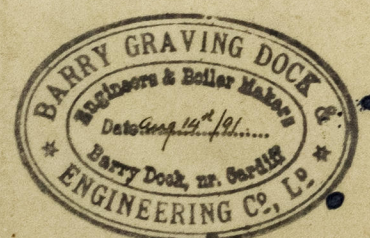


Ltr. 17. 8. 91.

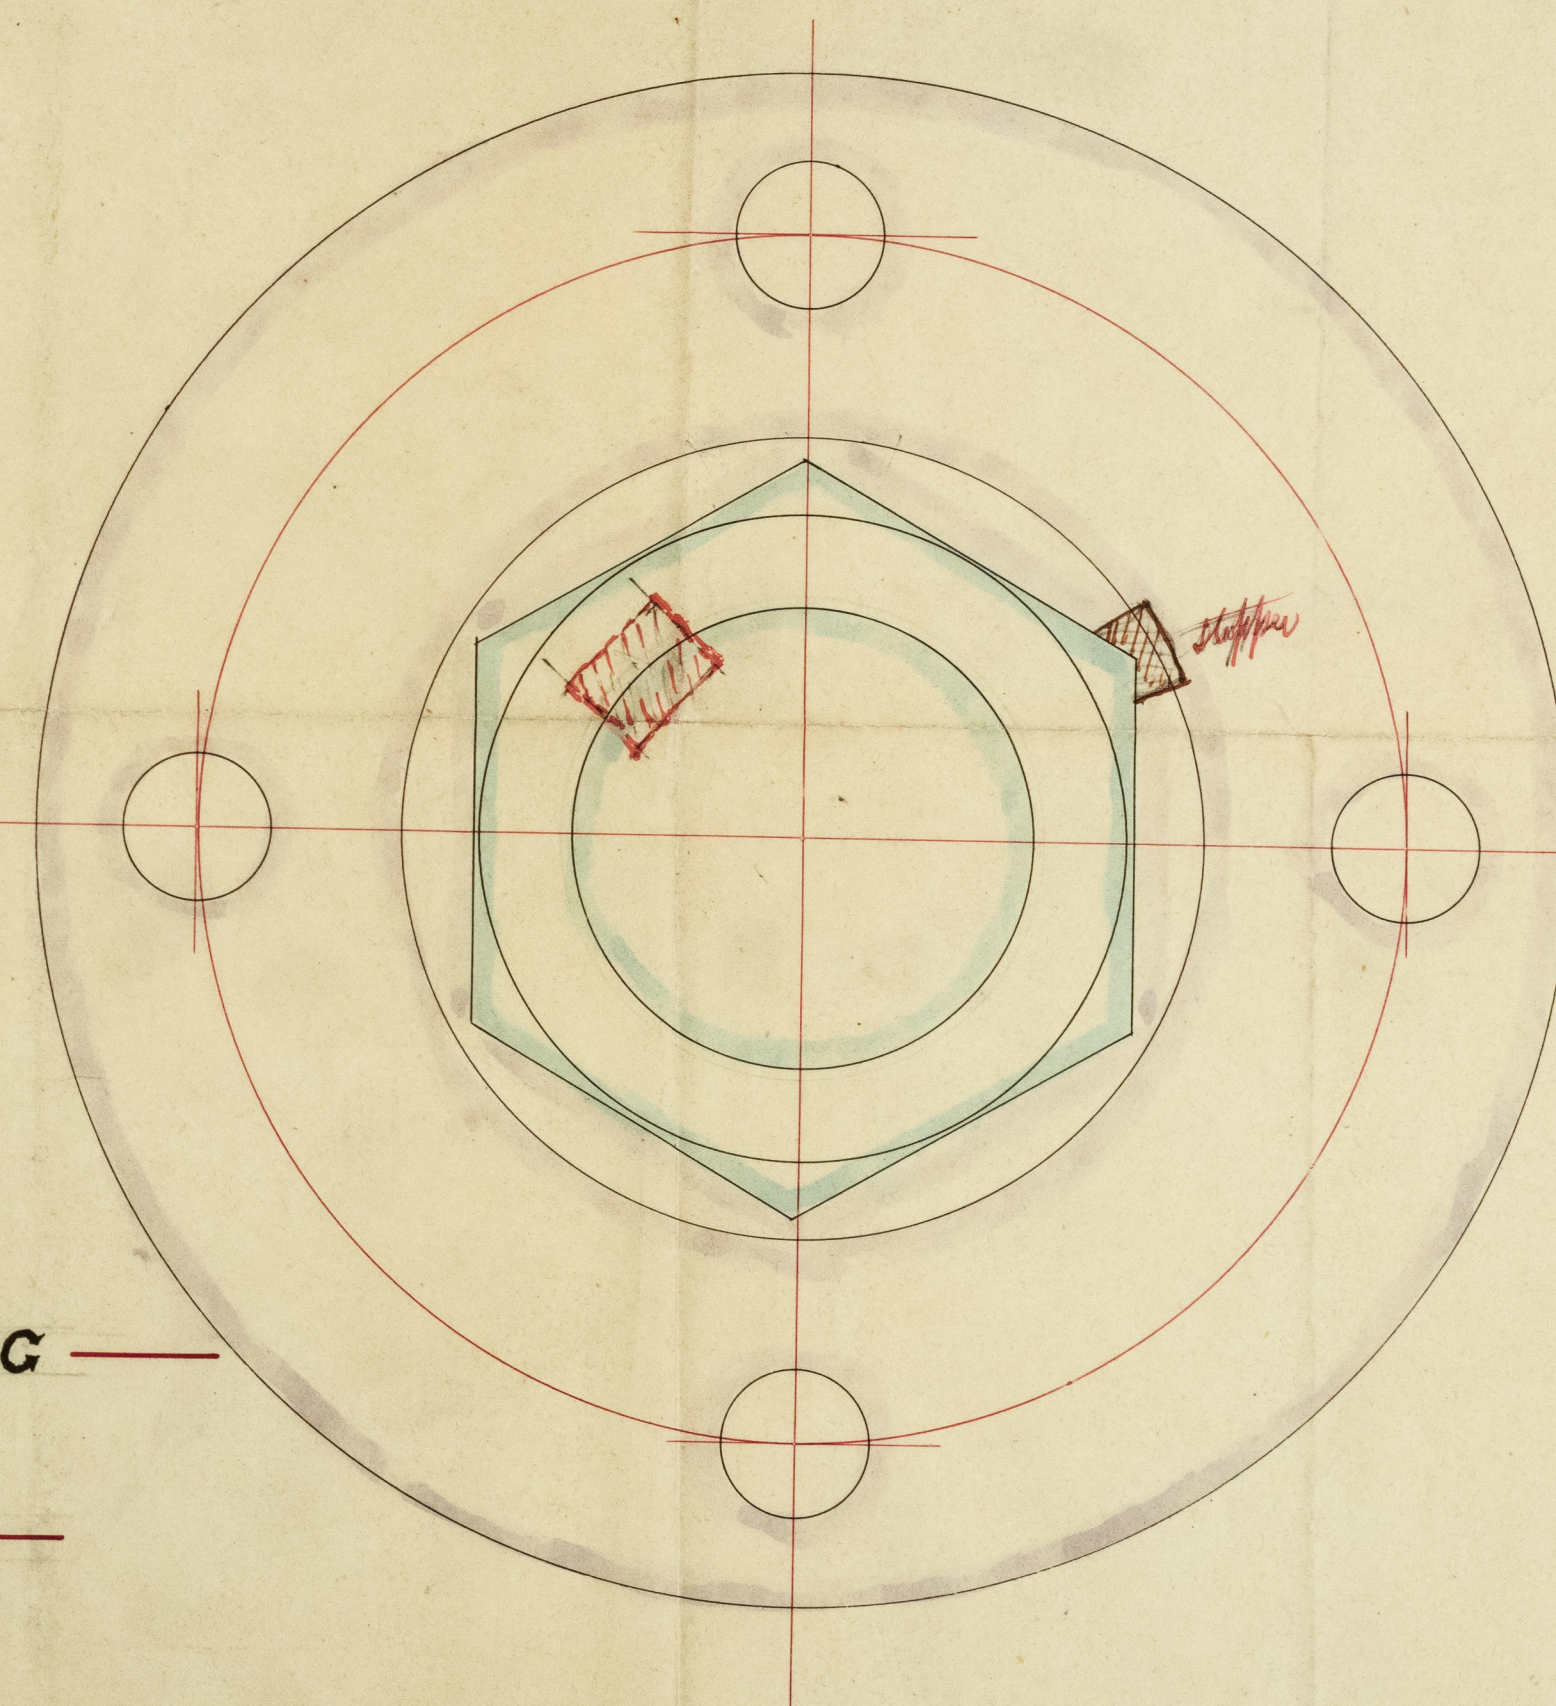

W.A.
17. 8. 91

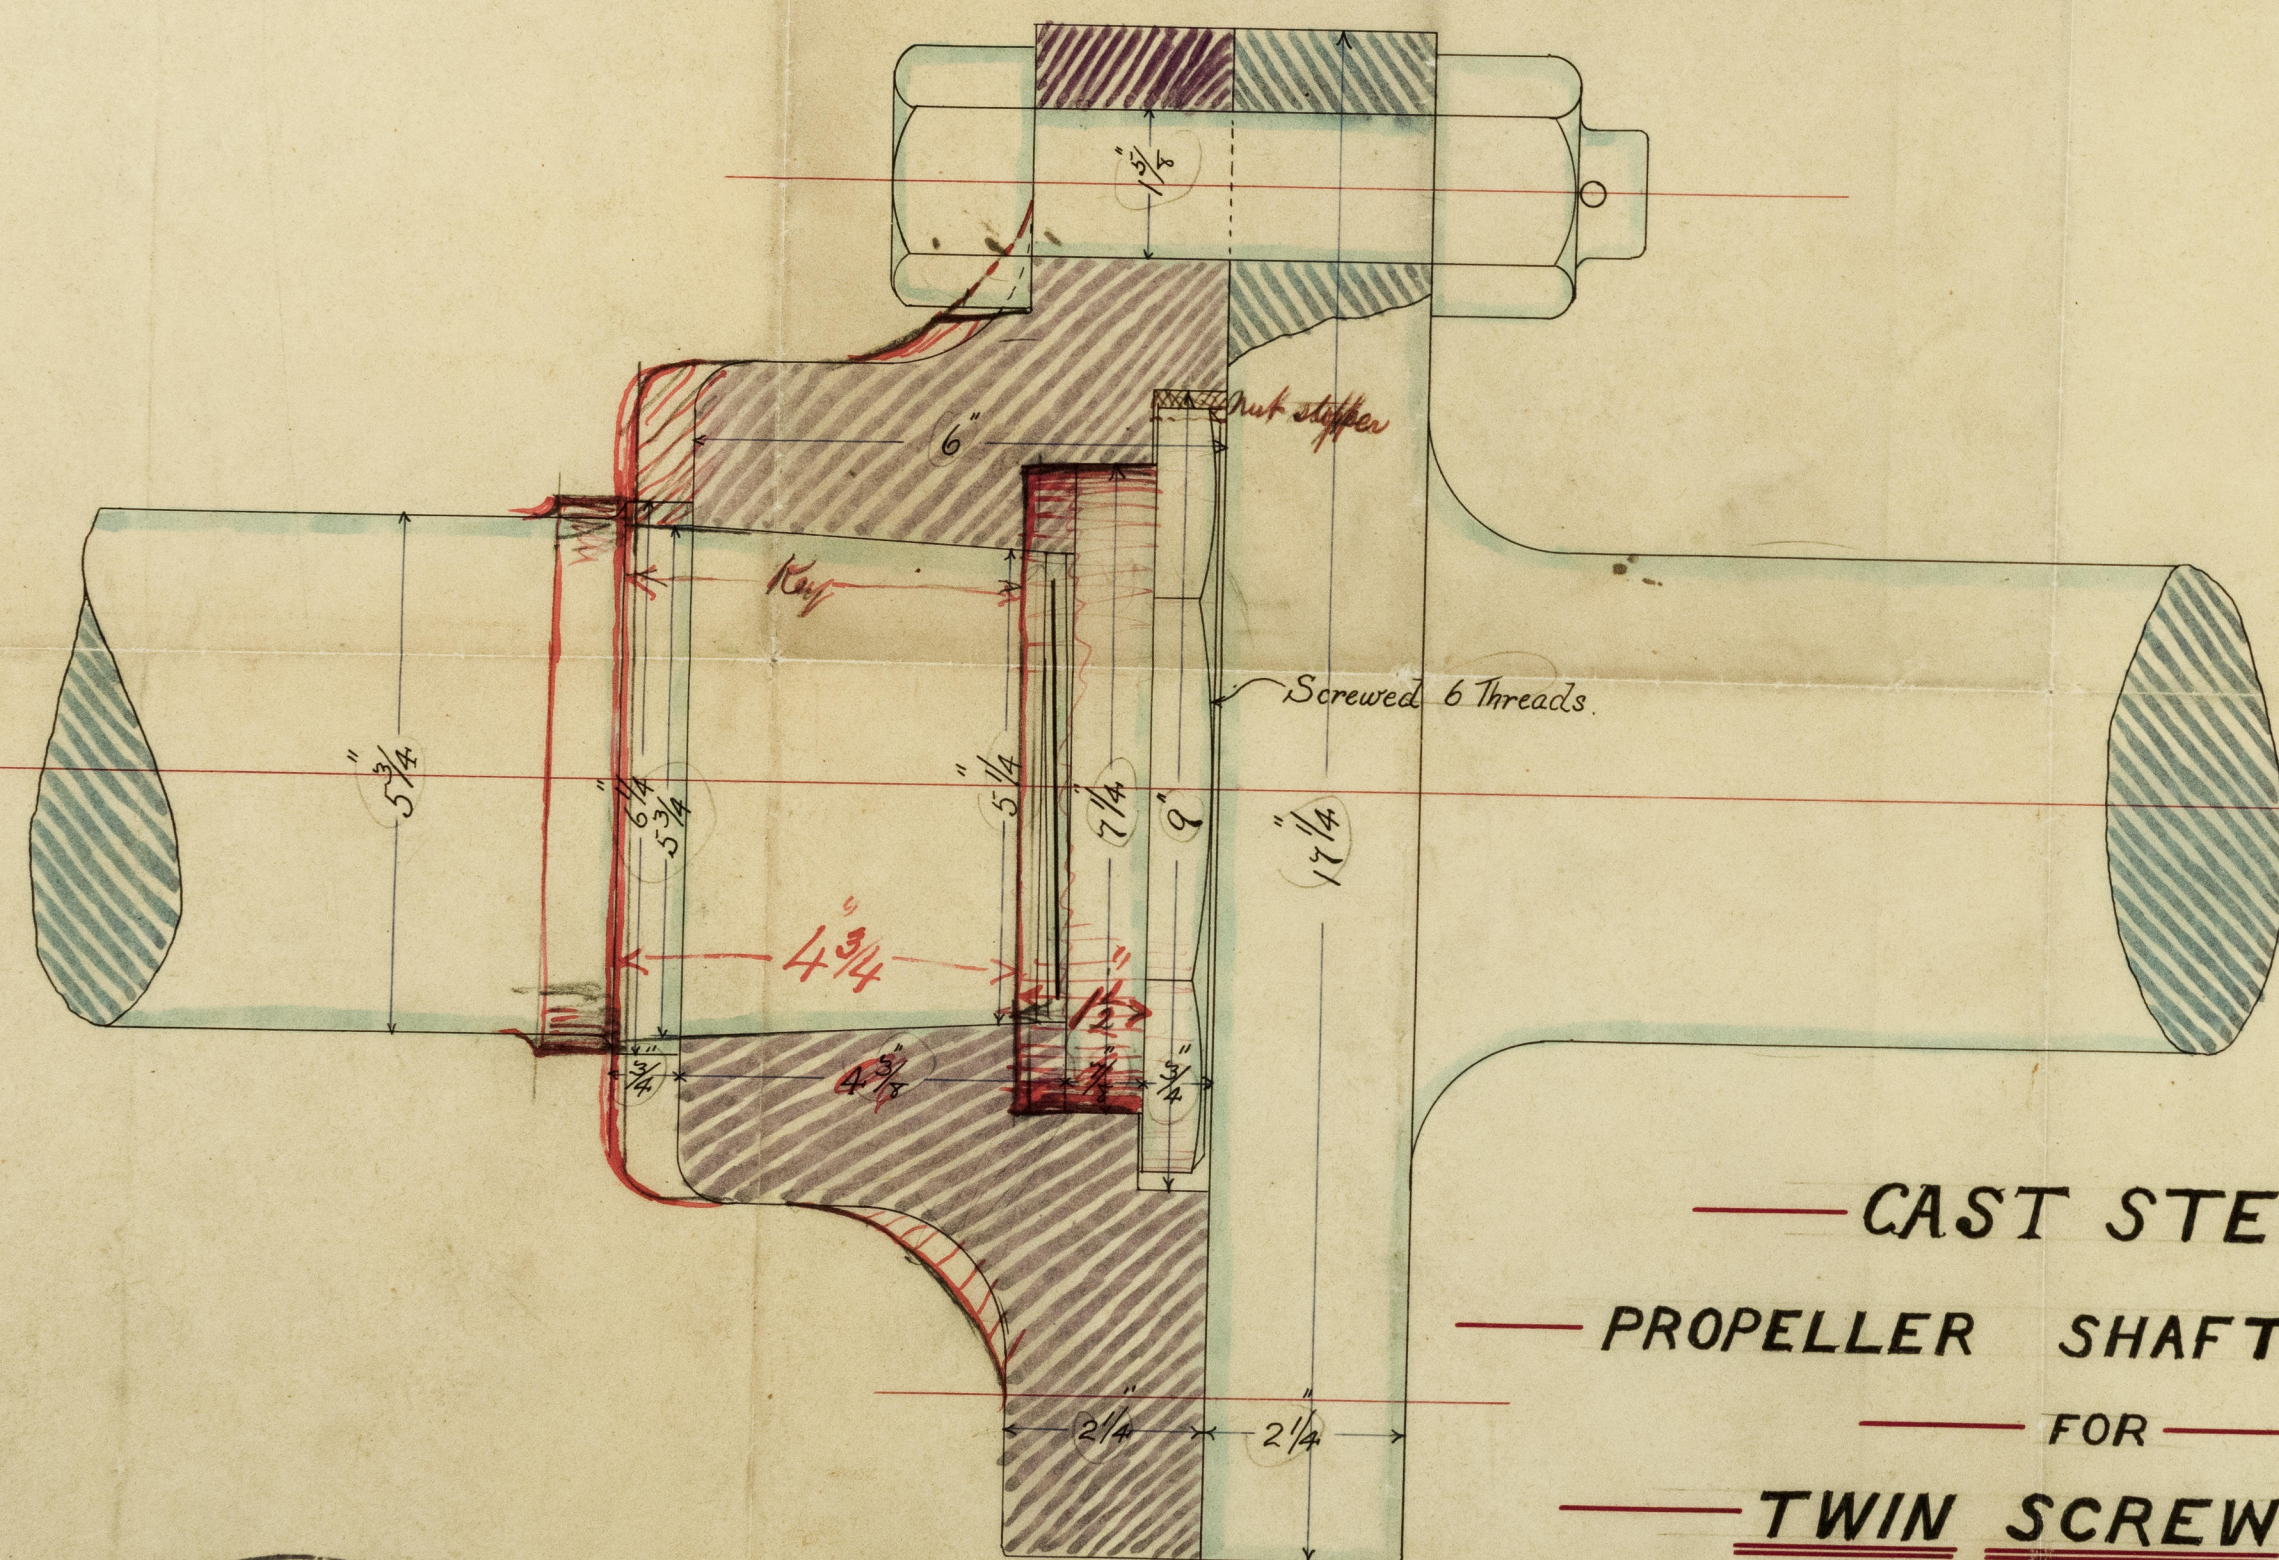