

CARDIFF.



S/S. "Albatros" - Report No. 234

SCREW STEAMER. N° 4.

To Class 100 A.

Scale 1/2 in - 1 foot.


Lt. to Cff
19/6/84 & 2/12/84.

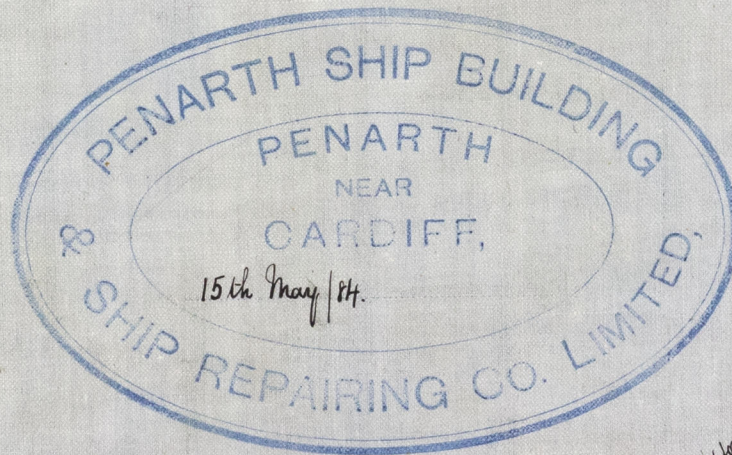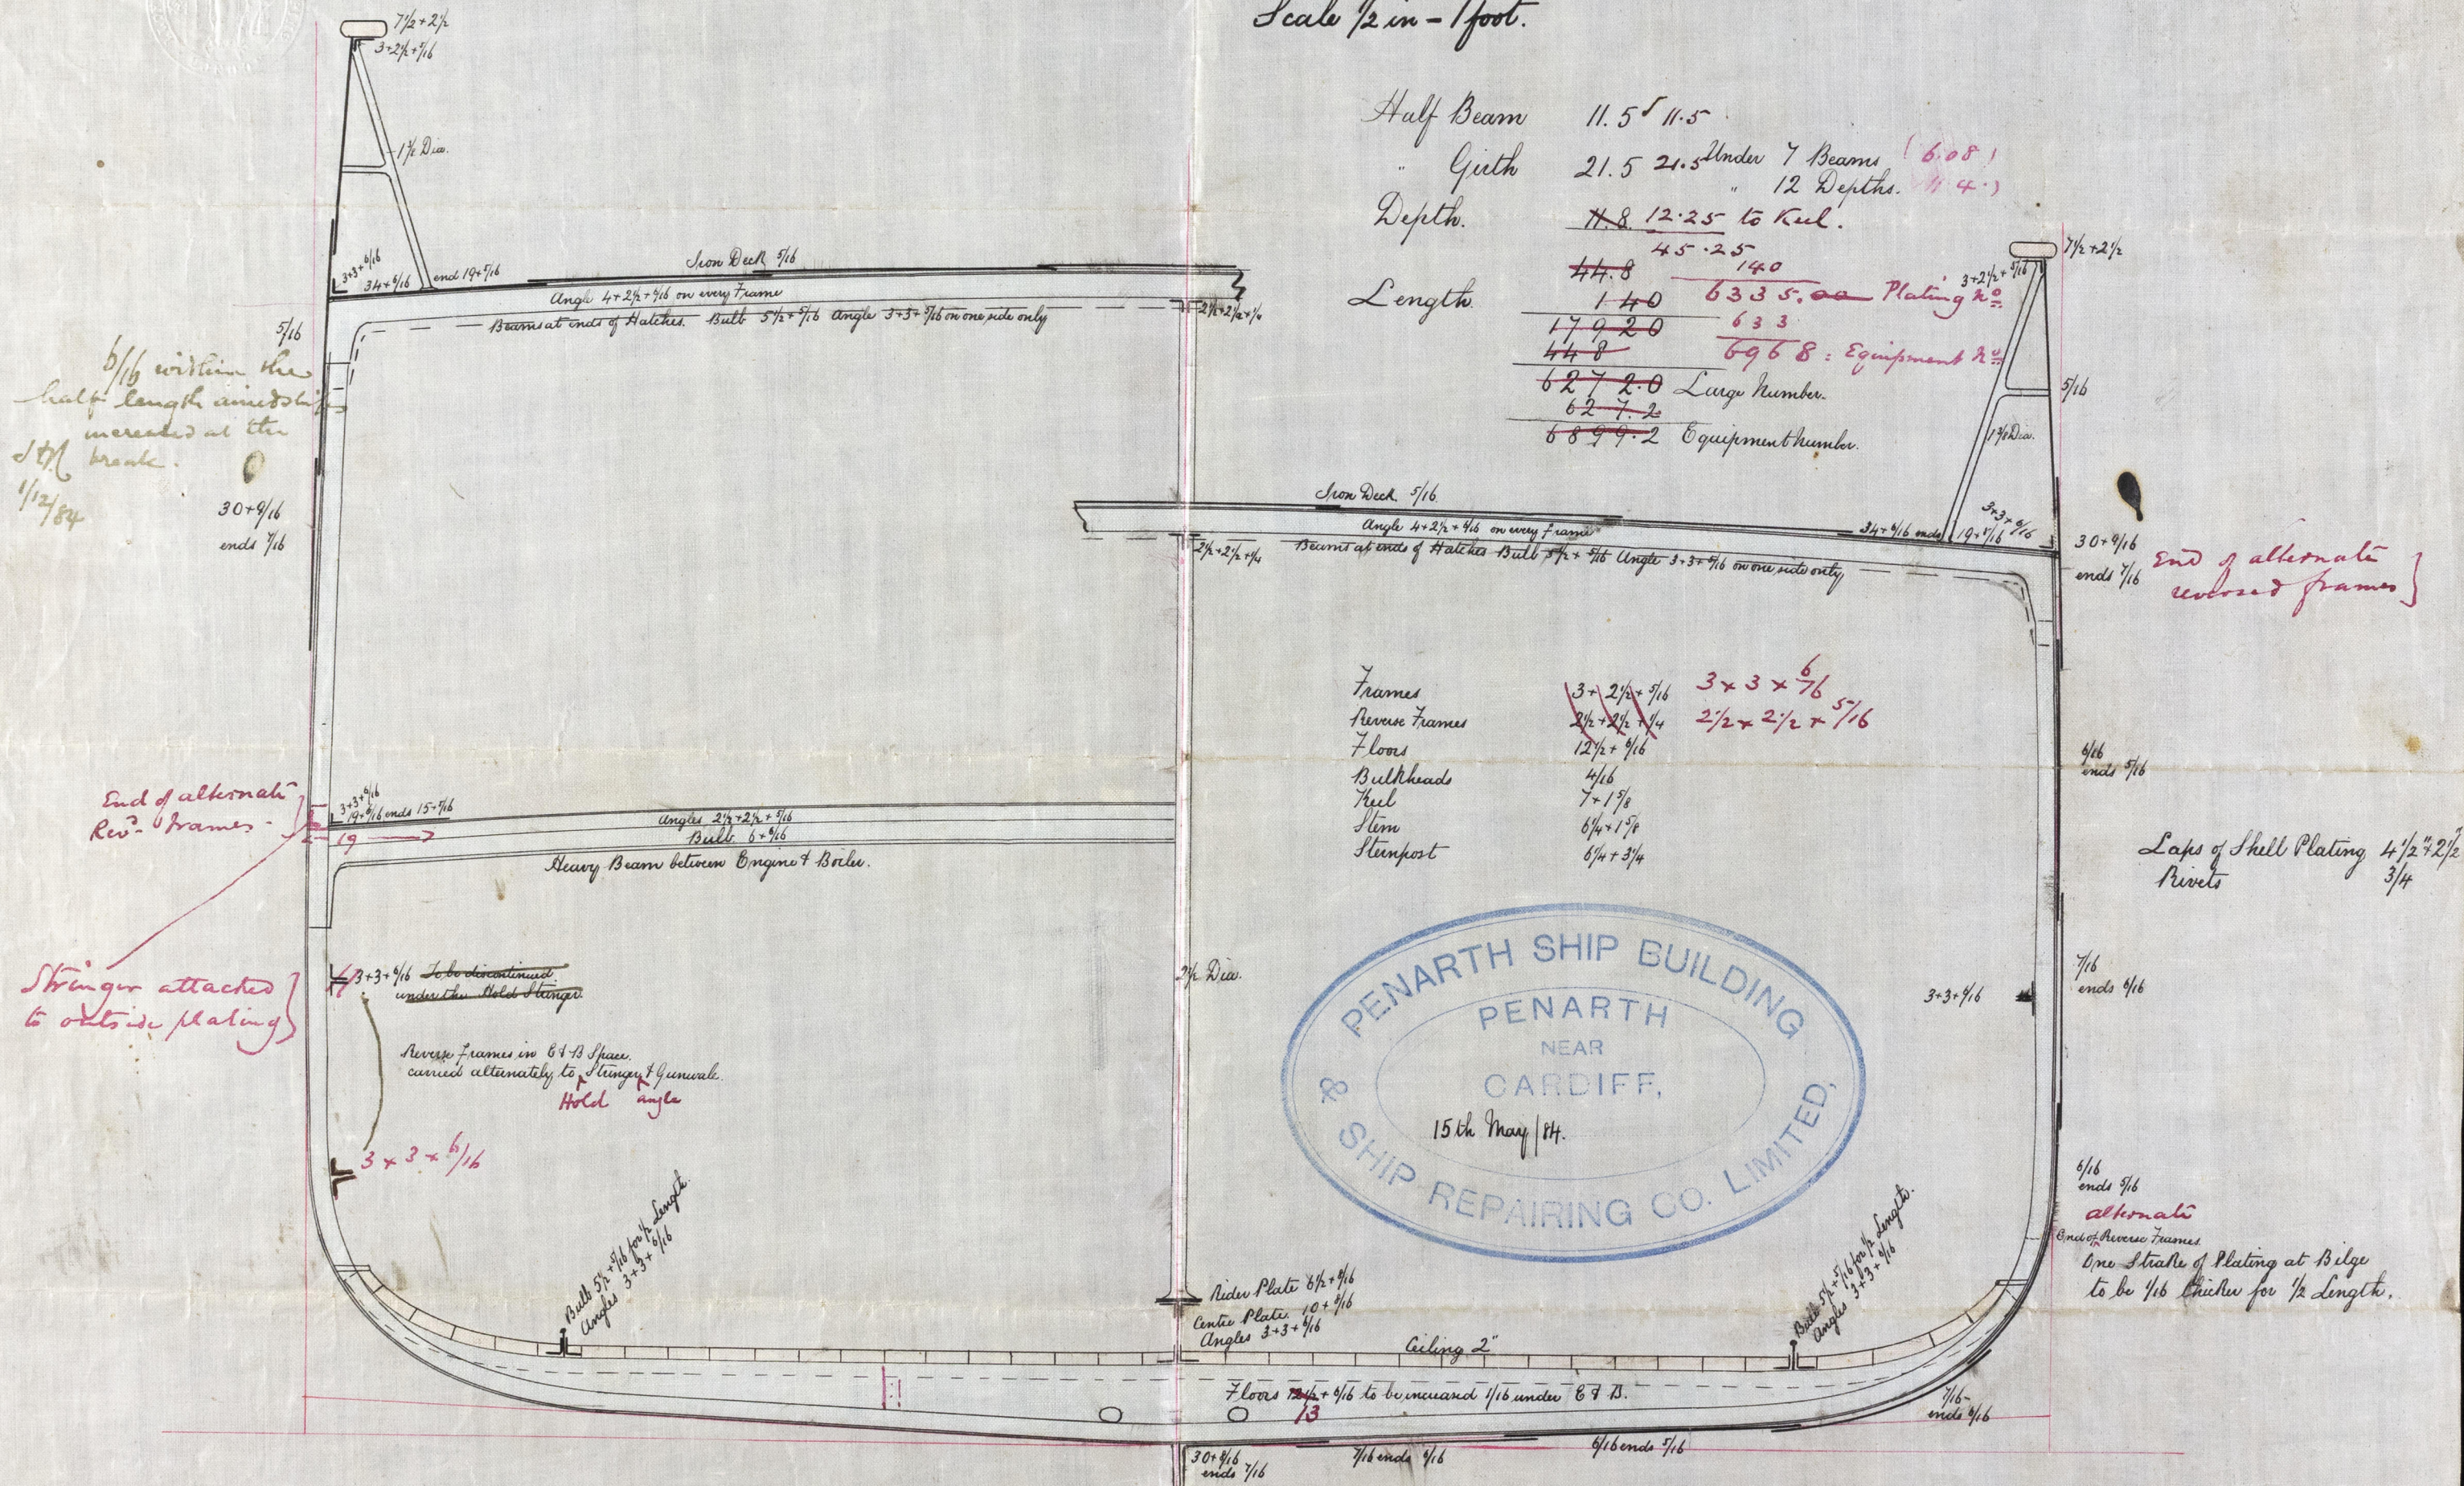

Lt. to Cff
29/7/84

19/6/84

This half of drawing is on card

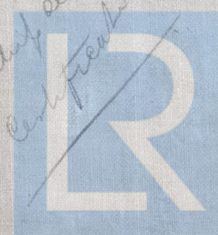

© 2019

Lloyd's Register Foundation

LRF-PUN-CFF83-0313