


L.R. to C.H.
19/8/84
2/12/84

CARDIFF.

S/S "Albarras" - Report No 21347

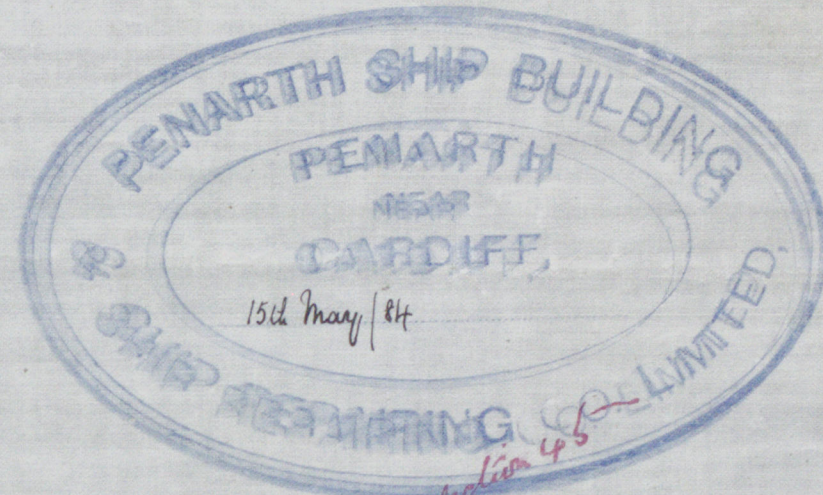

S.S. N° 4

Scale 1/4" = 1'

Masts made to Lower.

2" x 12" stringers extended under section 4 & 5
1/12/84

Line of Deck at Centre
Line of Deck at Side
Along beam above part of hull

Breadth of Hatch 9' 0"
Coamings 3' 0" above Deck

Breadth of Hatch 9' 0"
Coamings 3' 0" above Deck

E N G I N E

B O I L E R

Strengthened at hatch
as required by Sec. 45

Ballast Tank
Strengthened to the Surveyor's satisfaction.

L.R. to C.H.
19/7/84



© 2020

Lloyd's Register
Foundation

LRF-PUR-CFF23-0514