

Ditto of Forecastle
Gross Tonnage 341.36

1st Number, if a 3-Decked Vessel .. deduct 7 feet

Residence 15

S/s - "Albaros" -

Received at Office, 18

Lloyd's Register of British and Foreign Shipping.

(Report on Vessel No. 2347 Port CARDIFF.)

No. 167A. SHIP FORGINGS OR CASTINGS.

I have to report that the undermentioned Iron or Steel Forgings or Castings, manufactured by

Messrs C & H Reed & Co of Sunderland.

for the Vessel No. 4, being built by Messrs The Penarth S.B. Co, of Penarth have been inspected by me as set forth below, and found to be, so far as can be seen, sound and efficient.


J. G. Cameron.
Sunderland.

Mark on Forgings.

Lloyd's
No. 167A.
H.C.

	STERN FRAME.	RUDDER FRAME.	STEM.
Material*	Scrap Iron	Scrap Iron	/
How made	Forged	Forged	
Dimensions	6 1/4 x 3 1/4	3 3/4 x 2 1/4	
Progress on Inspection	Finished	Finished	
Dates when Inspected	Oct 3/84	Oct 3/84	

SKETCHES OF FRAMES SHEWING POSITION AND DESCRIPTION OF WELDS OF FORGINGS, OR PARTICULARS OF TESTS APPLIED TO CASTINGS.

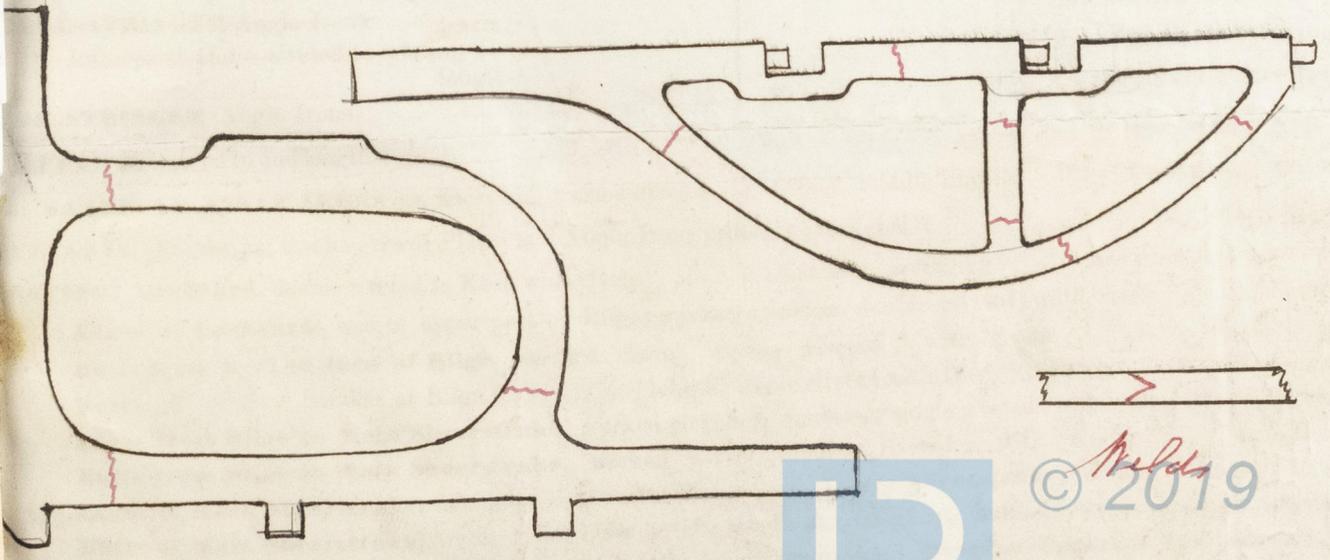

Welds
© 2019



Lloyd's Register
Foundation

1000—Mar./84—Trans. Ink.]

* If of Iron, state whether scrap or puddled Iron.

LRP-PUN-CFF83-0319

The above is a correct description. Surveyor's Signature, G. L. Hindmarsh