

S. S. Bardiff Bartle
S. S. "N° 8"

No. 5948-

SKETCH OF RUDDER.

SCALE: 1 INCH = 1 FOOT.

QUARTER DECK





COUNTER

$\frac{7}{8}$ " STEEL PLATE.

See letter
22/7/89

$\frac{3}{4}$ " STEEL PLATE.

STOPPER

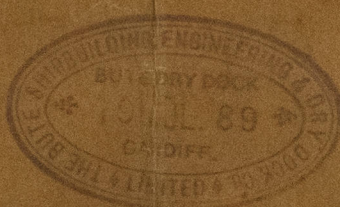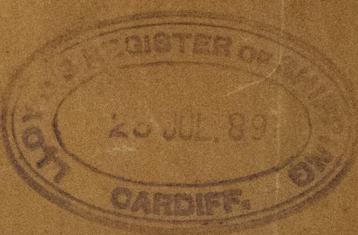

See letter
22/7/89



© 2021

Lloyd's Register
Foundation

12.7.89

LRF-POL-CEPH-0044