






S.S. No 8

S.S. "Cardiff Castle"


Profile shewing positions of Beams Web frames &c. &c.

Scale  $\frac{1}{8}$  = 1 Foot.

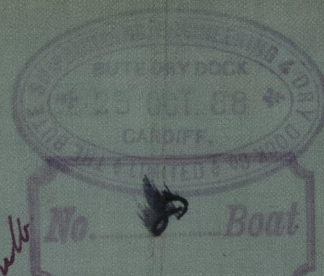

No.


5948

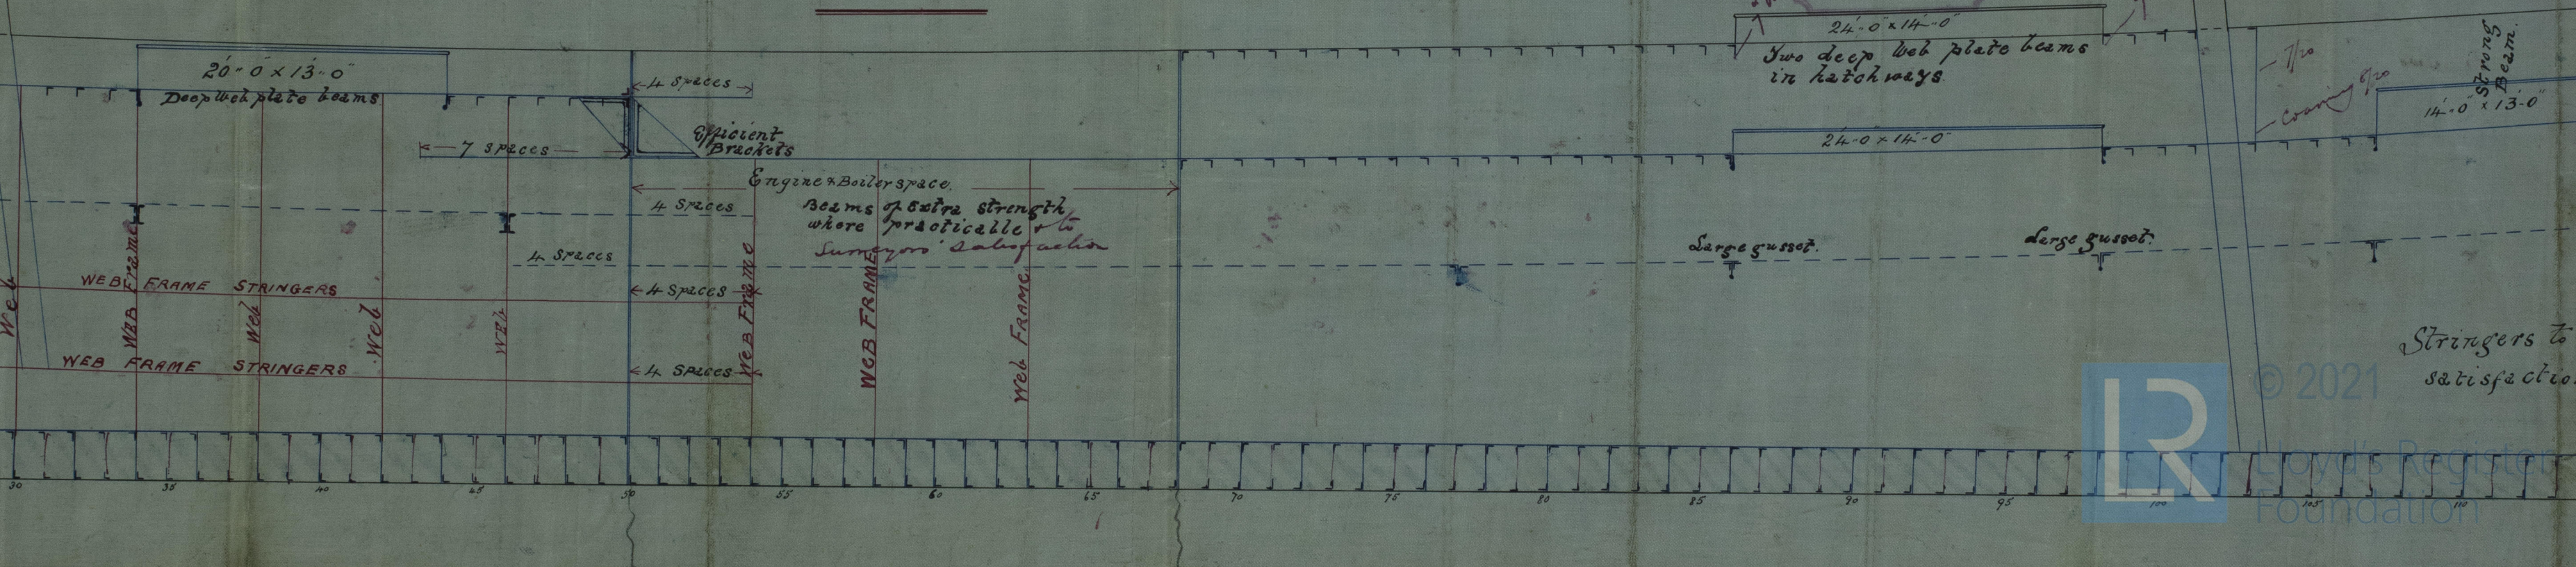



diff Cast 70

e.c.

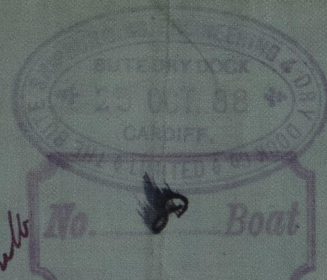

No: 5948

7" bulb

7" bulb

24'-0" x 14'-0"

Two deep web plate beams in hatchways.

24'-0" x 14'-0"

- 7/10

- Coaming 9/20

Strong Beam.

14'-0" x 13'-0"

7" Bulb beams under windows


Large gusset.

Large gusset.

Stringers to Surveyors satisfaction.

Pending arrangement to satisfaction of surveyors.

Sho to Plans  
30.10.88.

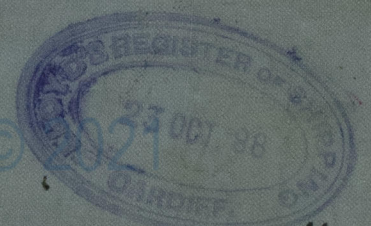

Lloyd's Register Foundation

LRF-PUN-LFF84-0046.



"Cardiff Castle"

# Cardiff South



© 2021

Lloyd's Register  
Foundation