

S. S. No. 9 ————— Mayfield No. 6954

Midship Section of Steel Screw Steamer
Class 100 A.I. Lloyd's
On Longitudinal Double Bottom Principle.
Scale 1/2 inch = 1 foot

THU 10 JAN 89

Principal Dimensions

Length as per Rule ——— 298.5
 Half Girth ——— 39.6
 Half Breadth ——— 19.3
 Depth ——— 24.0
 Small Tonnage = 82.6
 Large ——— 247.6
 Cubic ——— 2746.0


Proportions

Depth to Length = 12.43
 Breadth ——— 7.7

Anchors & Cables.

- | | |
|-------------------------------------|----------------------|
| 1 Bower Anchor 42 1/2 cwt. | } Stockless Anchors. |
| 1 ——— 42 1/2 — | |
| 1 ——— 36 1/4 — | |
| 1 Stream ——— 10 3/4 — | ex. stock. |
| 1 Hedge ——— 5 1/2 — | |
| 1 ——— 2 1/2 — | |
| 270 Fathoms 1 1/2" Stud chain cable | |
| 75 ——— 1 1/2" Stream chain, or | |
| 75 ——— 4 1/2" Steel wire. | |
| Hawseers & straps as per rule | |

Lower Deck.

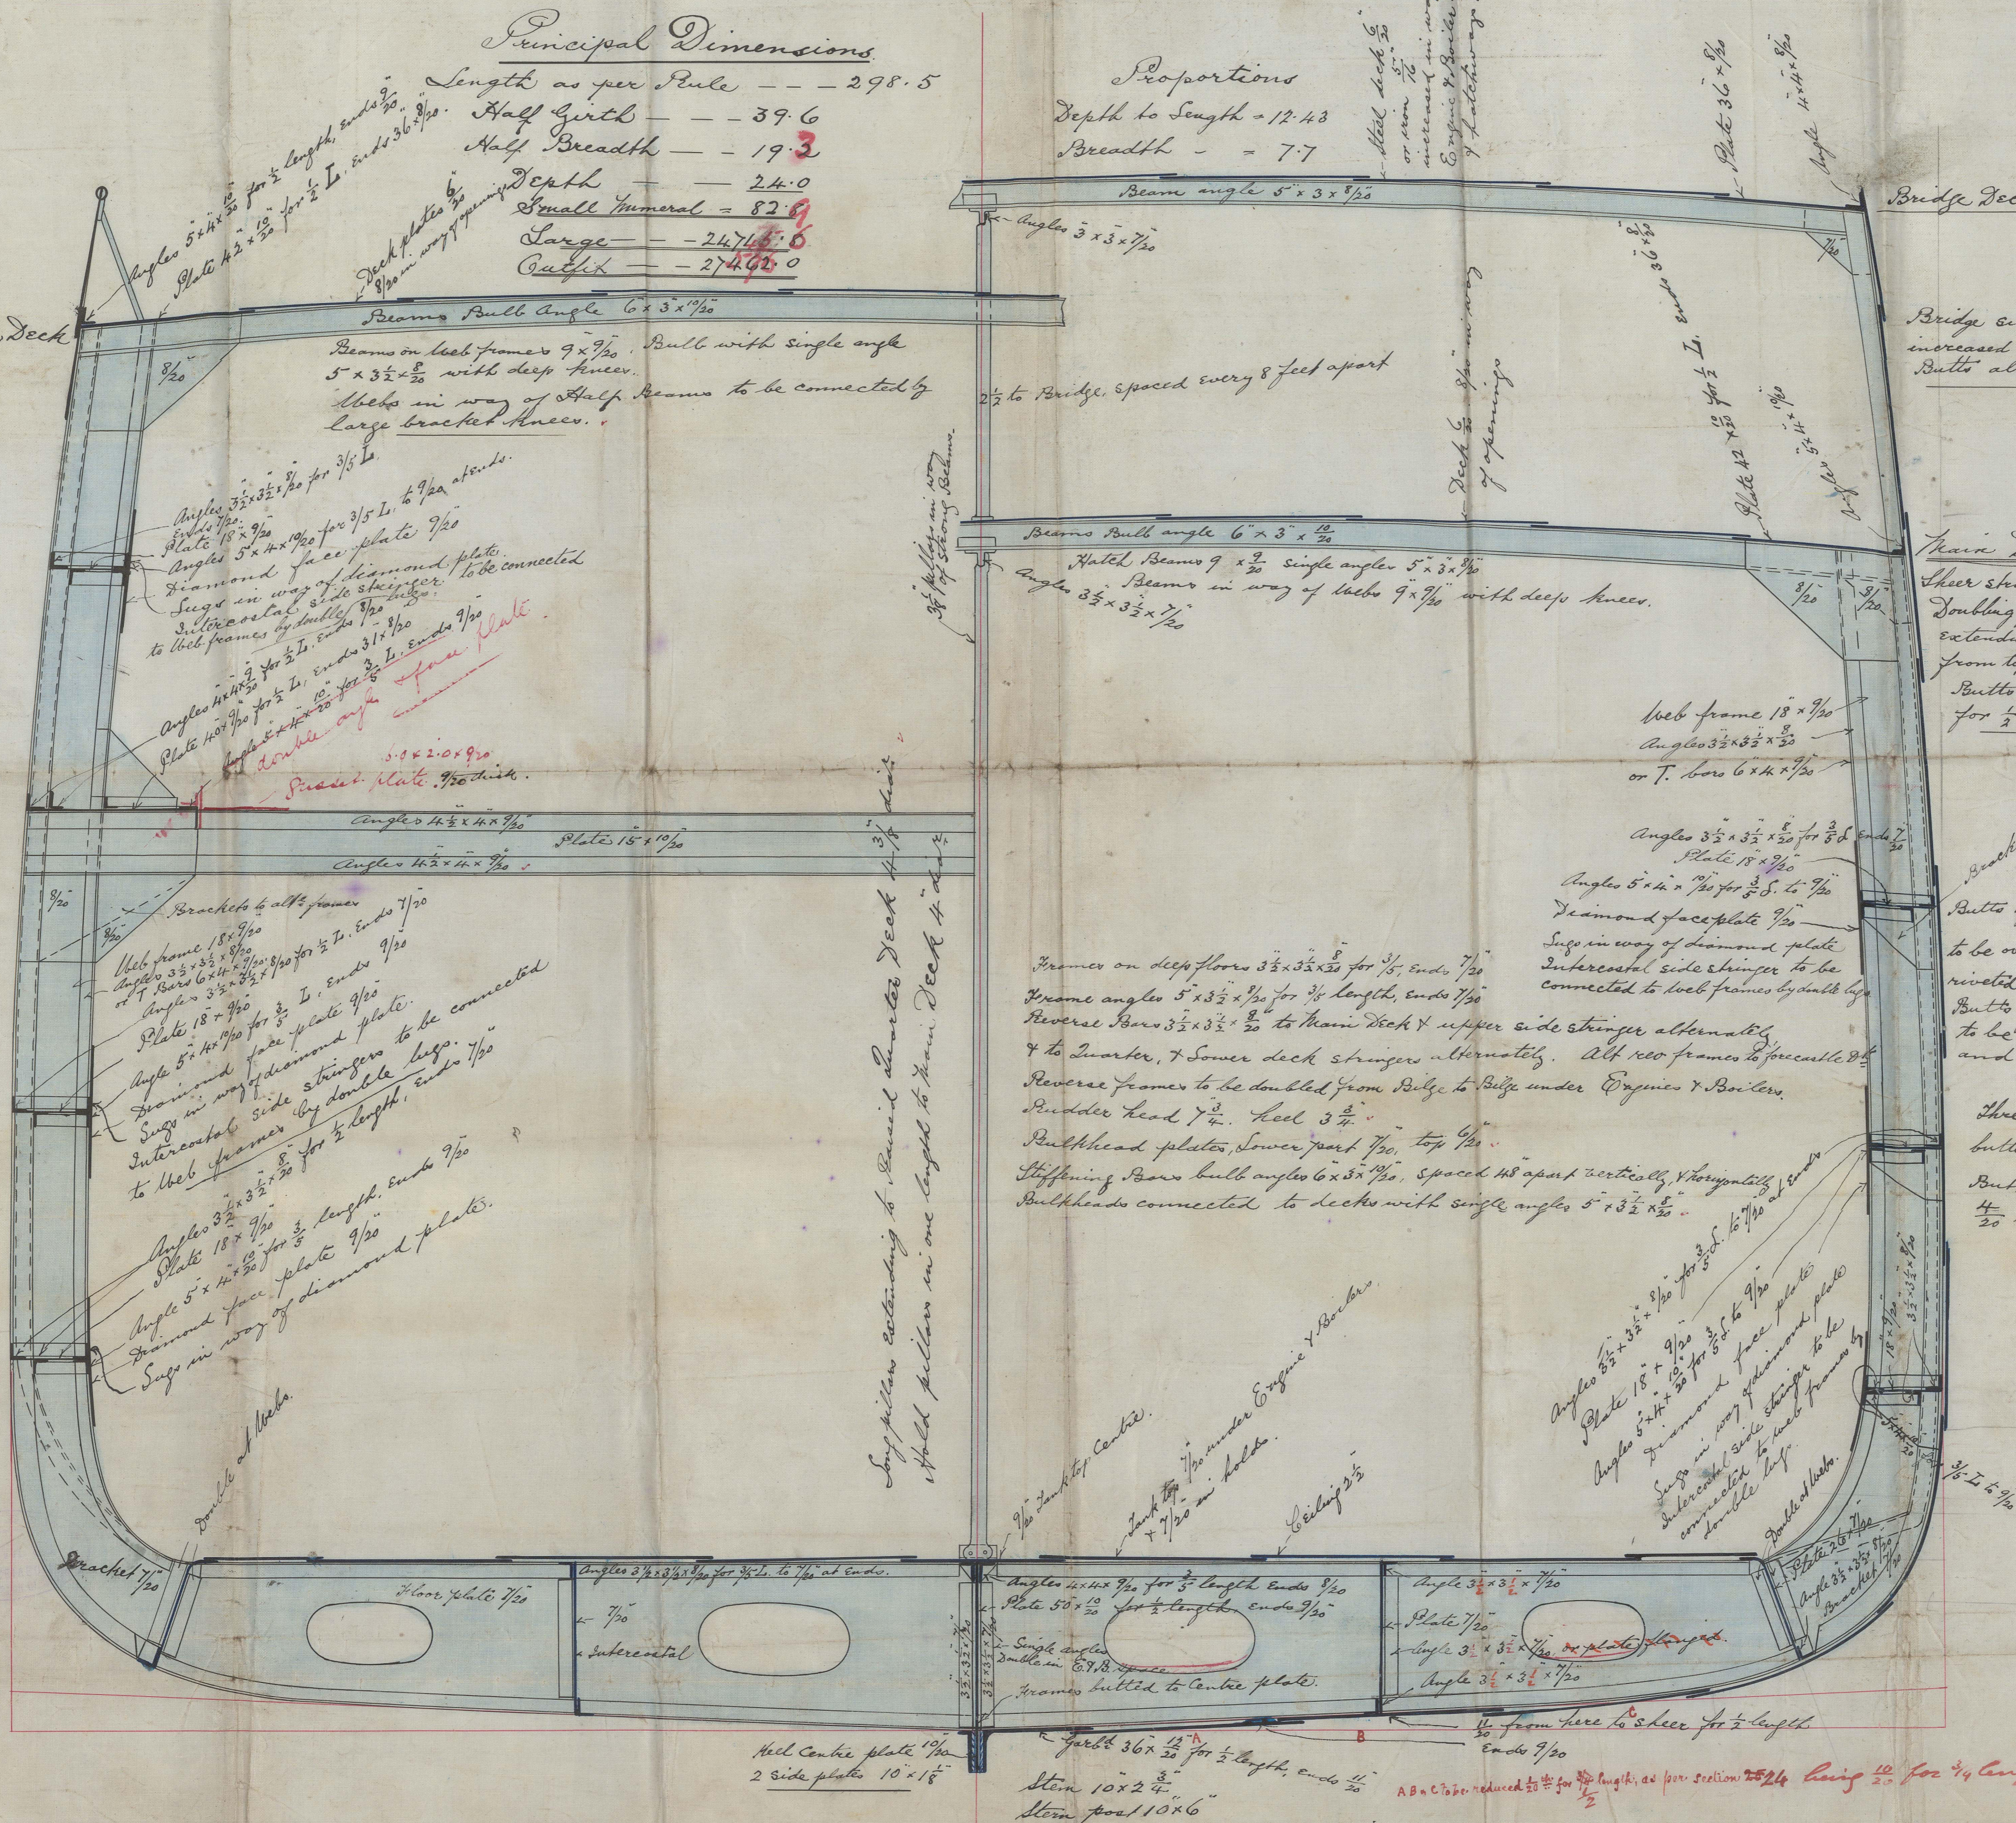

See to B.D. 11.1.89





W.H.C.

L.R. 100-1000-0006

© 2021

Lloyd's Register Foundation

S. S. Mayfield
Mudskip Section
Cardiff 1954

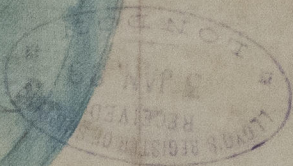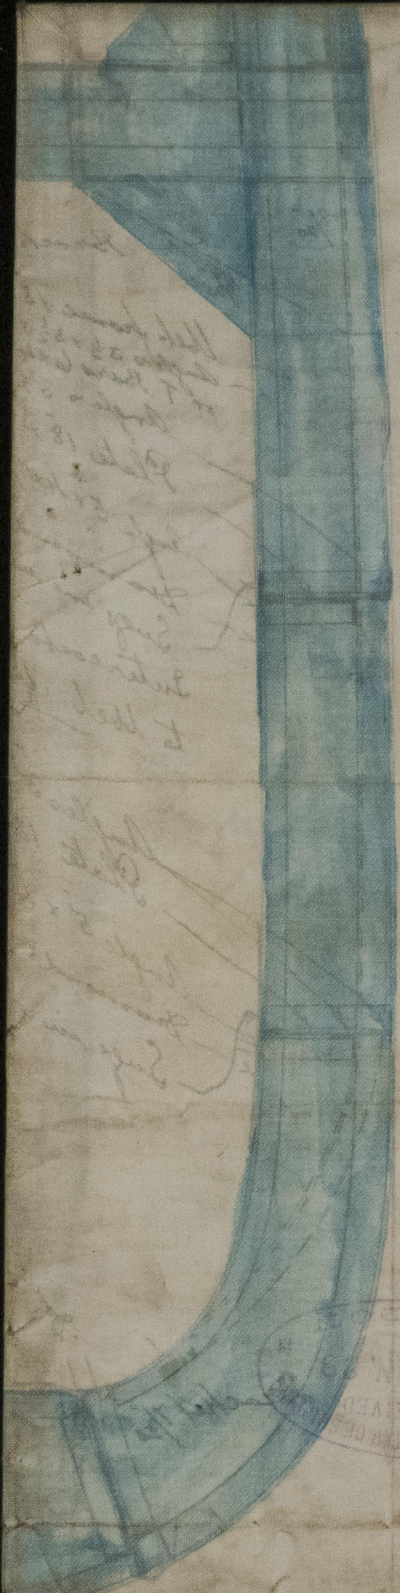

© 2021

Lloyd's Register
Foundation