
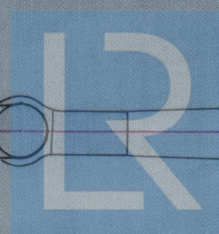


S.S. "Mayfield" CARDIFF No. 6984  
Sketch of Rudder & Stern Frame

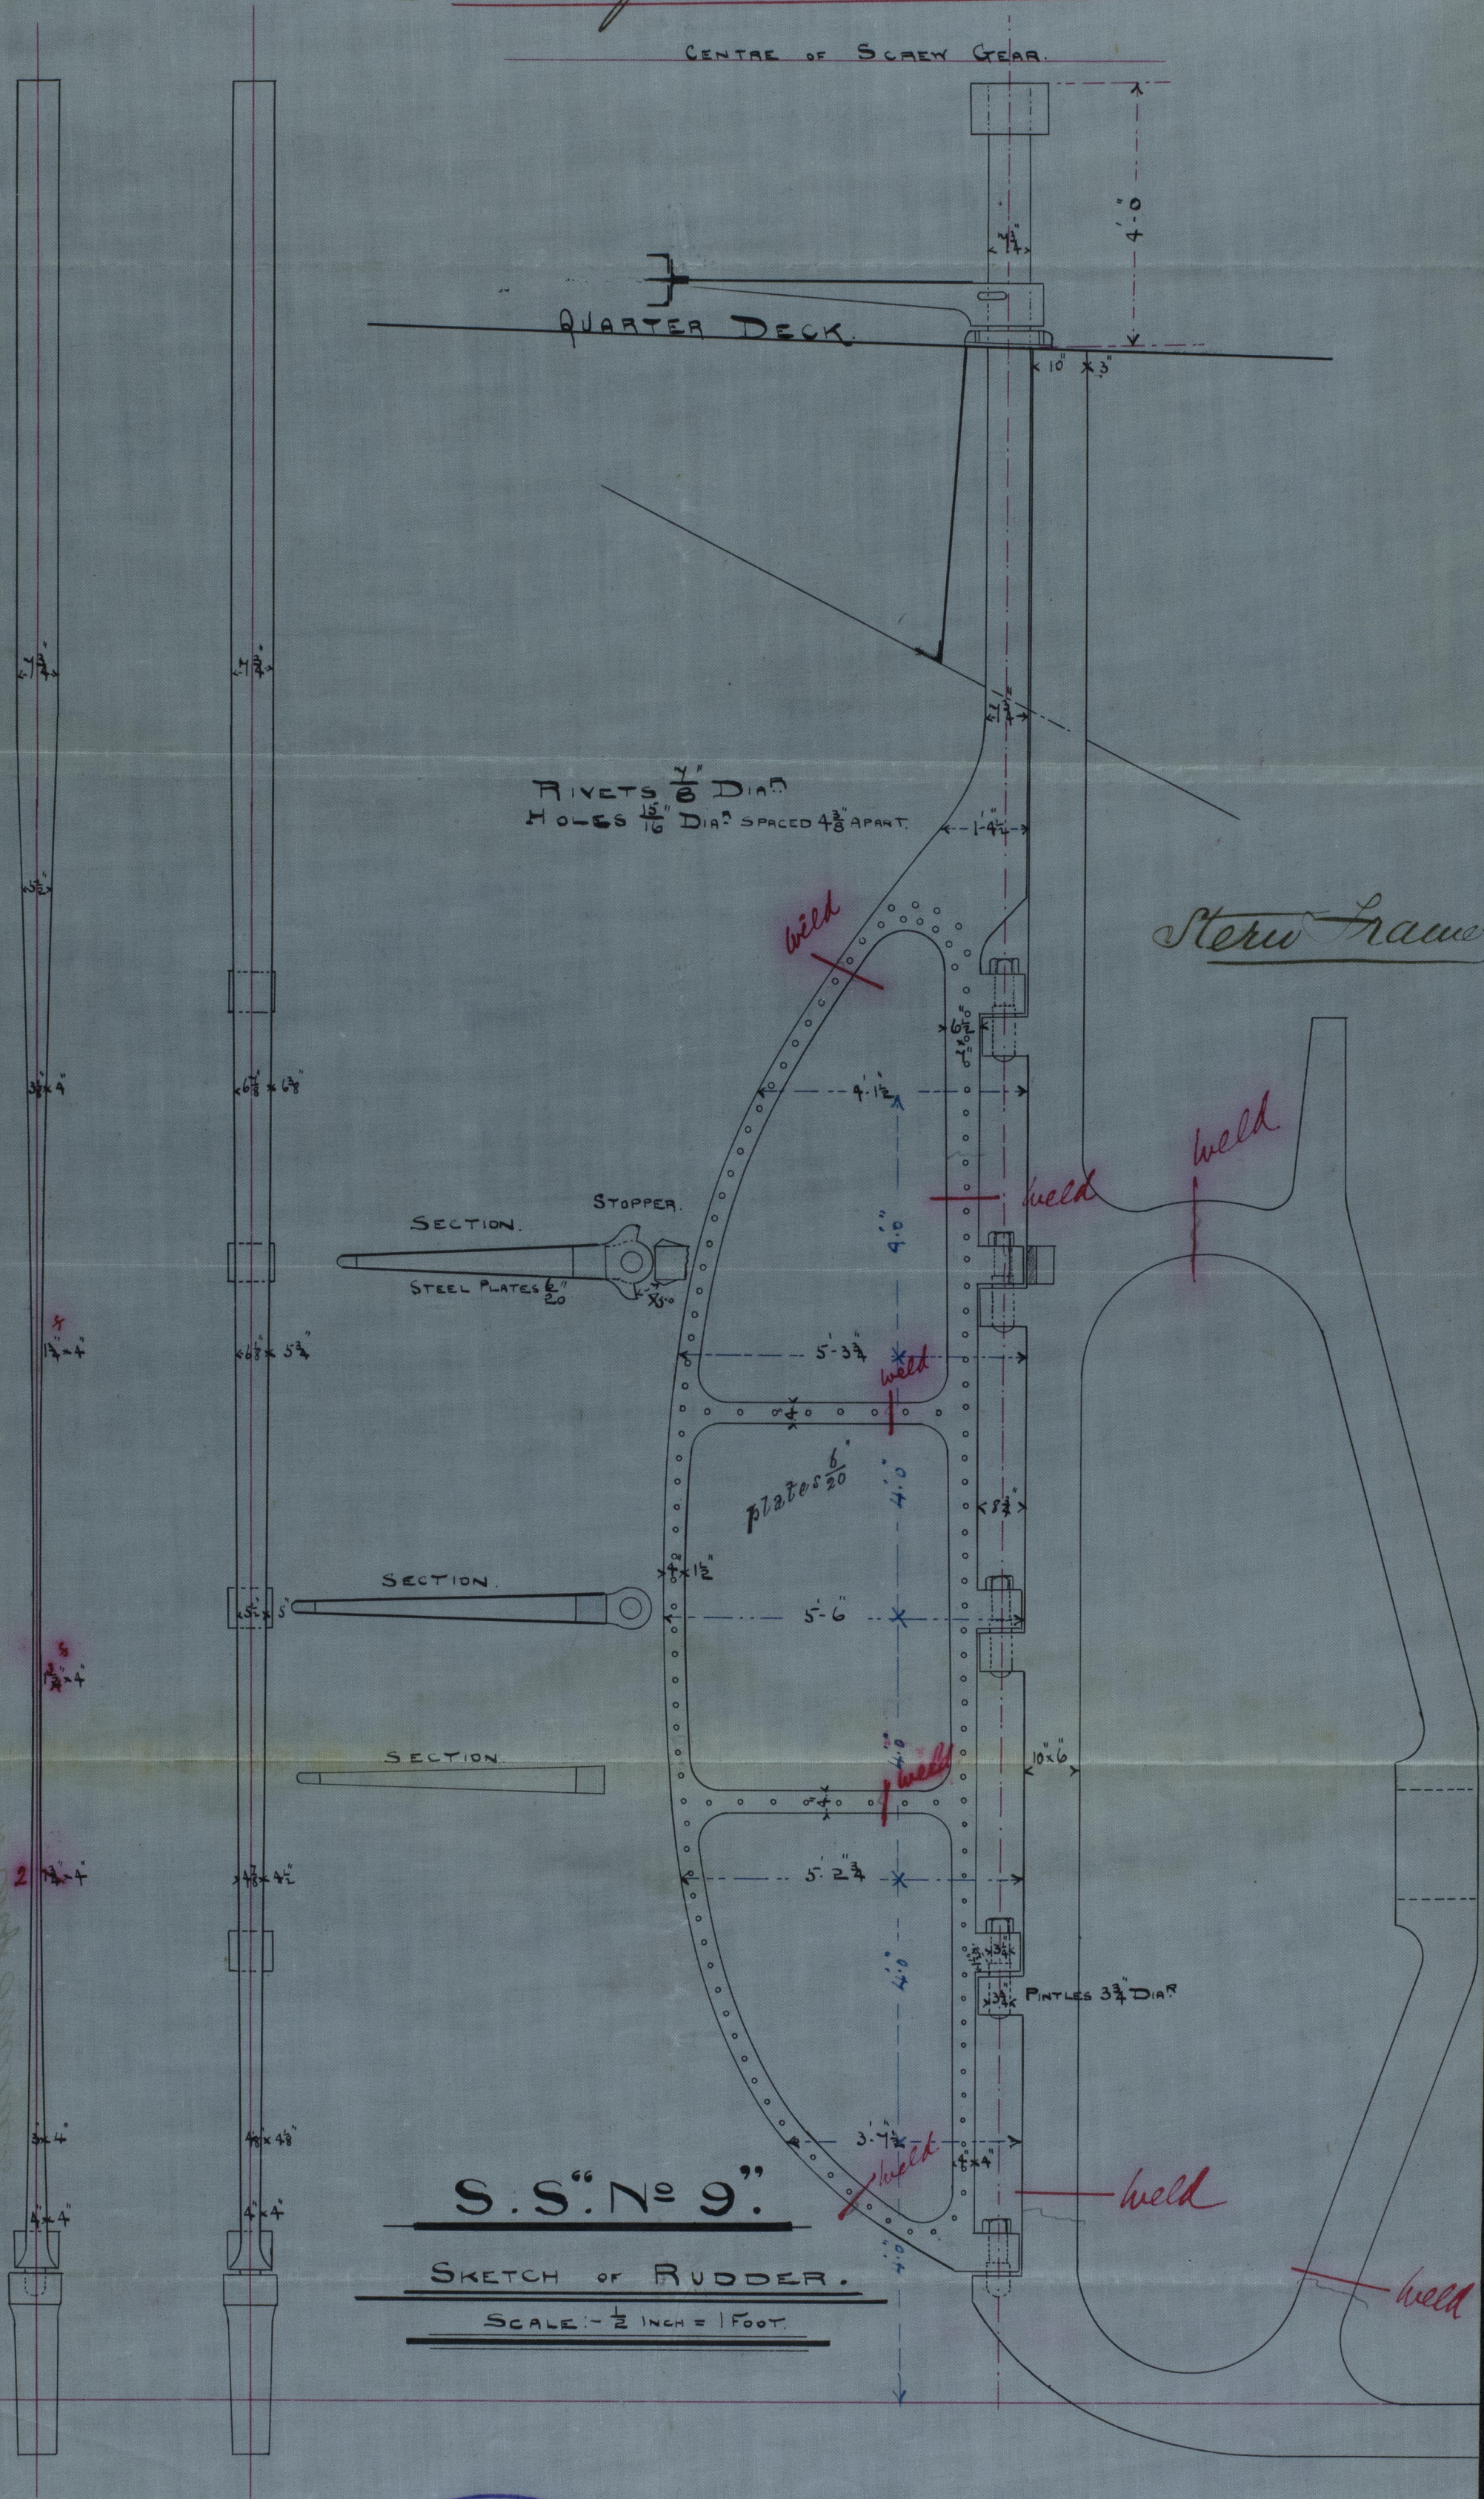

© 2019

Lloyd's Register  
 Foundation

LRF-PUN-LEFSA-0087