

SAT 2 FEB 80

Seams Double Riveted

Butts double riveted below partners and triple riveted above partners
Doubling plate in way of
lodging Deck 5 feet

if butts are dropped the triple rivets
drop to be $\frac{3}{16}$ thicker than plates




Sketch of Lower Masts — Mayfield

S.S. No. 9.


Scale $\frac{1}{2}$ " = 1 foot.

Fore Mast

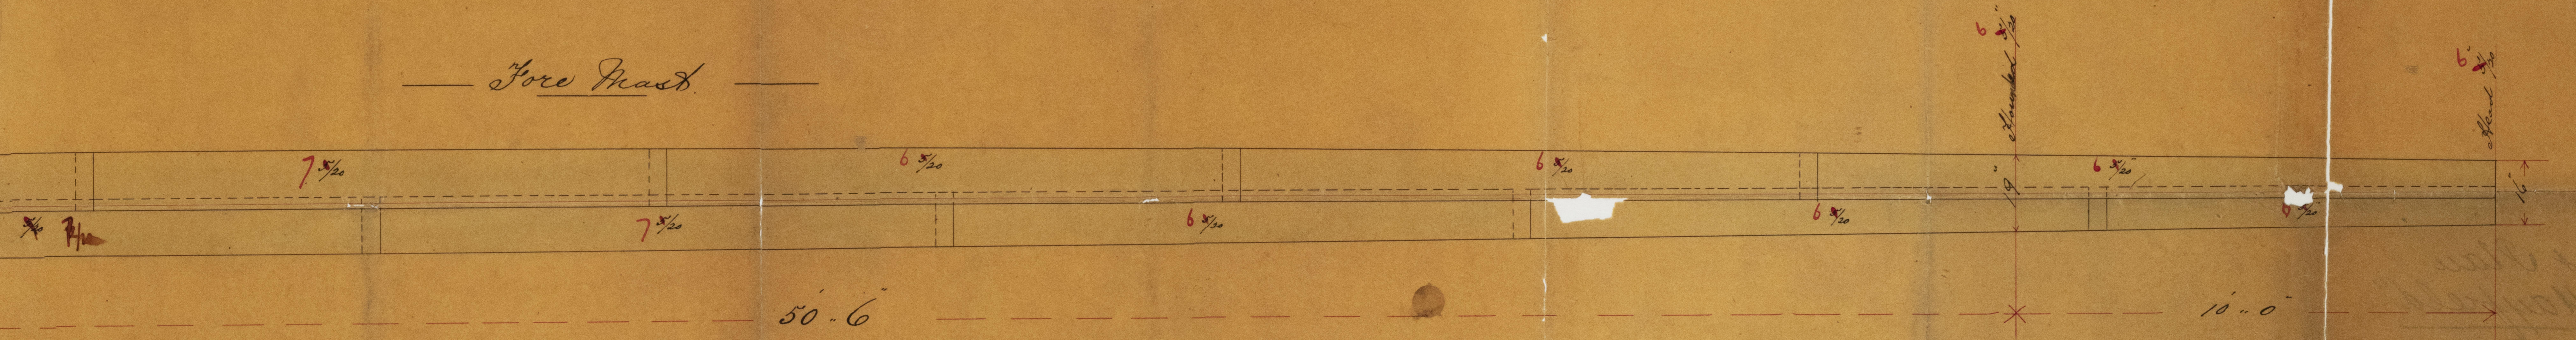

Length Extreme 80'-6"

Main Mast

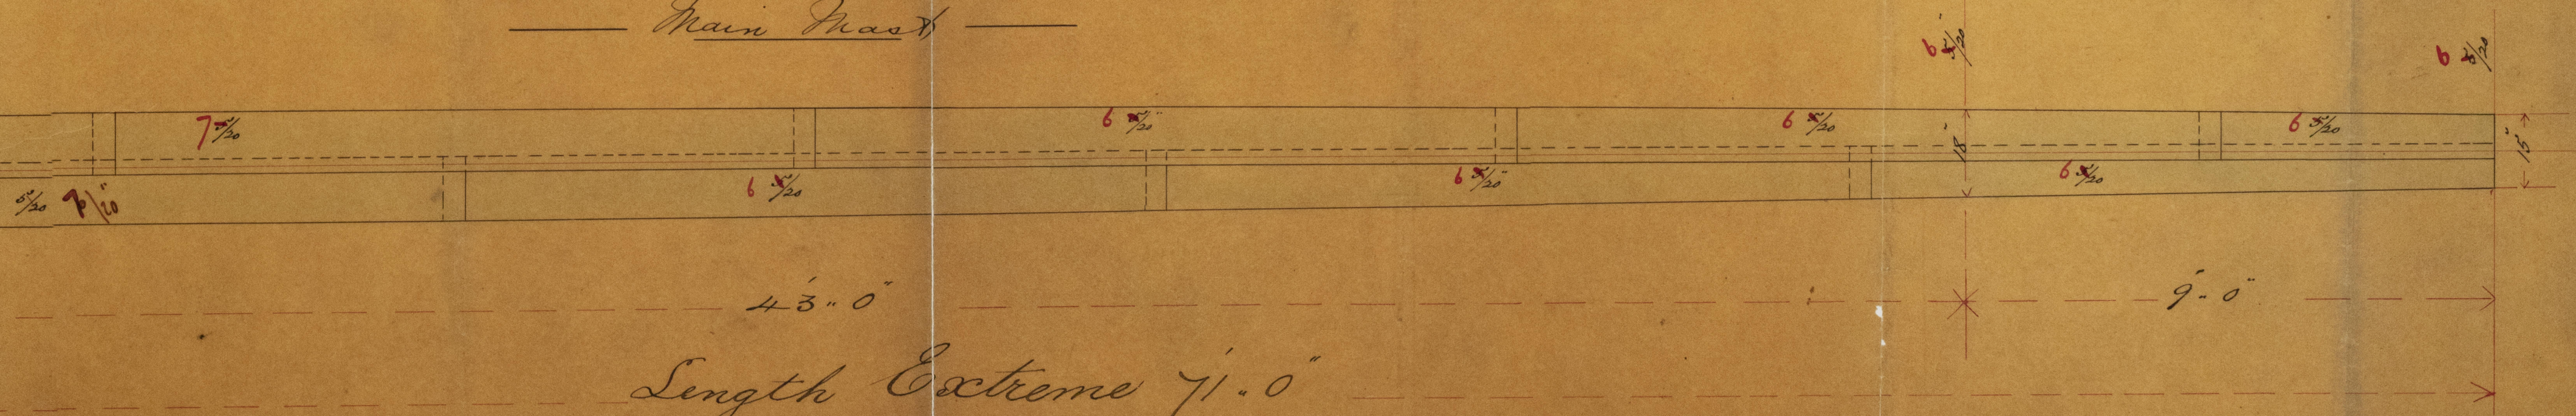

Length Extreme 71'-0"

