


S.S. "Laughton"  
No. 9277

18 New top plates  $\frac{3}{8}$ " thick  
3 " doubling plates  $\frac{7}{8}$ " "  
8 " floor "  $\frac{1}{2}$ " "  
18 " Interostal "  $\frac{1}{2}$ " "  
Interostal a. to floors  $3\frac{1}{2} \times 3\frac{1}{2} \times \frac{1}{2}$ "  
" " " Shell  $4 \times 3 \times \frac{1}{2}$ "  
5 plates off the bottom each side  
to effect repairs  
Gunk top plates top painted.

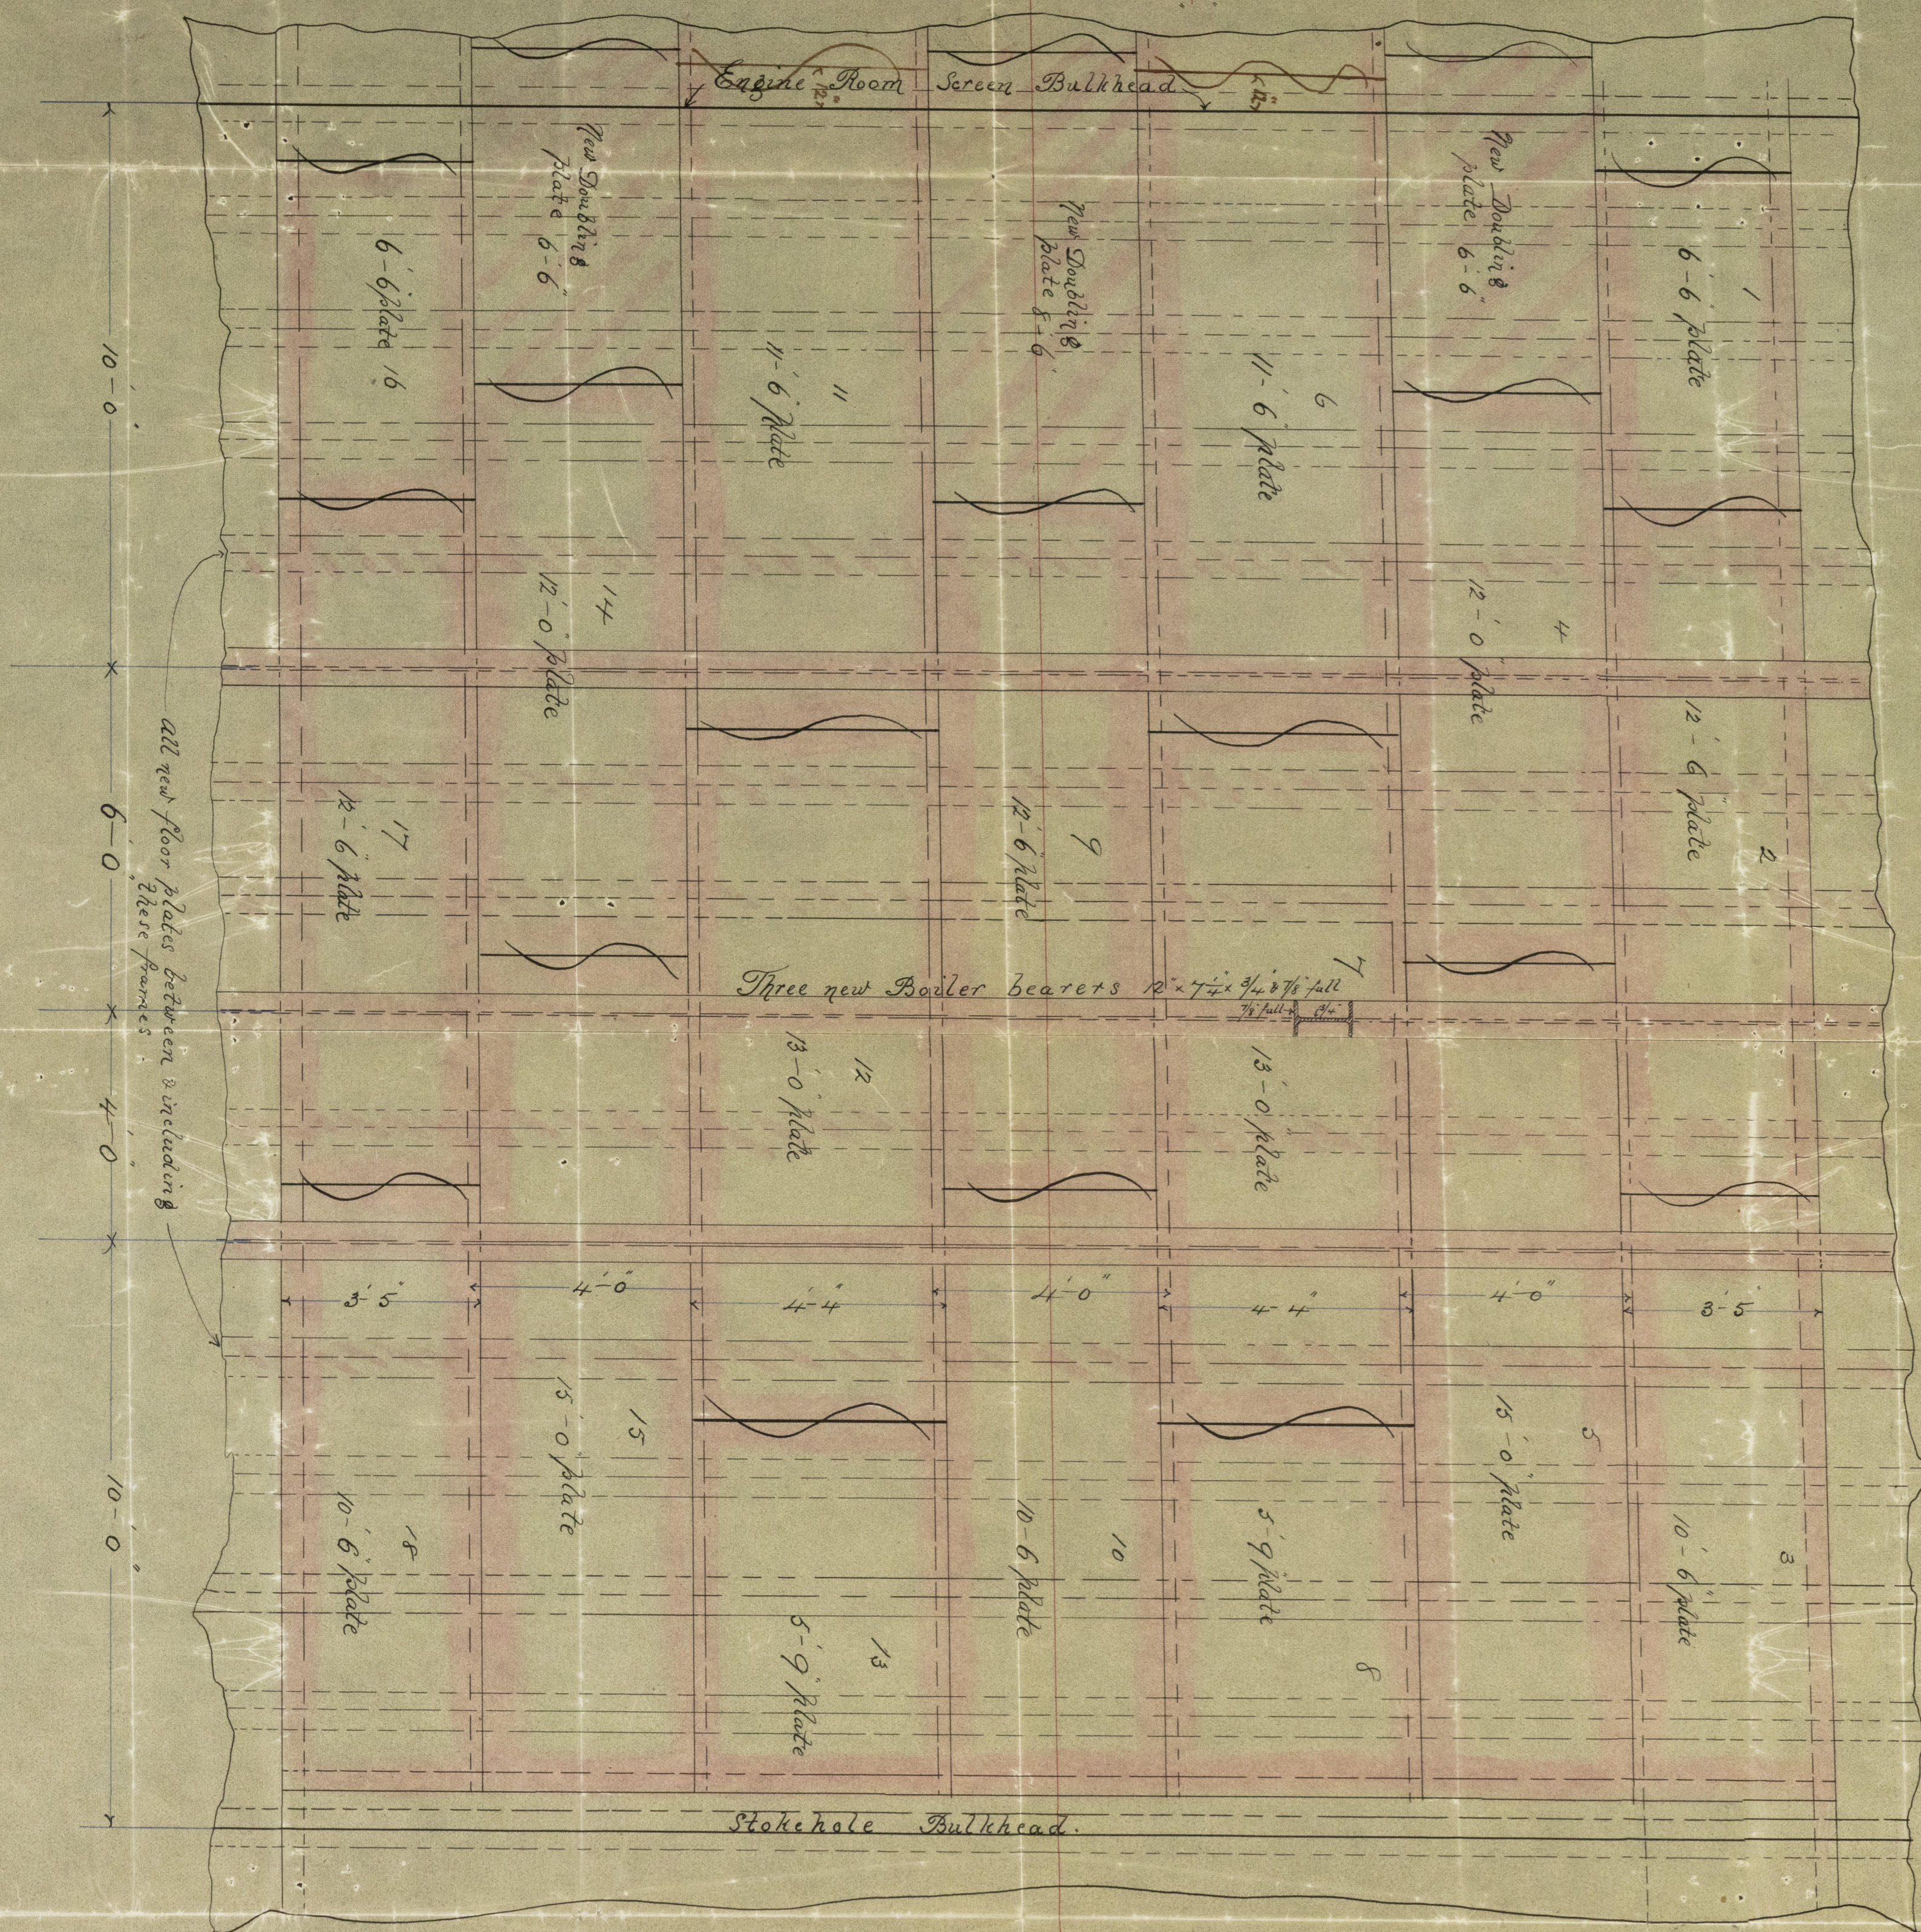

Plan of Tank top in Stokehole.

S.S. "Laughton"

Scale  $\frac{1}{2}$ " = 1 foot

