


347

Young Rung

Ch. R.

Length as per rule	-----	223'-0" engl.
Breadth moulded	-----	30'-0" "
Depth of hold	-----	15'-0" "

Scale $\frac{1}{2}'' = 1 \text{ foot.}$

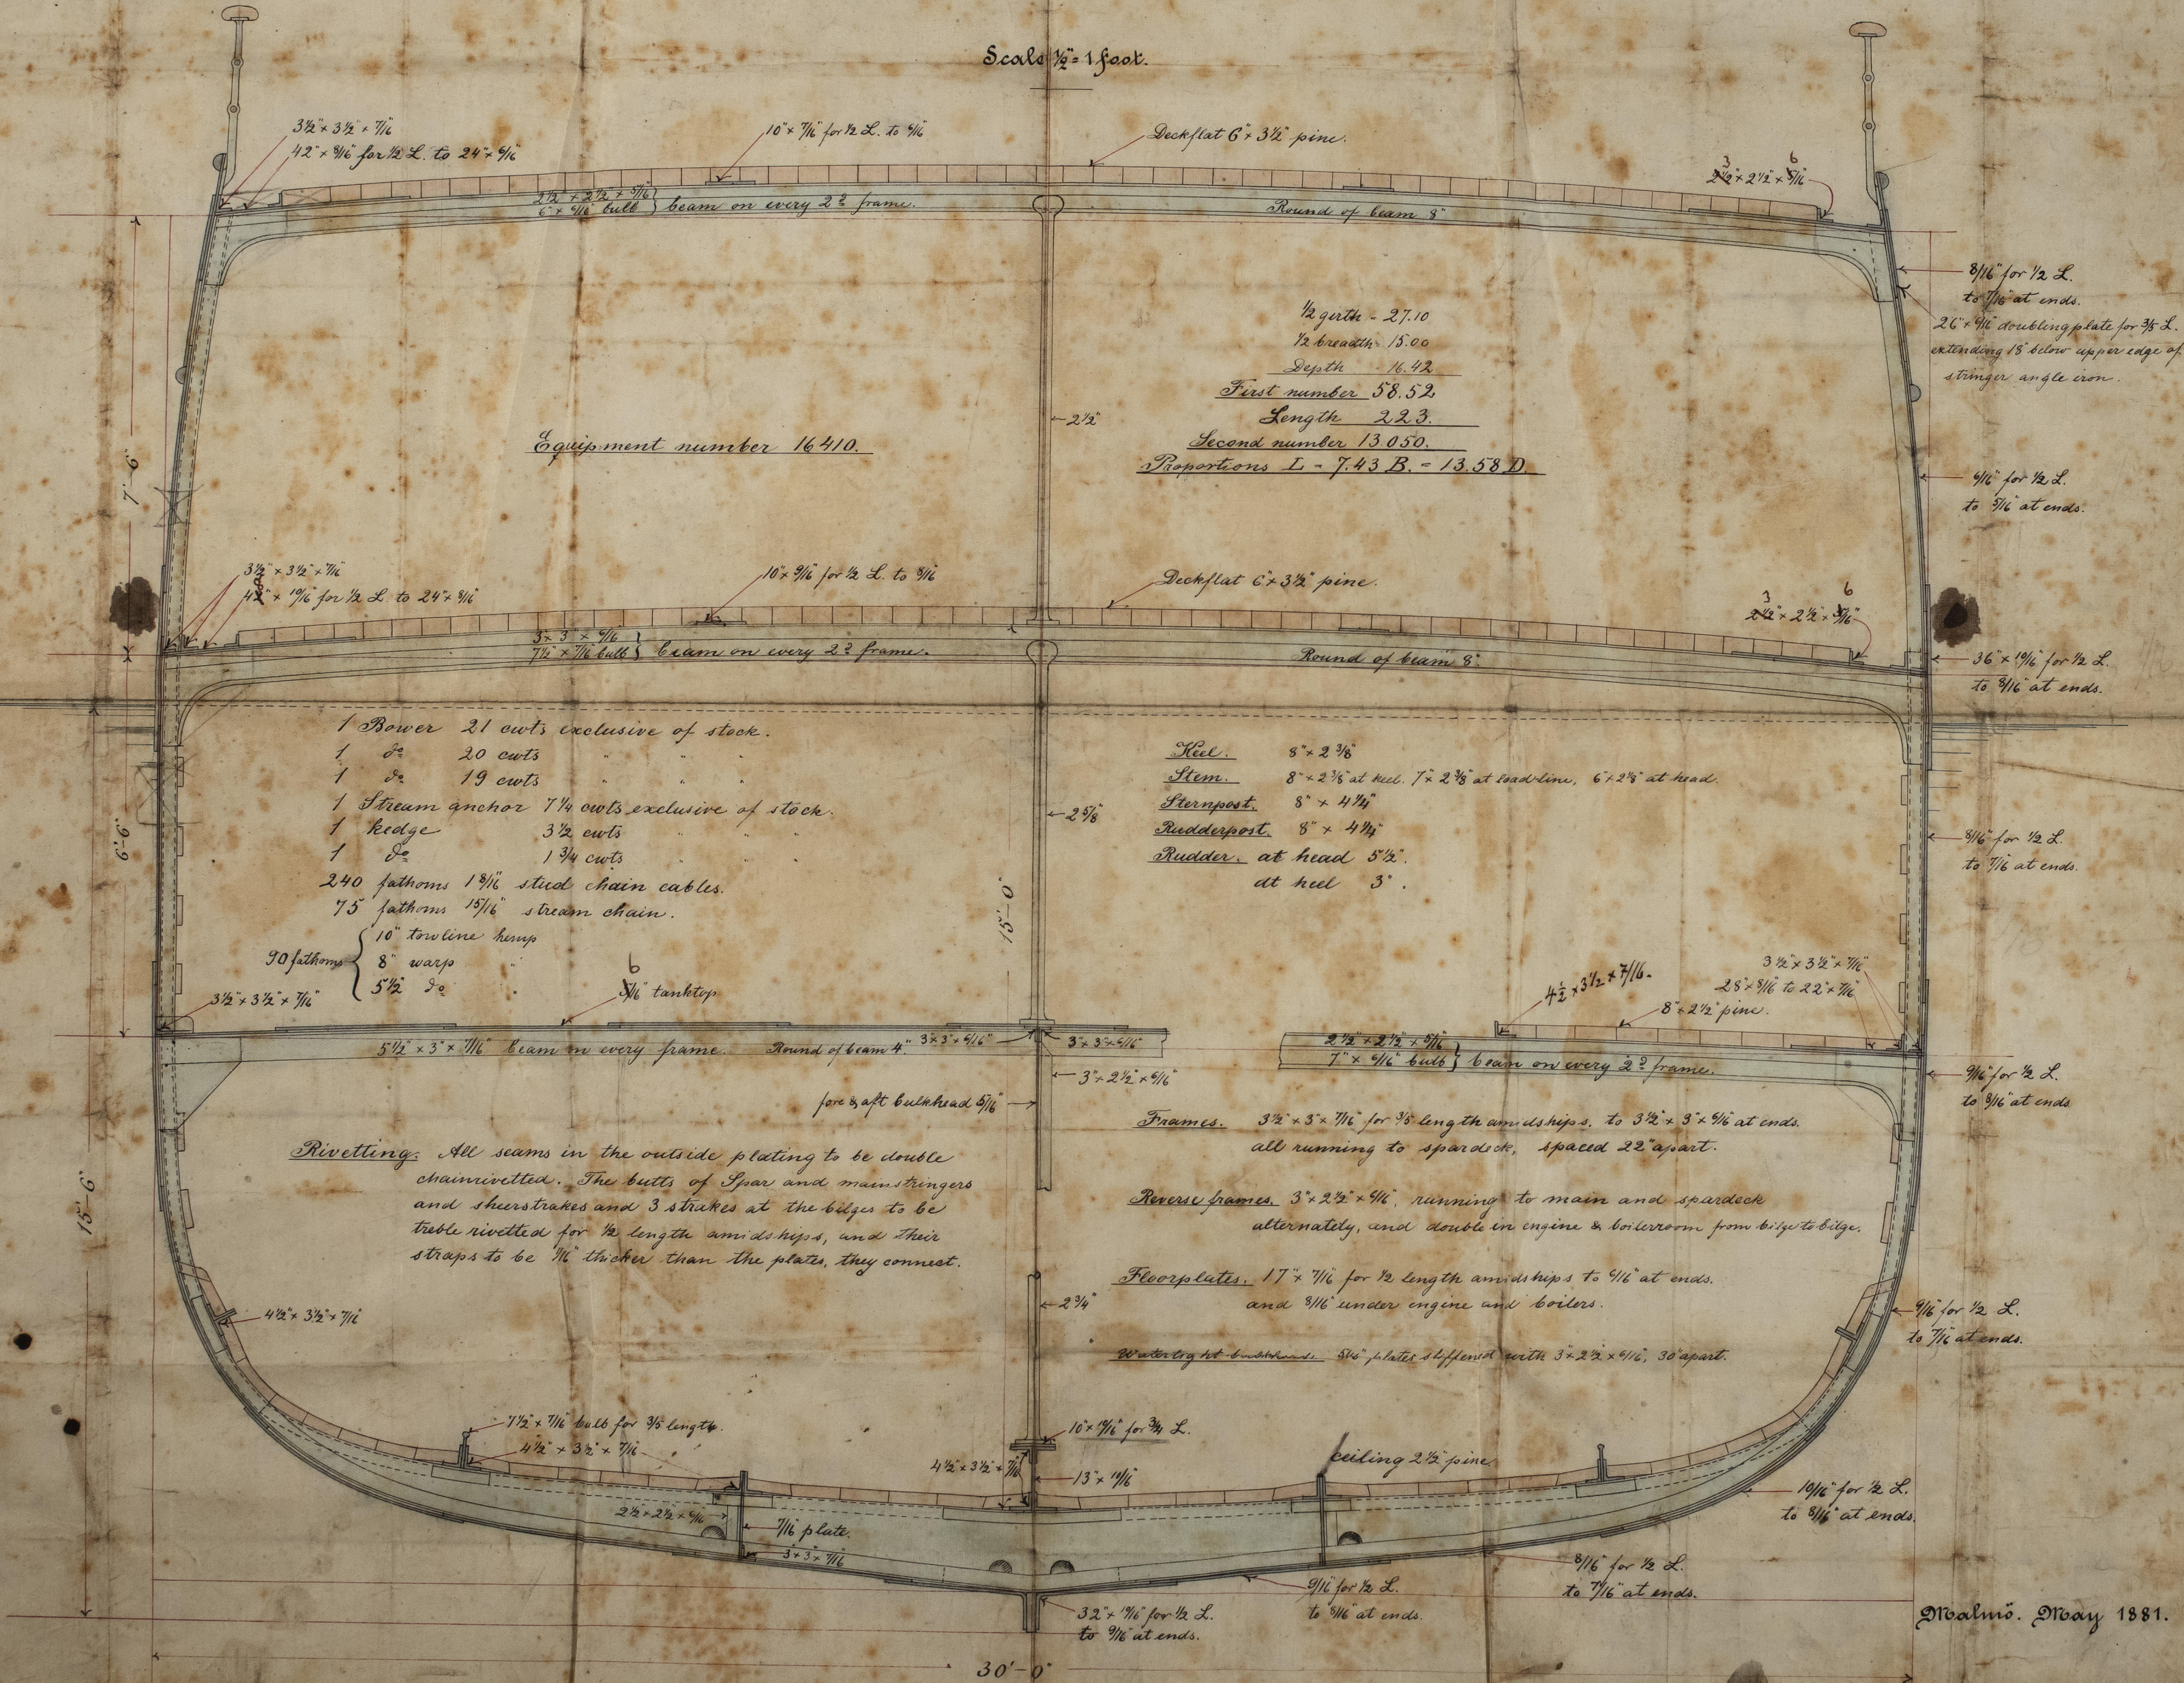

Malmo. May 1881.

BM
31/5/88

© 2021
Lloyd's Register
Foundation

CPN 1110/36