


Yard No. ? XXXVIII.

"Breeze" No. 217

Str: to Capn.
1/3/83

Elevation of a Steamer of following dimensions to be built of steel and 82 classed 100 A.I. S'loops.

Length between stems in upper deck = 159.25 feet. Breadth moulded = 24.16 feet. Depth in hold from Keel = 15.20. $\frac{1}{2}$ Girth = 24.70 —
rough sketch

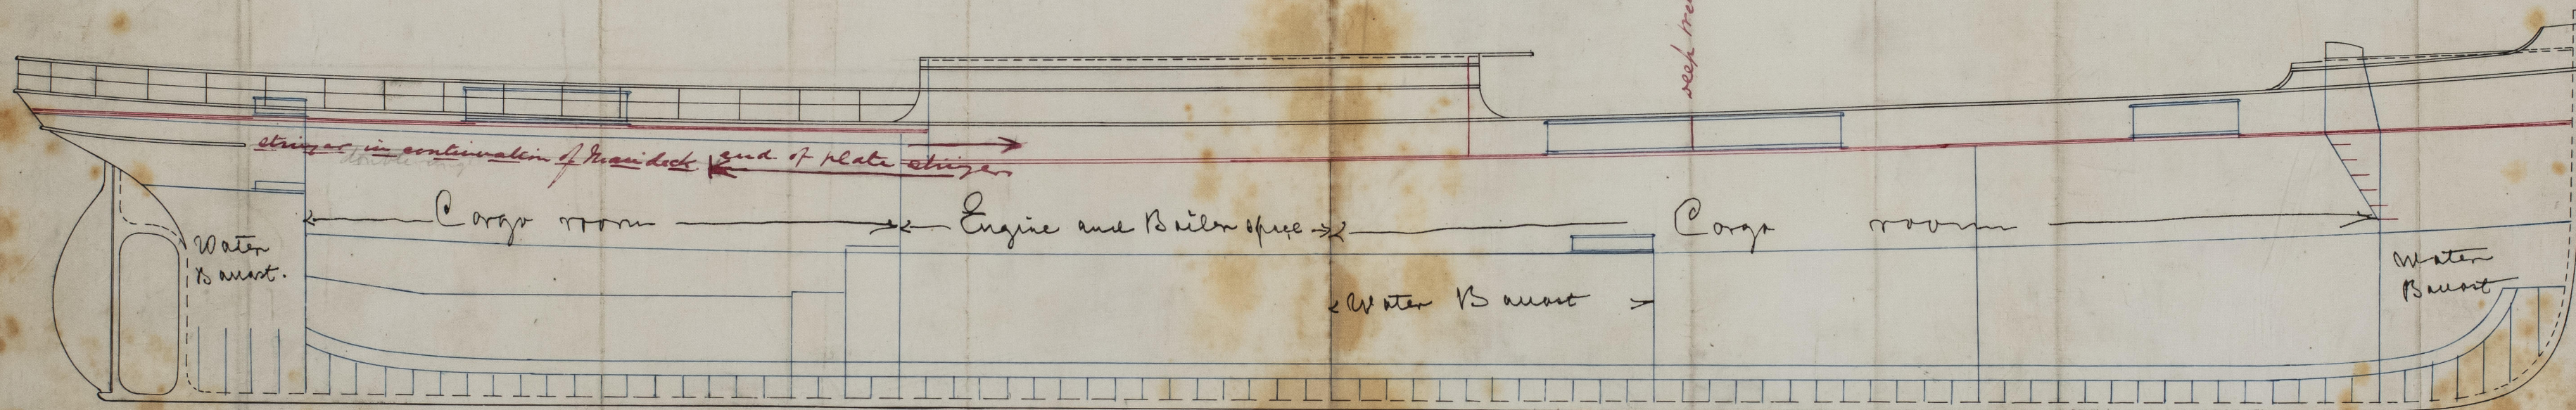

10 9 8 7 6 5 4 3 2 1 0 10 20 30 40 Feet.

J.H.
27/2/83



© 2021
Rebuilt February 1883.

Lloyd's Register
Foundation