

Dr. G. W. W.  
11/4/13



Steel Boiler for Ship No 200.

Skalar 1" = 1 fot

All dimensions in Swedish.



Ingstrup  
Kallbyck

75 #  
150

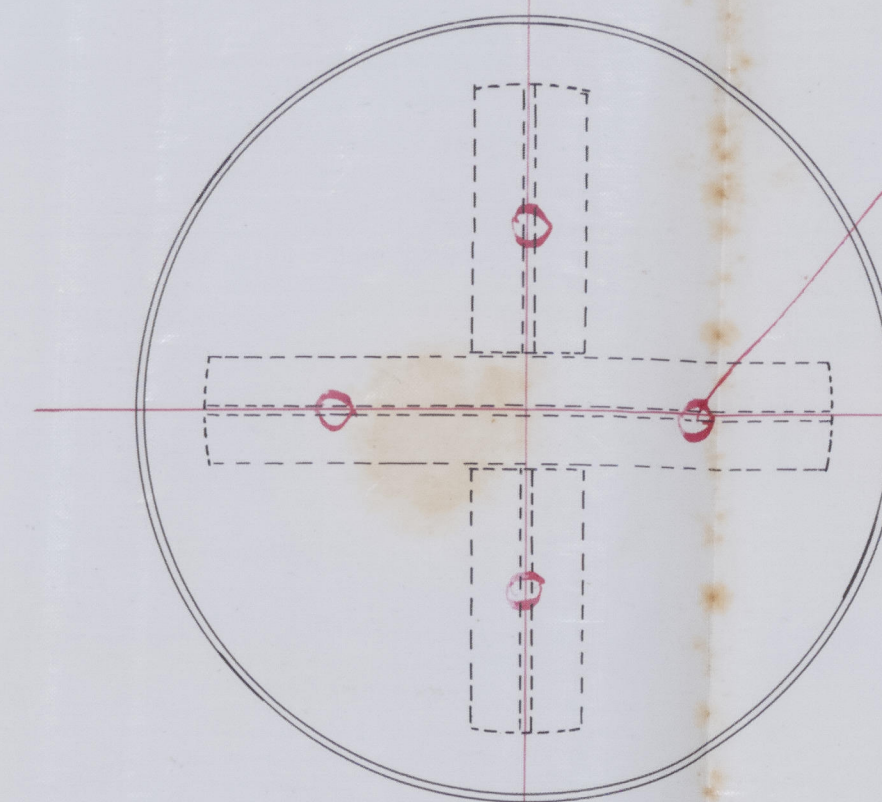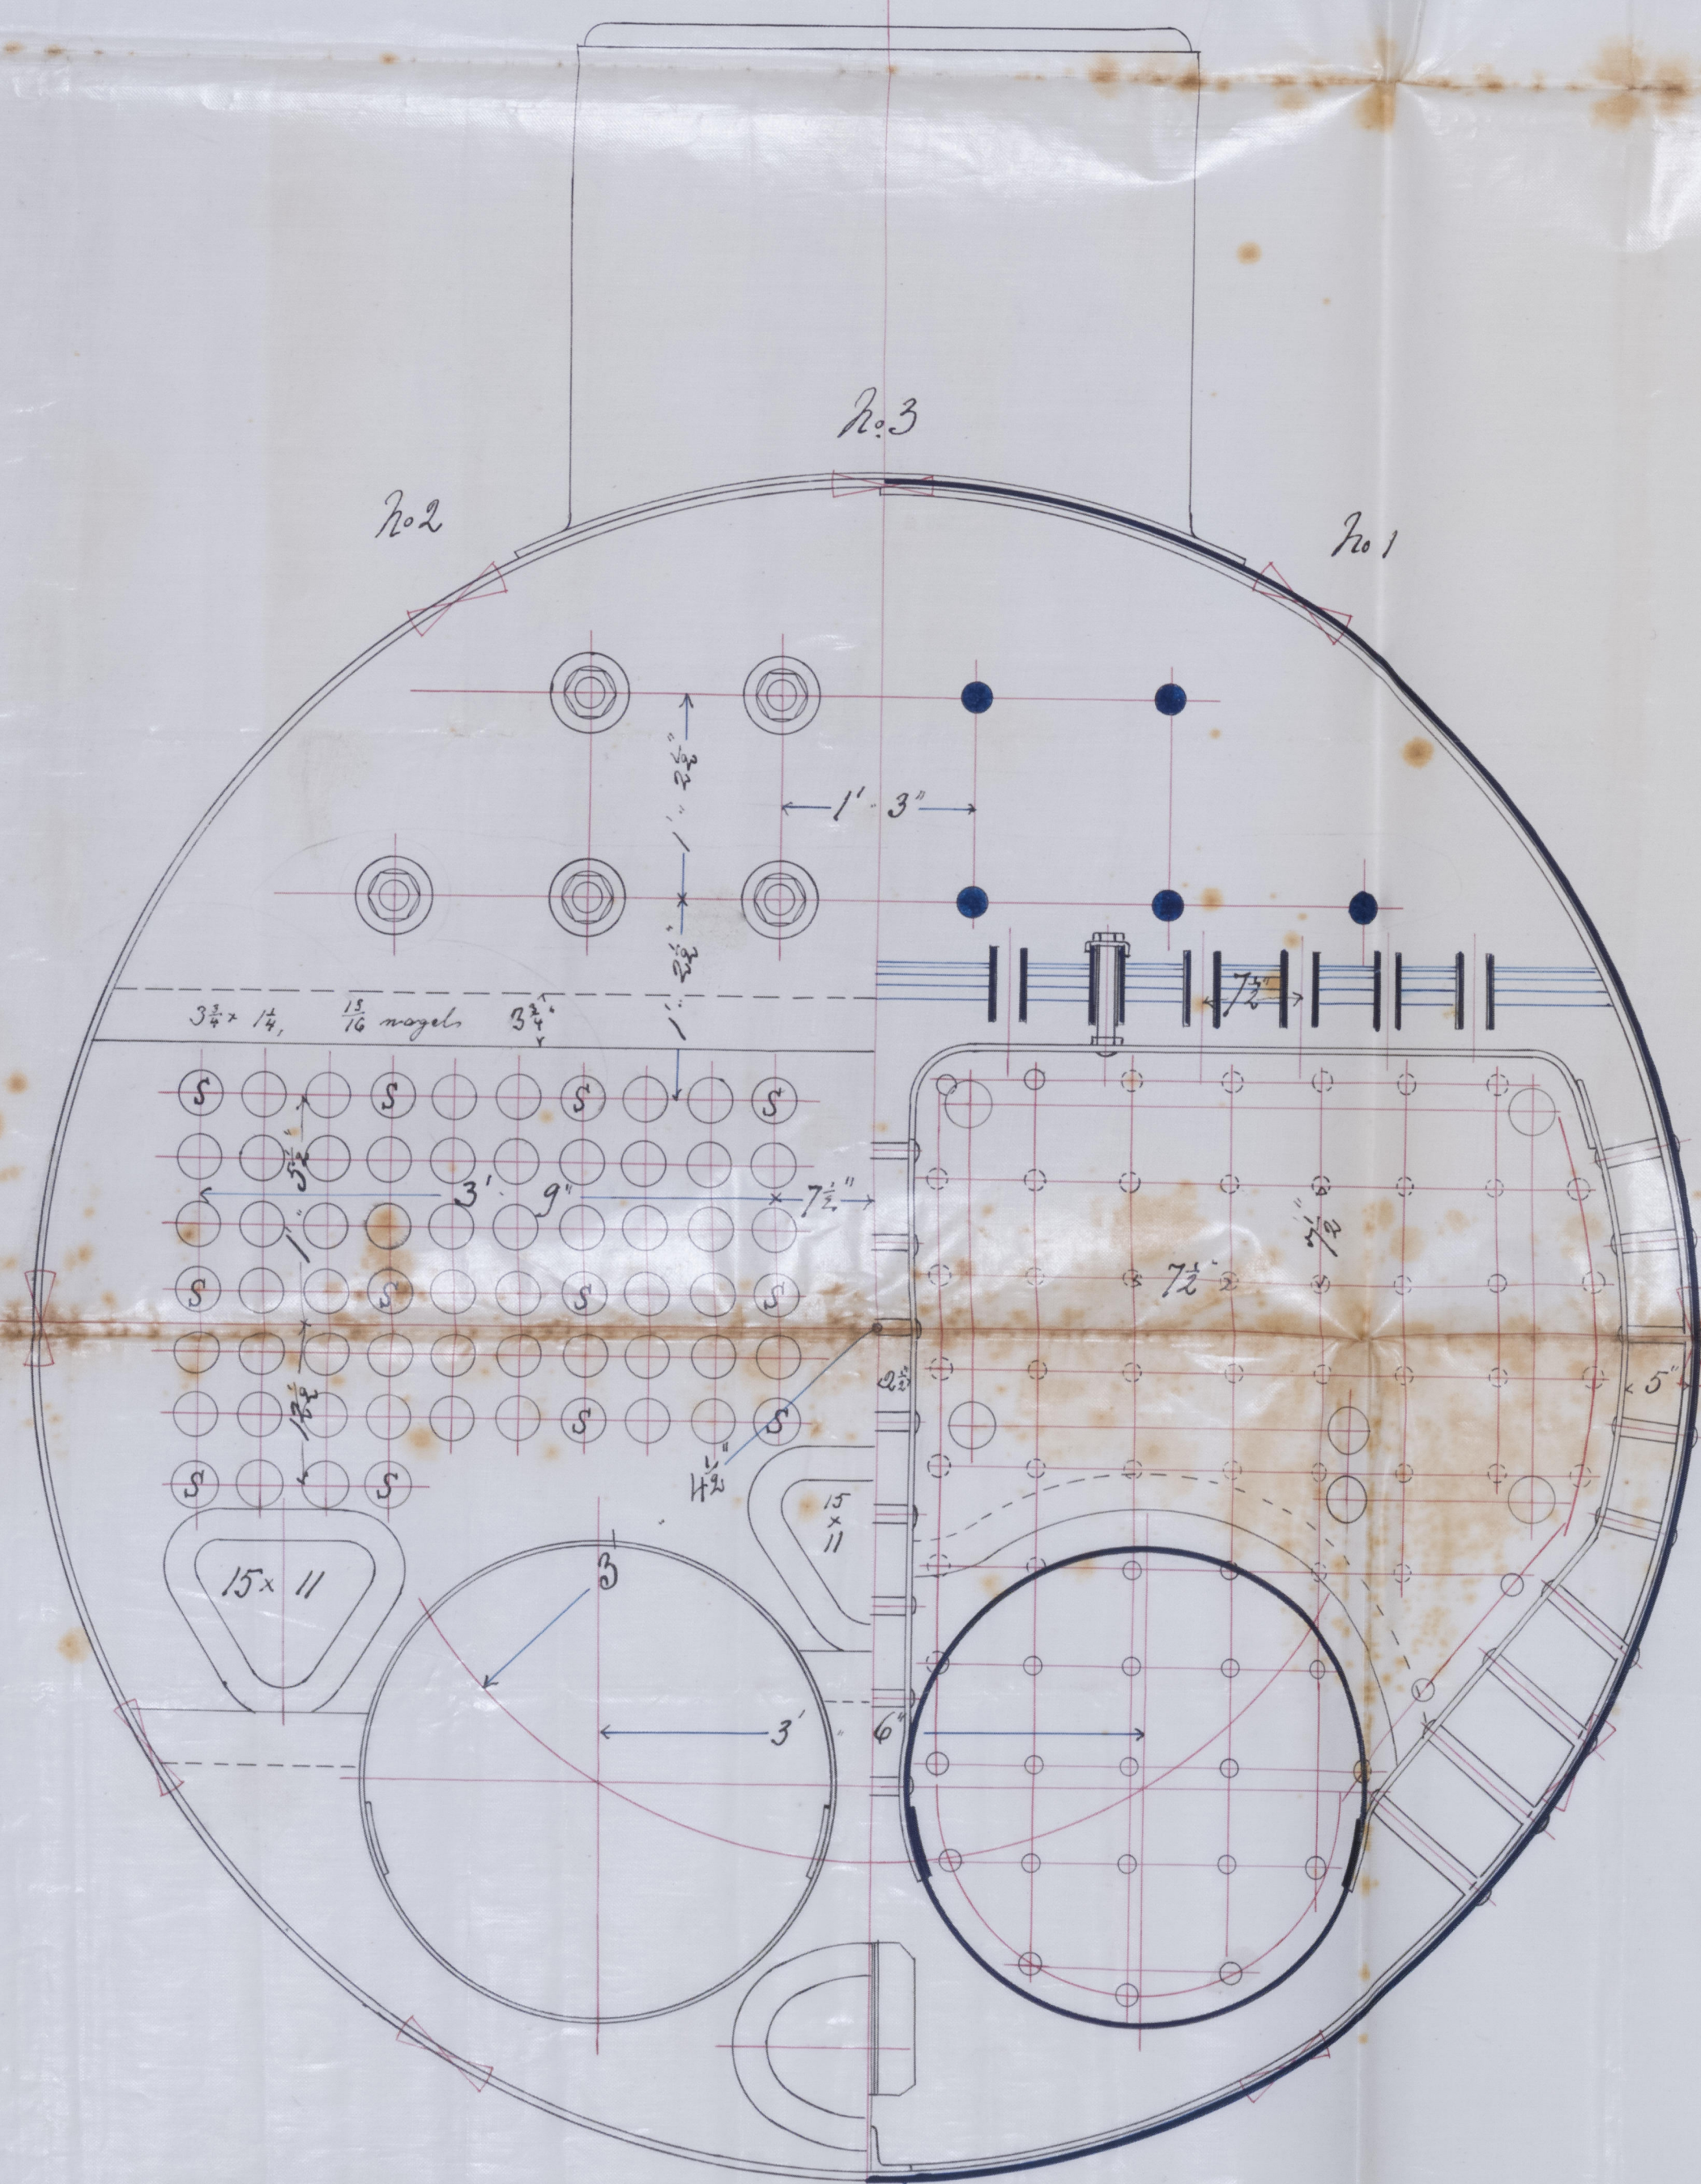

4 stumps 2" dia  
secured to shell of boiler  
and top of steam dome  
11/10/13

Brage Gpm N° 214

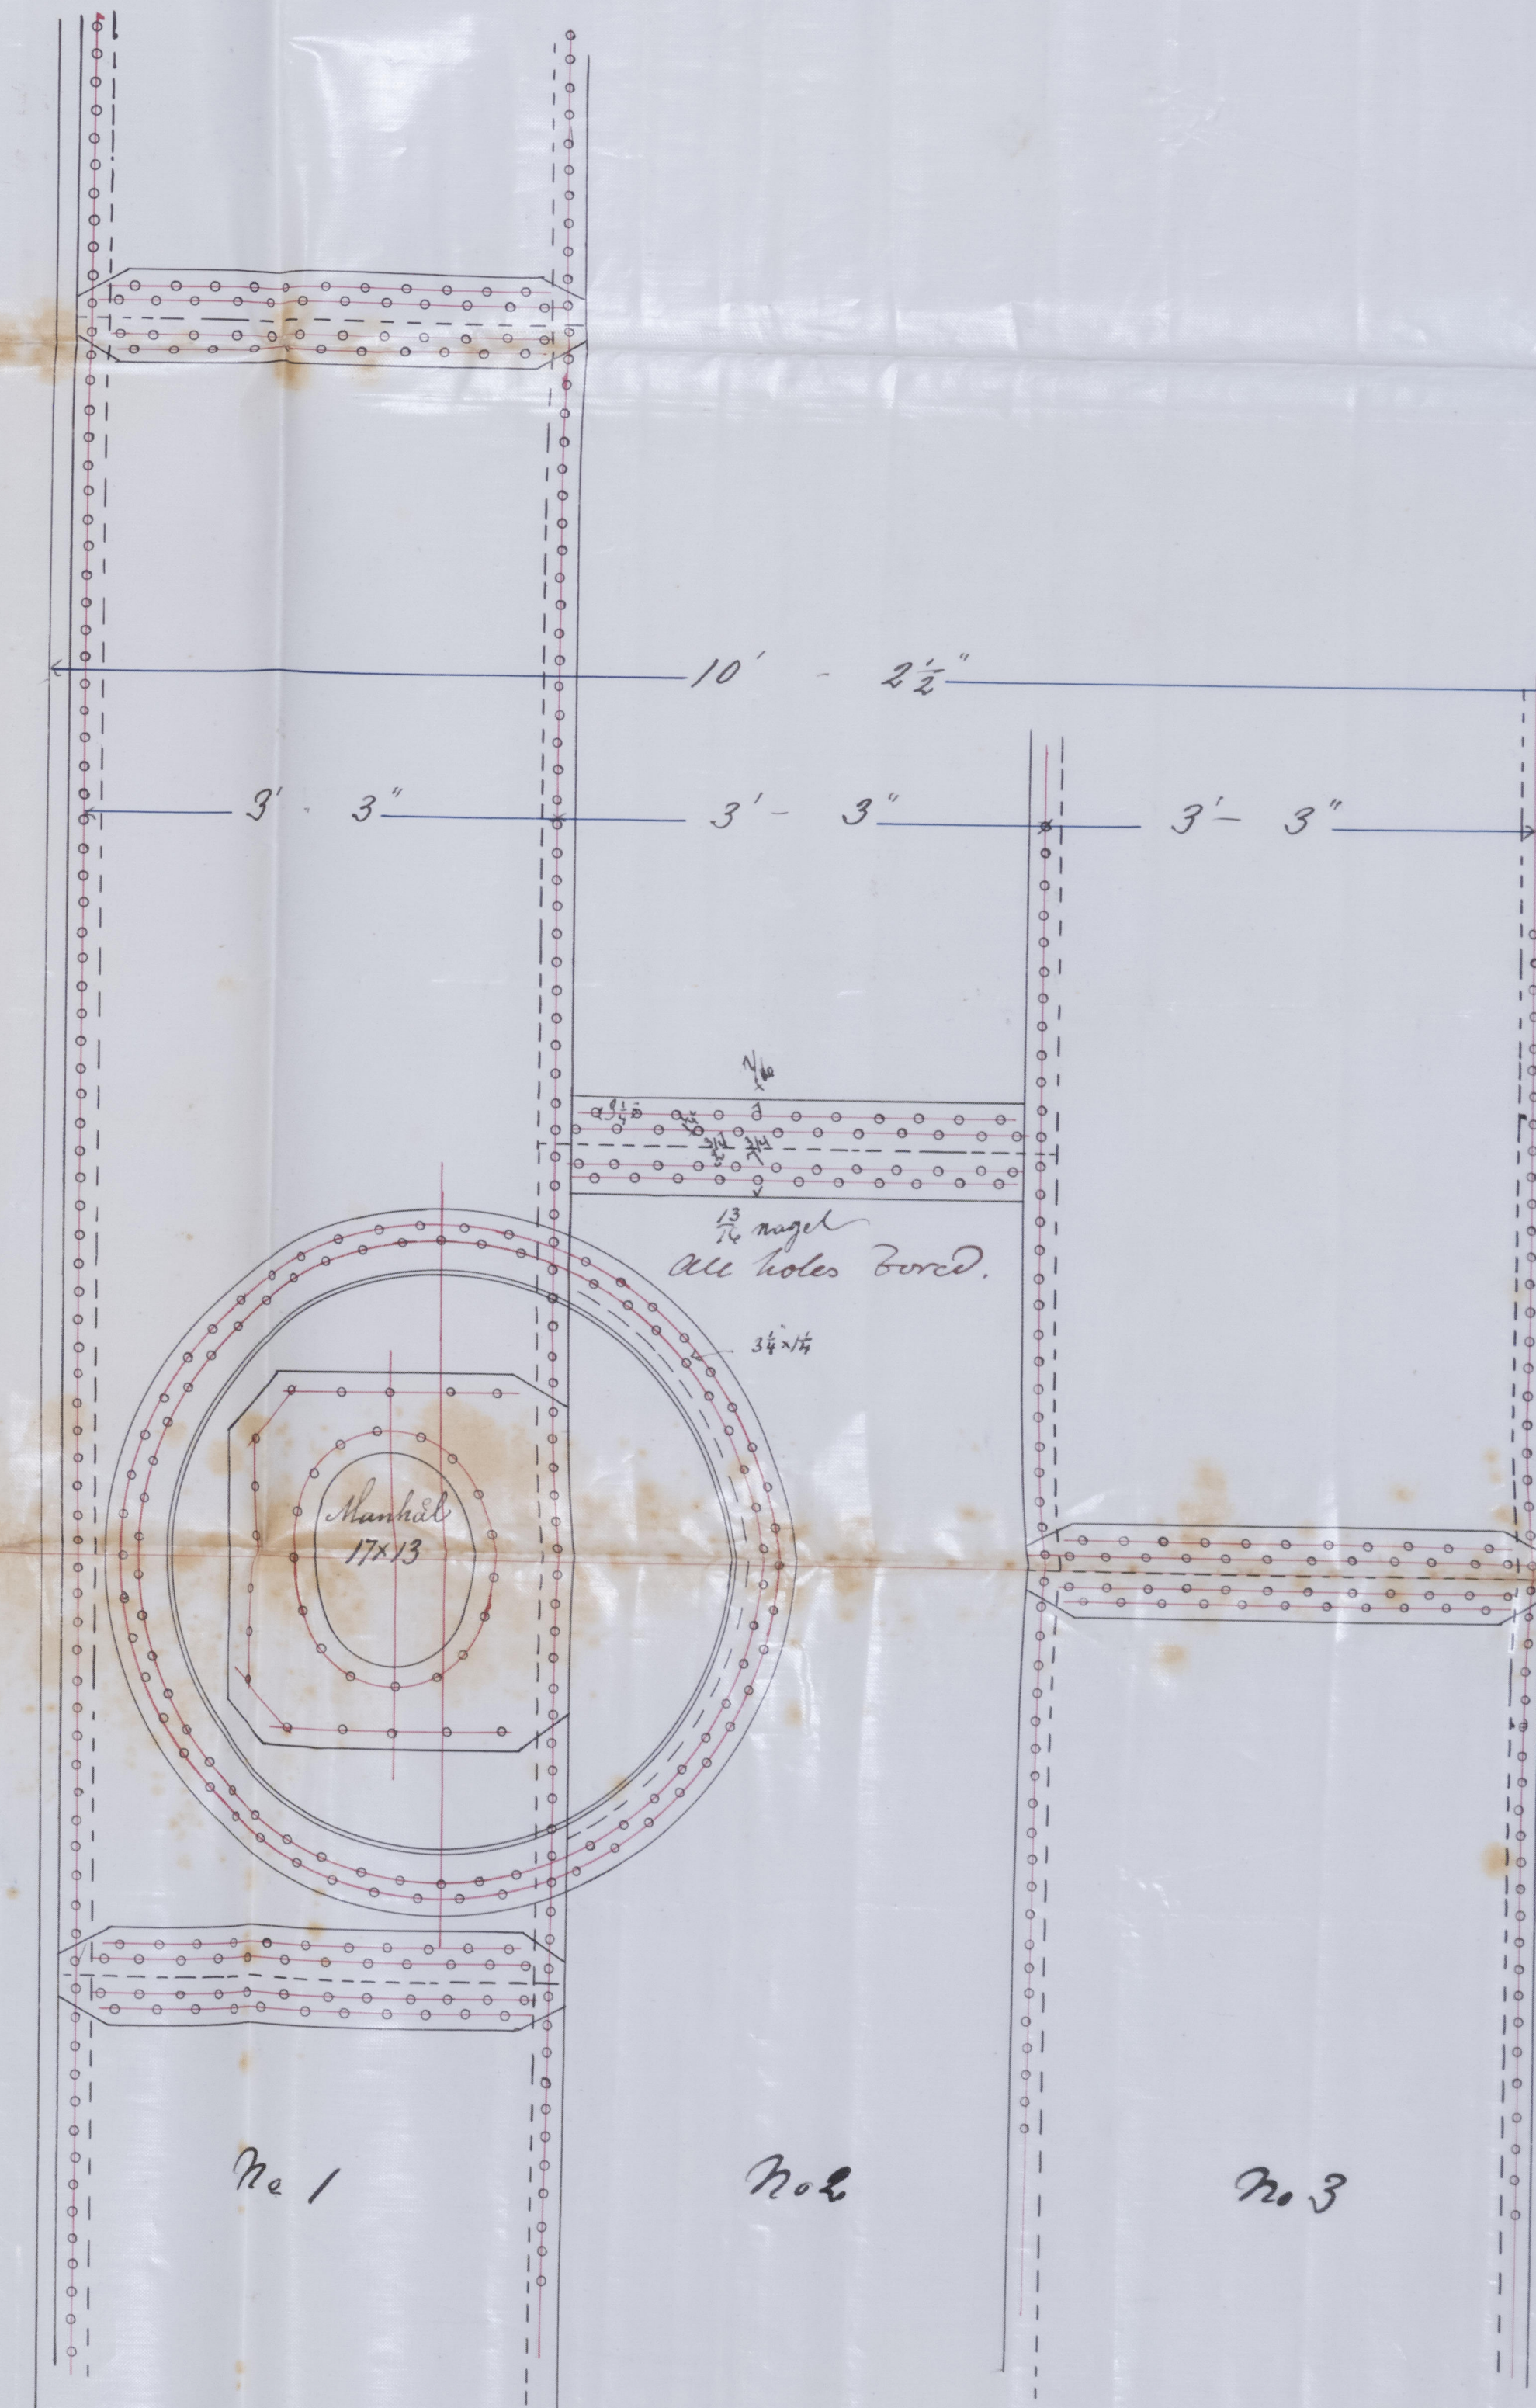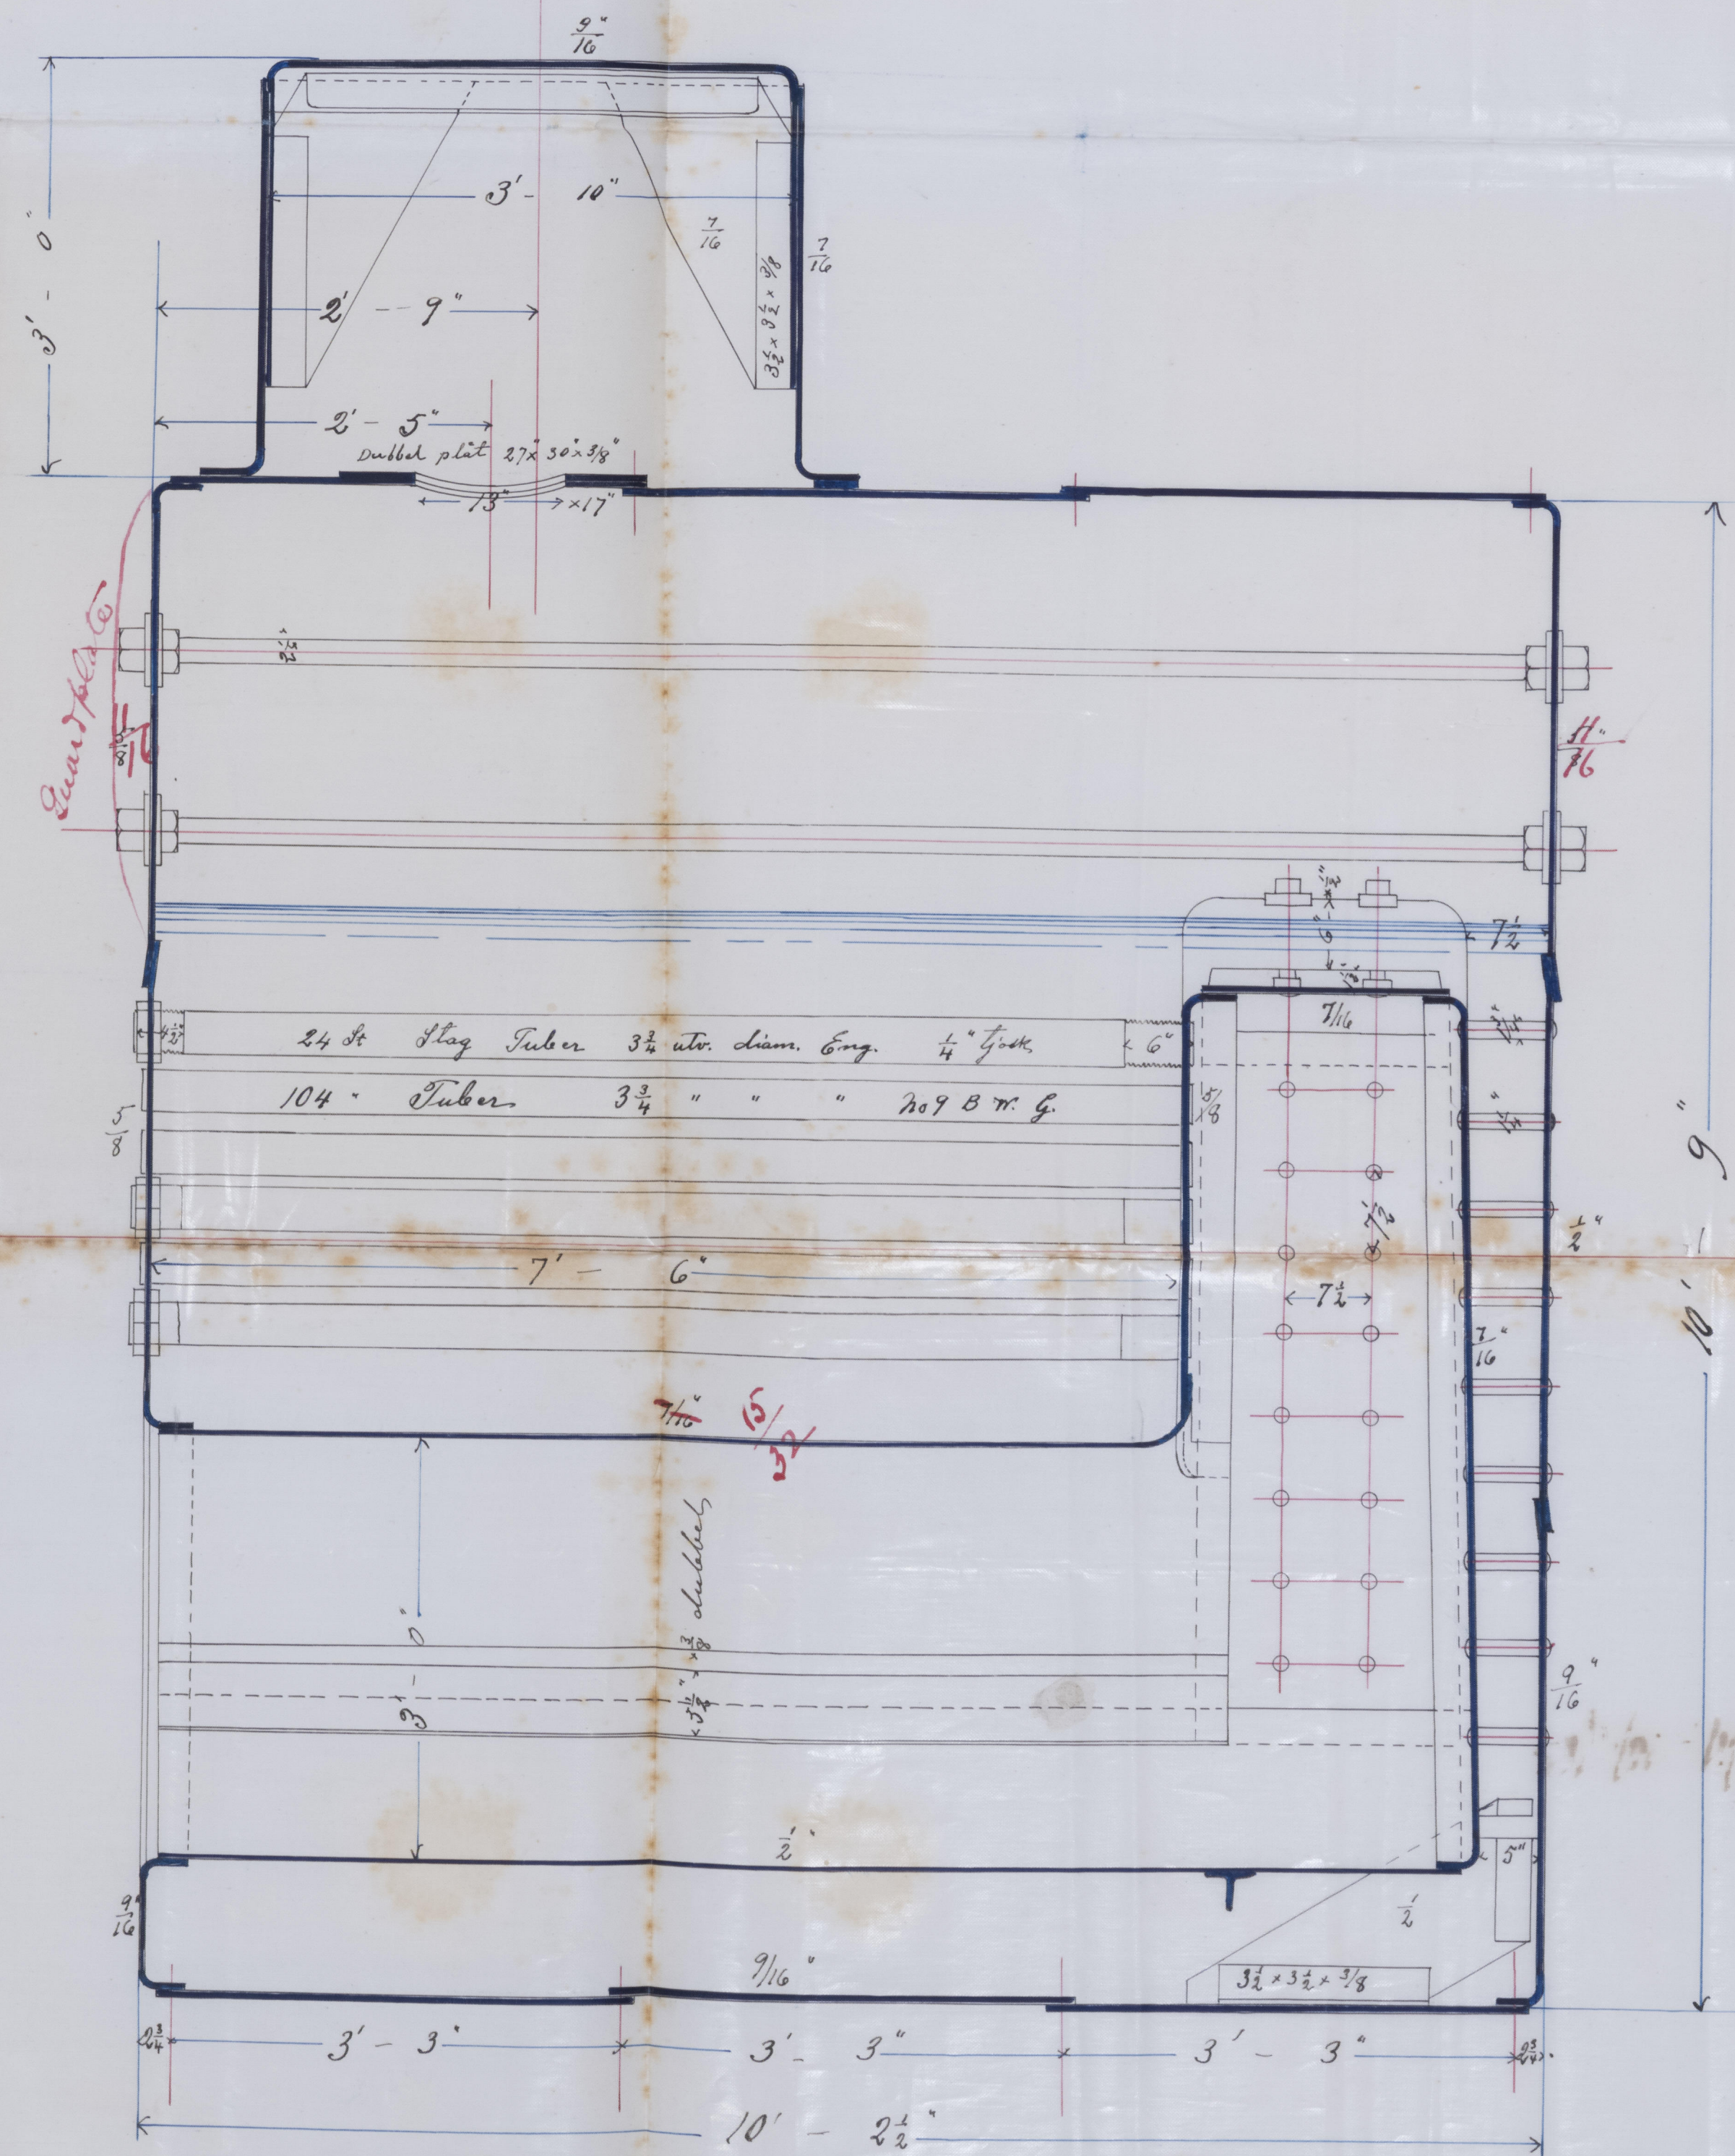

Malmö den 26de Mars 1893

Ernst Nyström



CPN1110/78

22. 11. 1881

12/20

