


RECEIVED 23rd APR. 83.

l<sup>r</sup> to Chm  
26/4/83

Boiler for S.S. No 200

Proposed alteration on  
end plates of Steam Space.

Scale 1" = 1 foot.

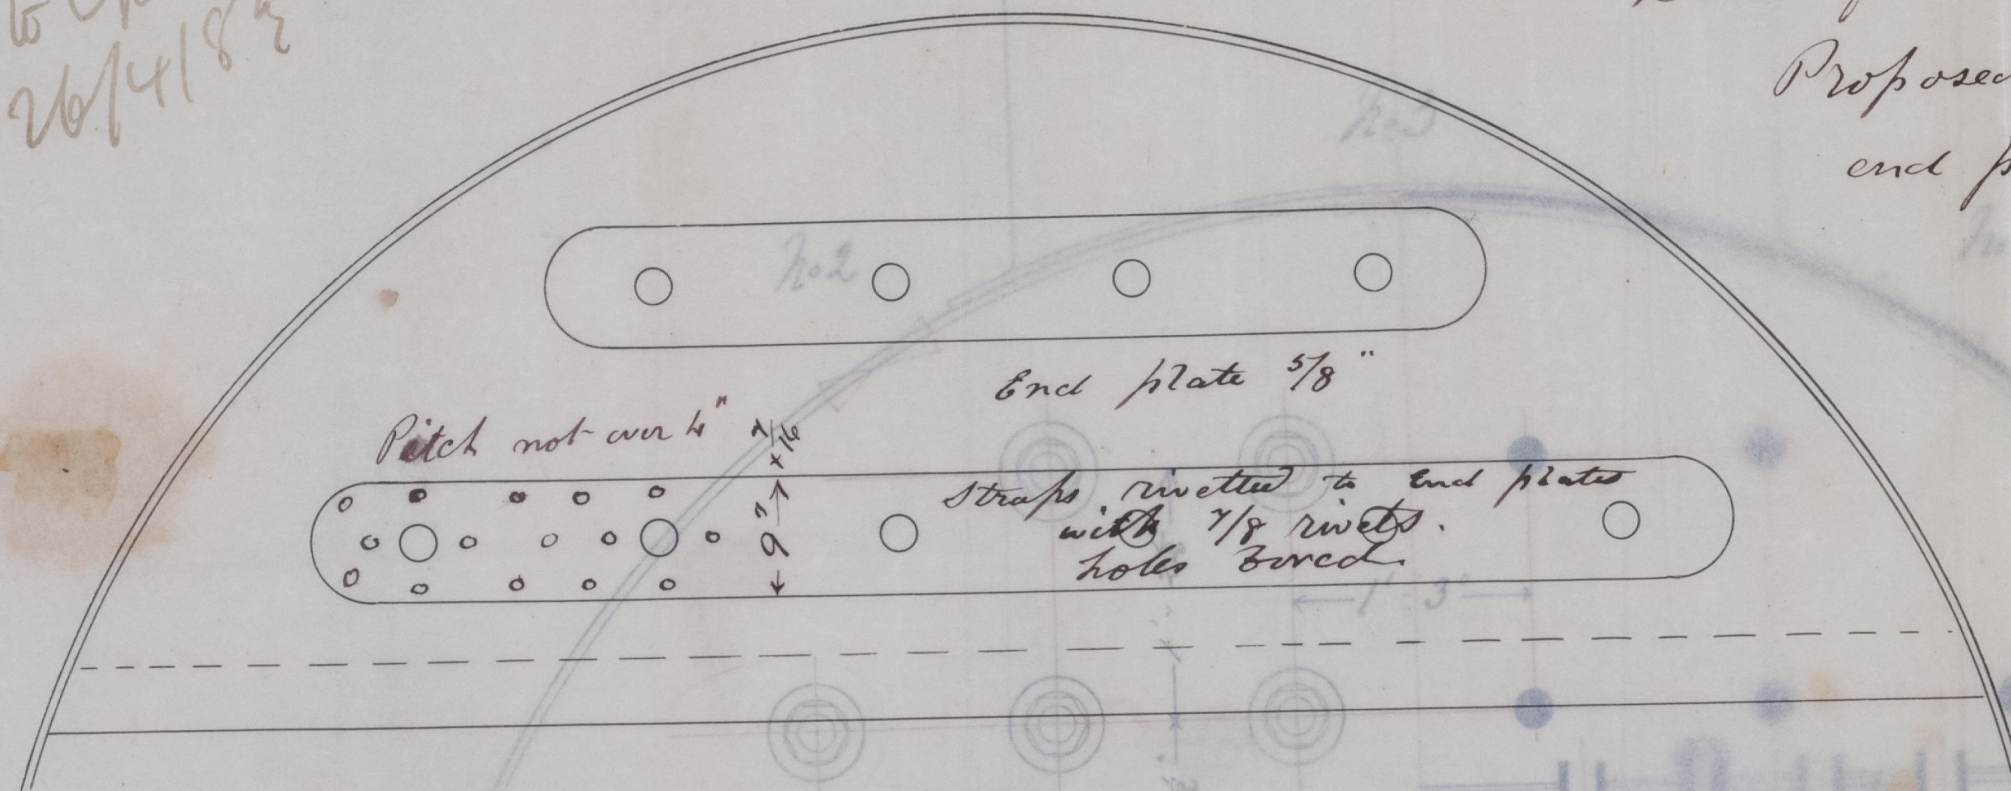

M. 25/4/83

Malmo 20th April 1883.

S. Fred. Kinder,  
Kjøbenhavn. K.



© 2021

Lloyd's Register  
Foundation