


27.4.99
19.5.99

Equipment
1 lower 19 1/2 cwt. ex stock.
1 " 19 " " "
1 stream 6 1/2 " " "
1 kedge 3 " " "
1 " 3 1/4 " " "

Midship Section
— of —
4 Motd Barquentine "Sachsen"
To be classed 100 AI. Lloyds (Steel).
— Scale 1/2" = 1 Foot. —

1/2 Bdrth 15.12.
1/2 Berth 26.52.
Depth 15.12.
56.76 = 1st Number.
181.41 x 56.76 = 10296 = 2nd Number.
Depth to length 11.998
Breadth to length 5.999

Queenstown

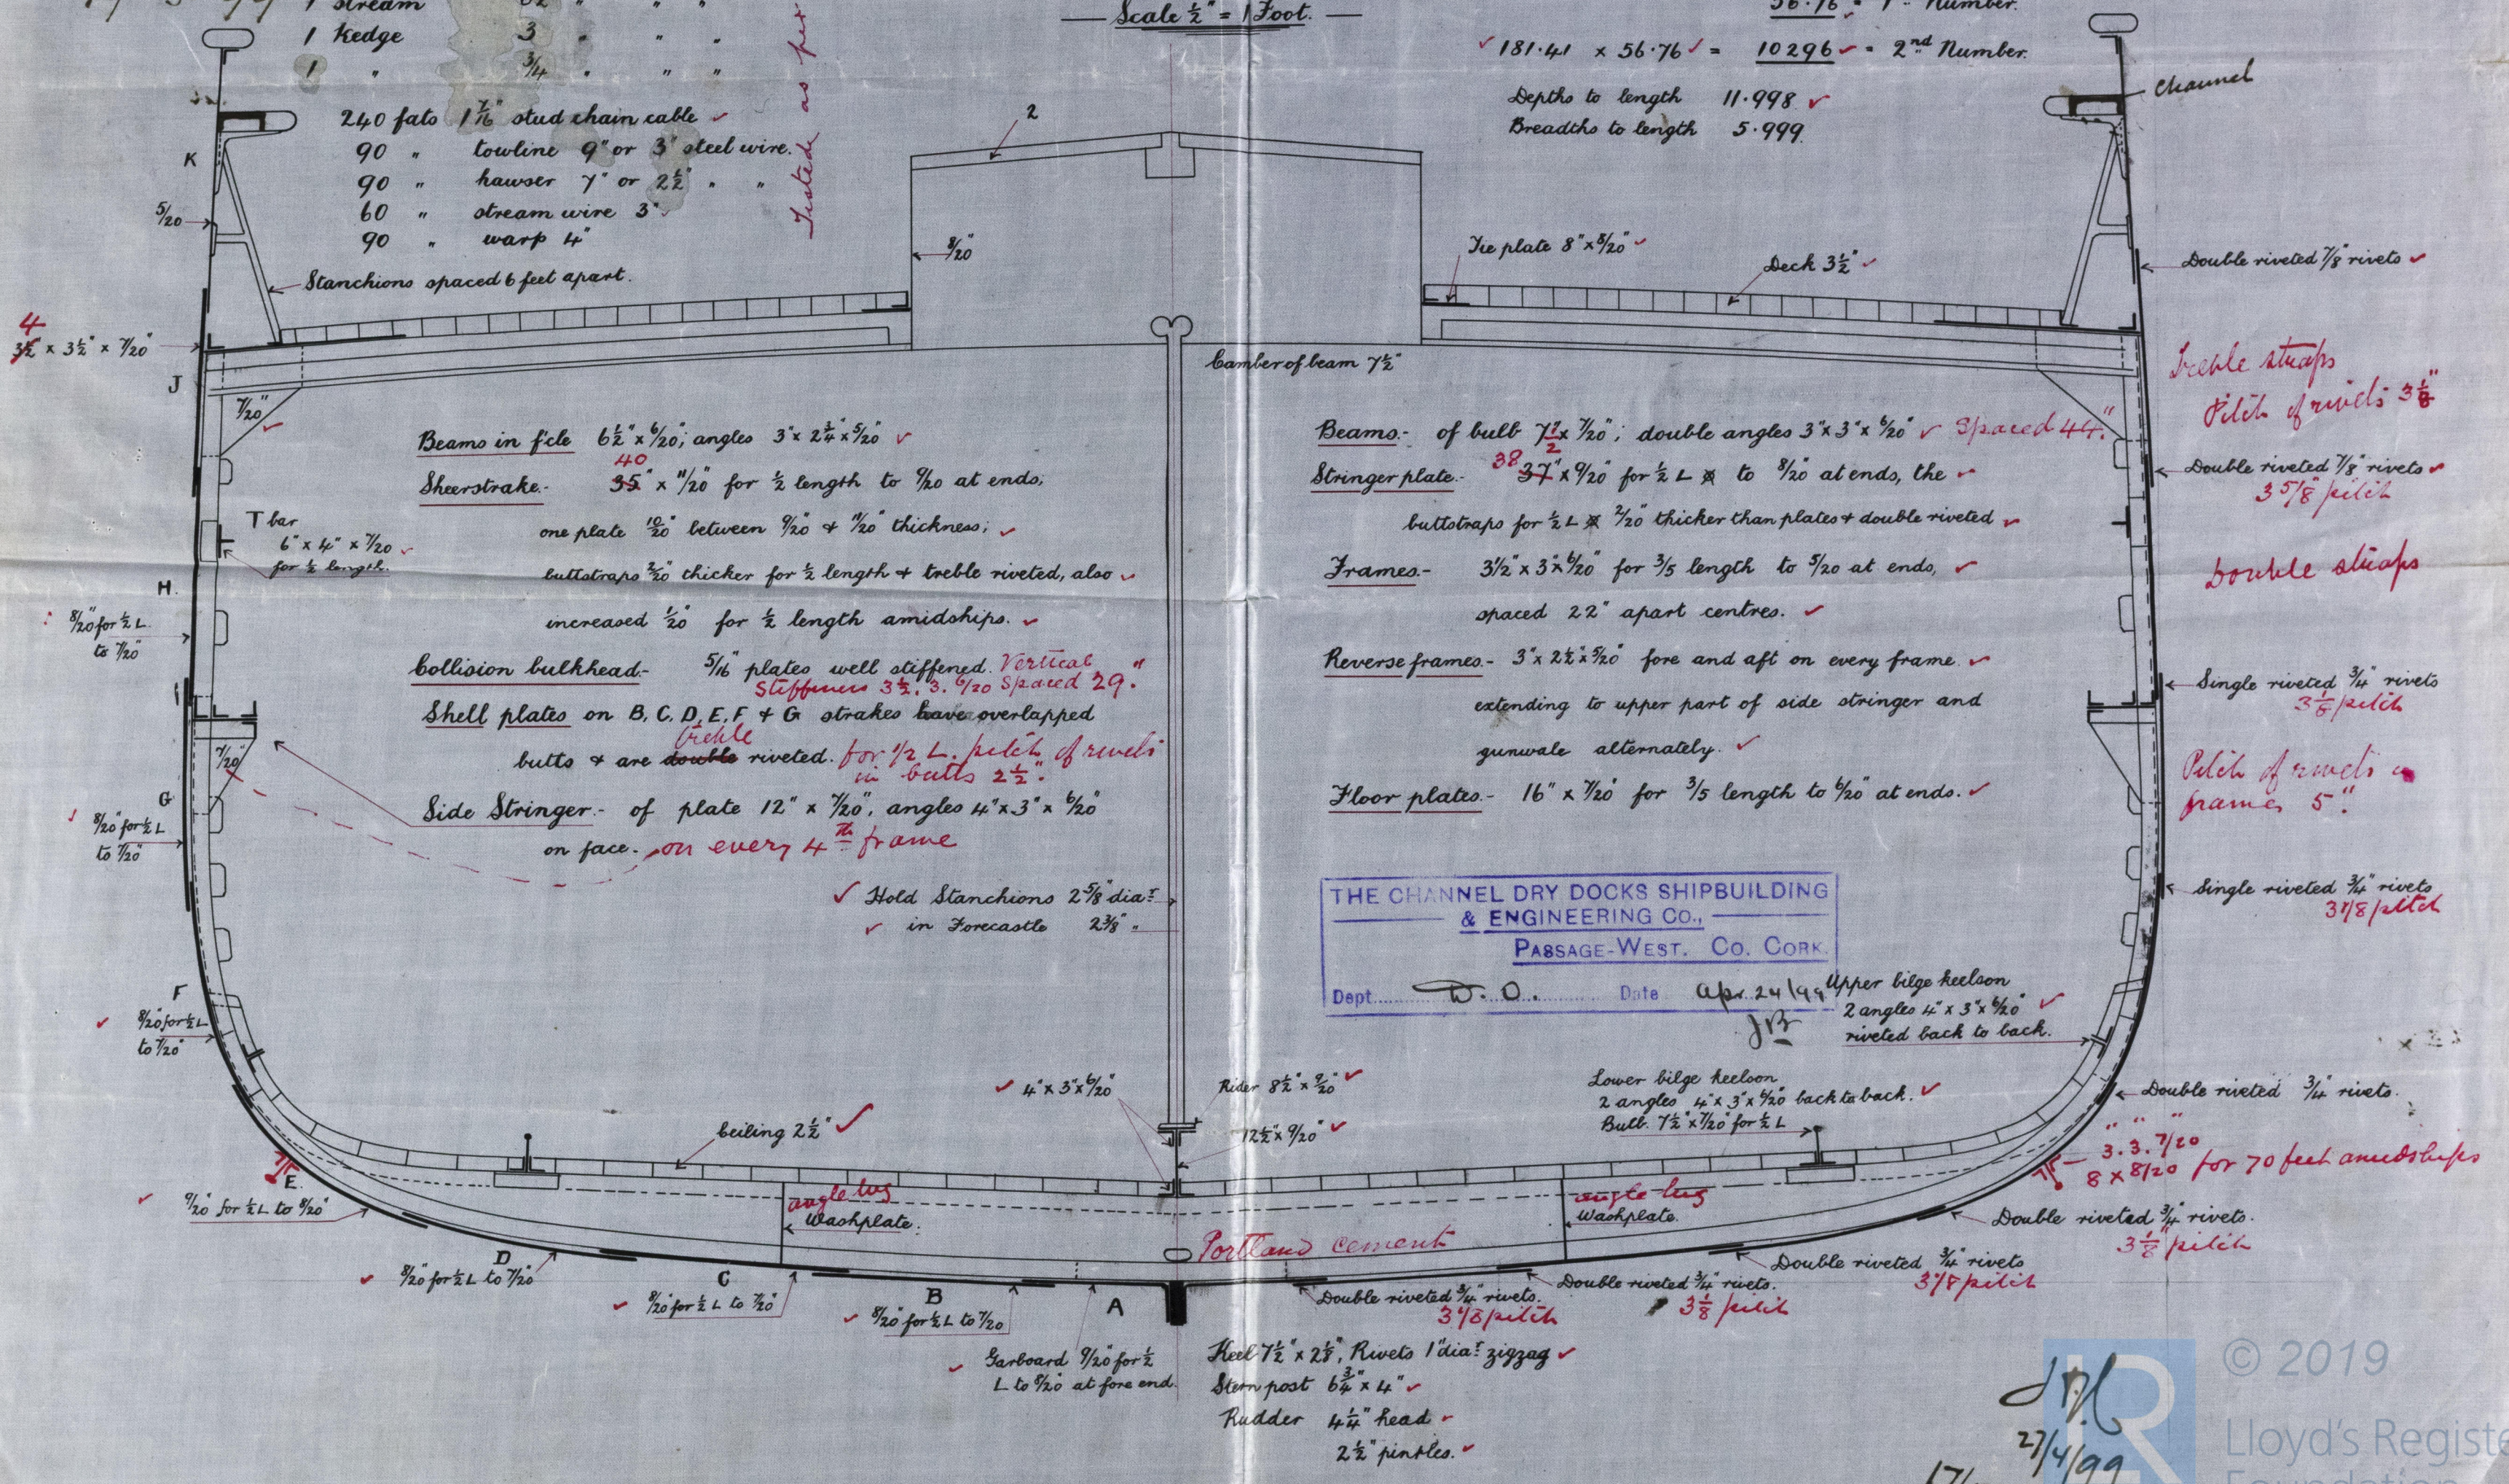

THE CHANNEL DRY DOCKS SHIPBUILDING
& ENGINEERING CO.,
PASSAGE-WEST, CO. CORK.
Dept. D.O. Date Apr. 24/99

