


DUBLIN DOCKYARD CO.  
FOR ENCLOSURE 115  
J. M. William Esq.



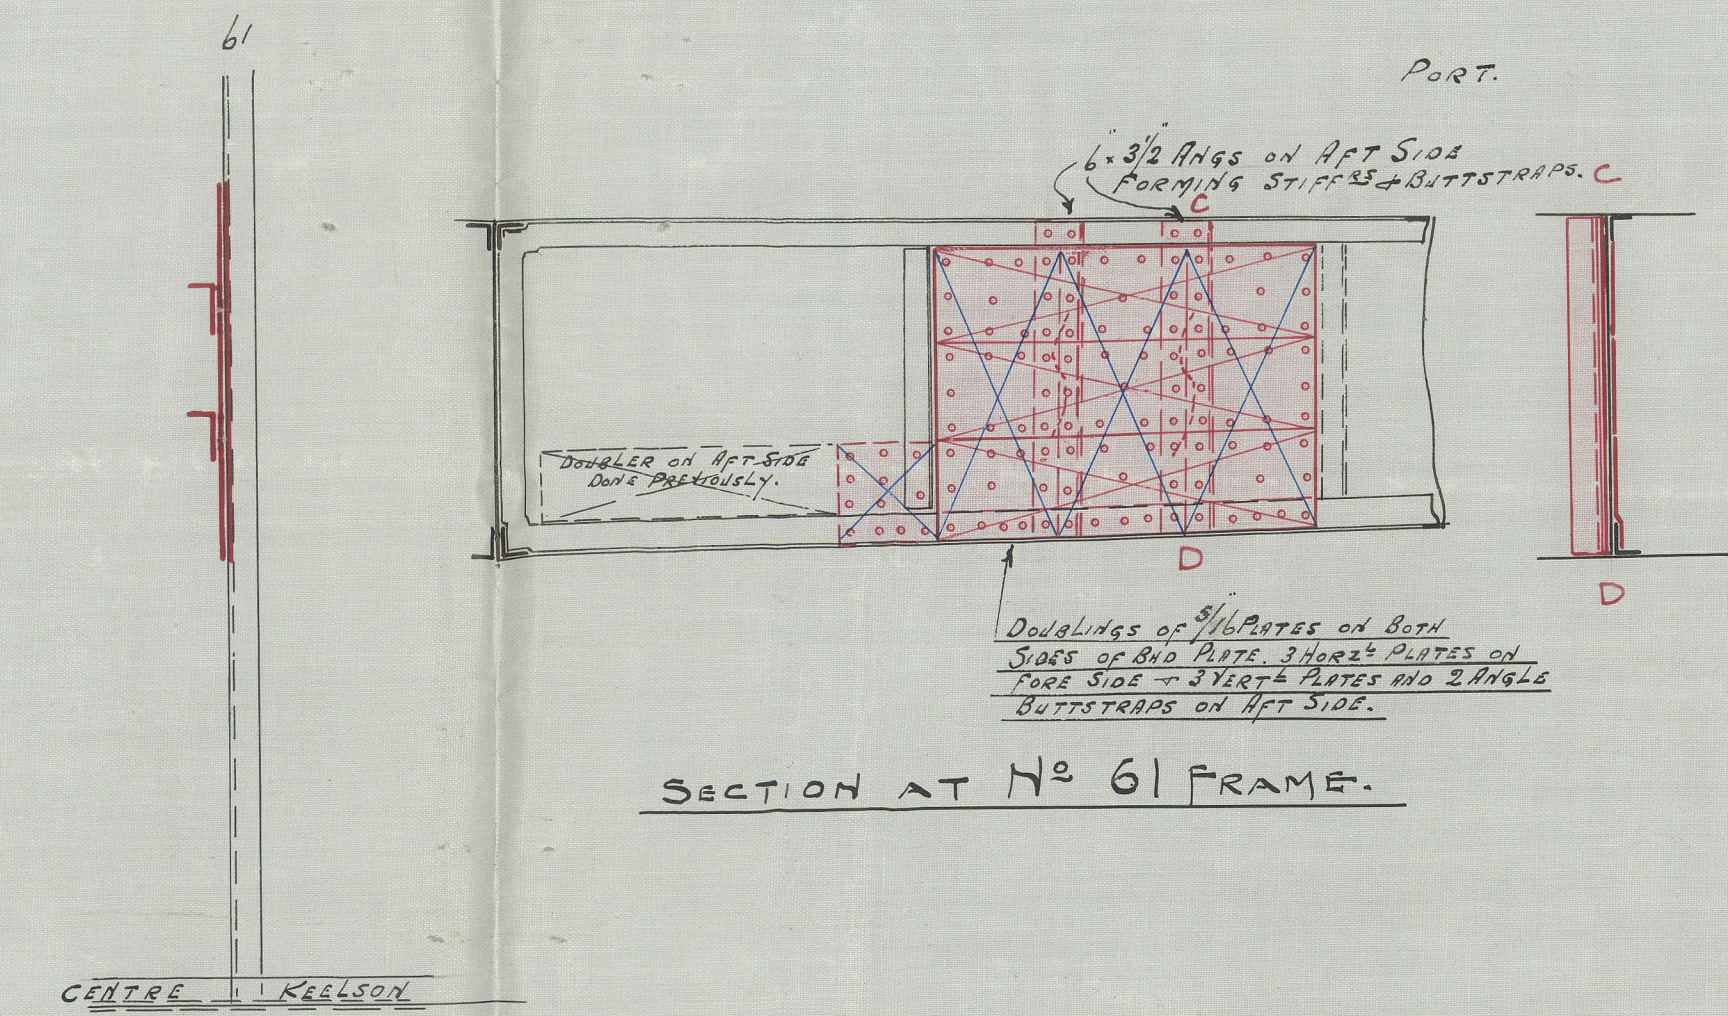


DOUBLE BOTTOM IN WAY OF MACHINERY SPACE


— S.S. BRAY HEAD —

SCALE 1/2 INCH = ONE FOOT


NOTE: ALL NEW WORK IS SHOWN IN RED.

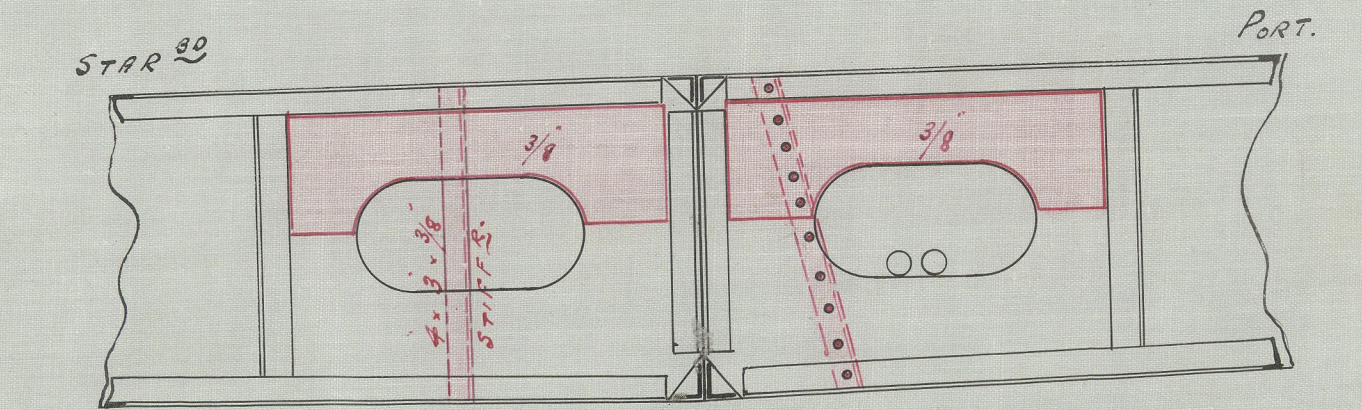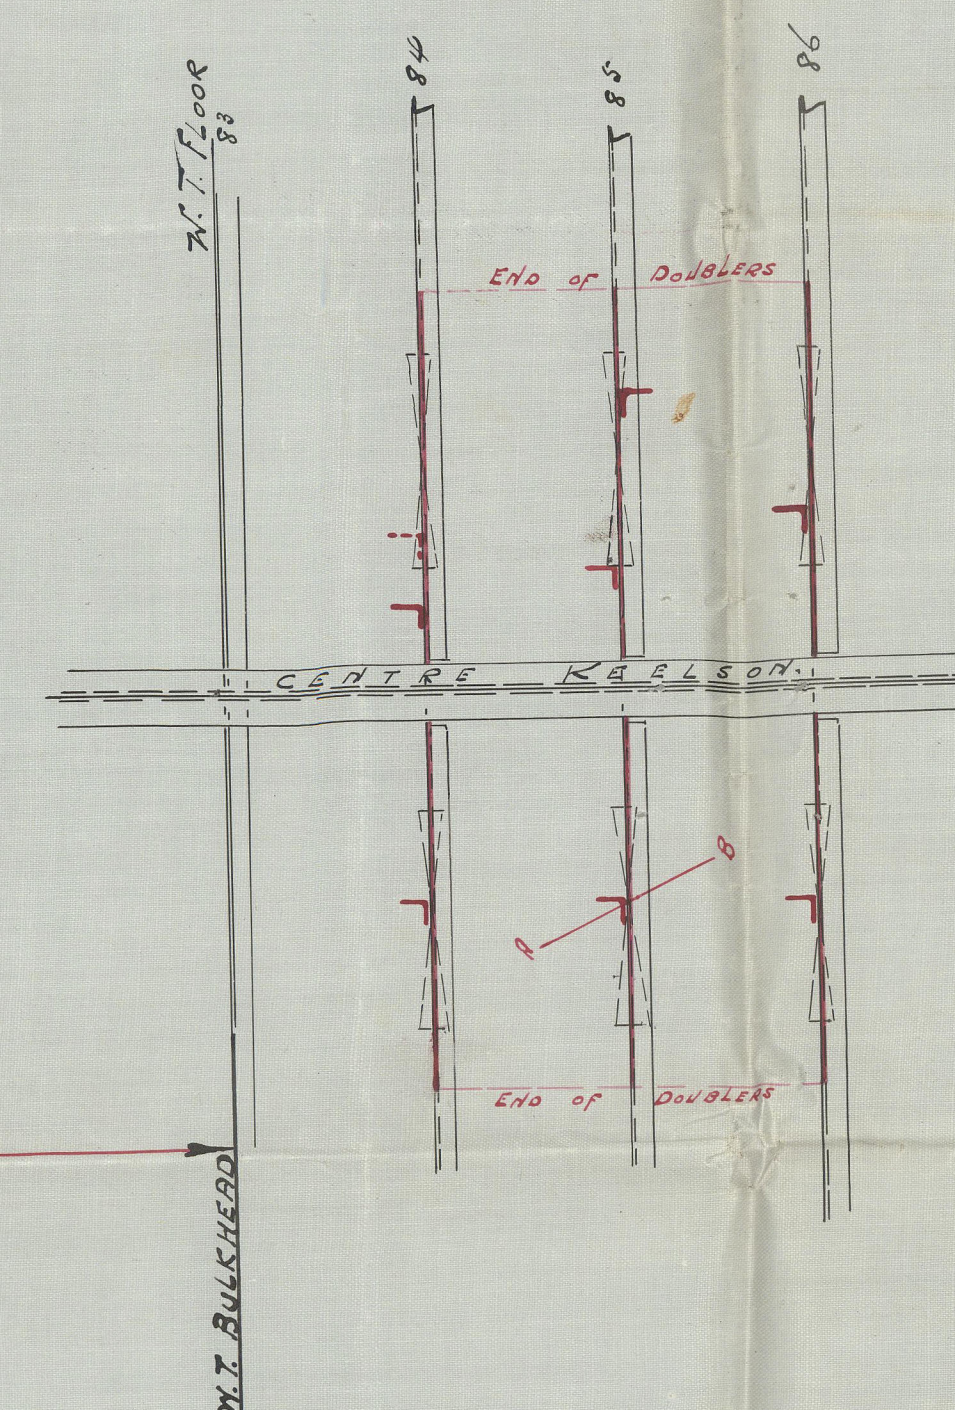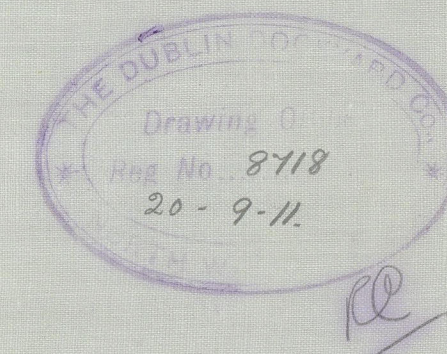


SECTION AT FRAME No 84

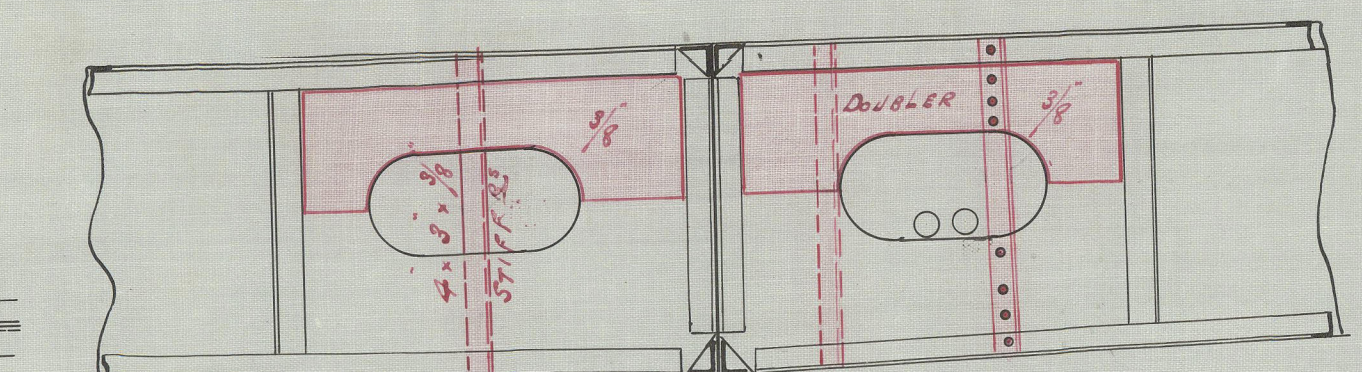

SECTION AT FRAME No 85

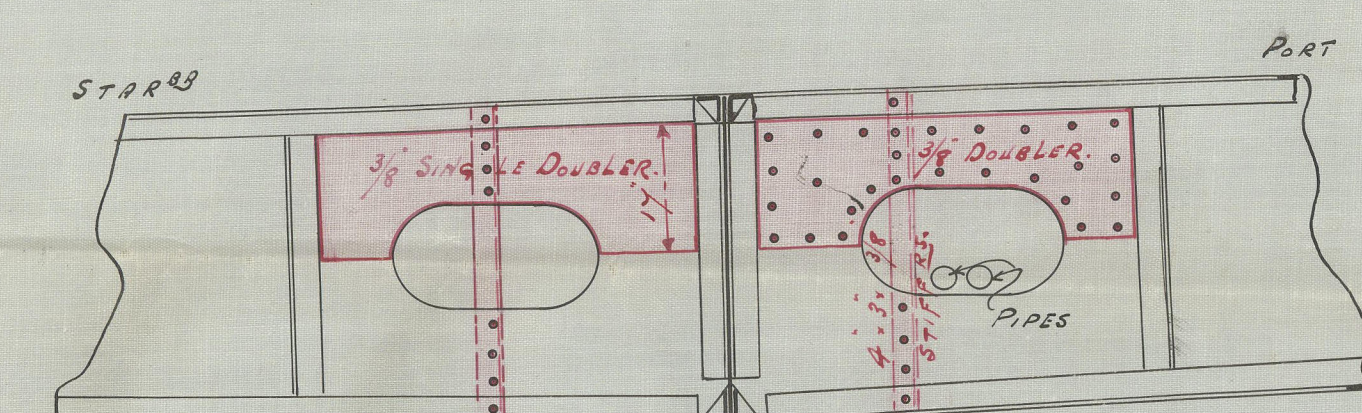


SECTION AT FRAME No 86.

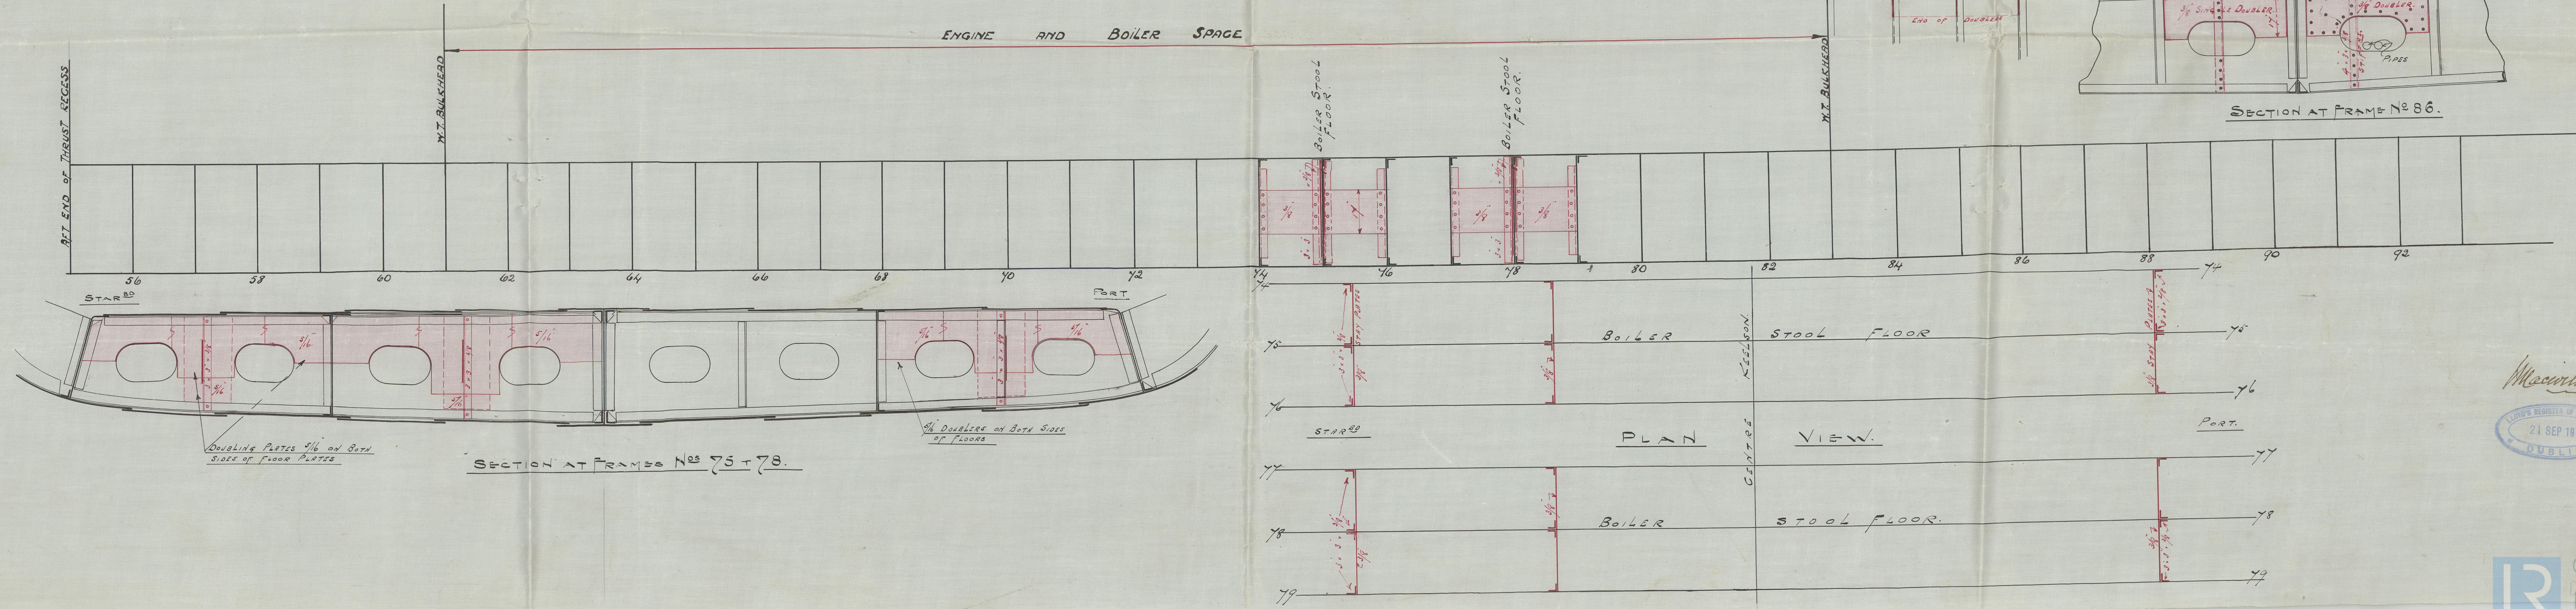


McCulliam  
LLOYD'S REGISTER OF SHIPBUILDERS  
21 SEP 1911  
DUBLIN




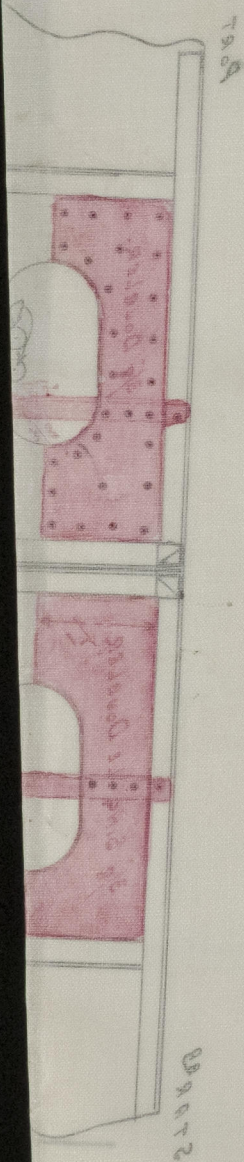


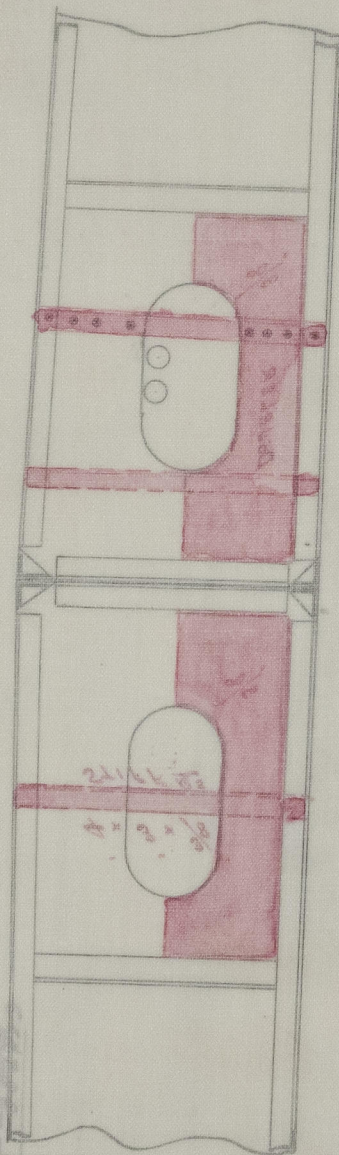


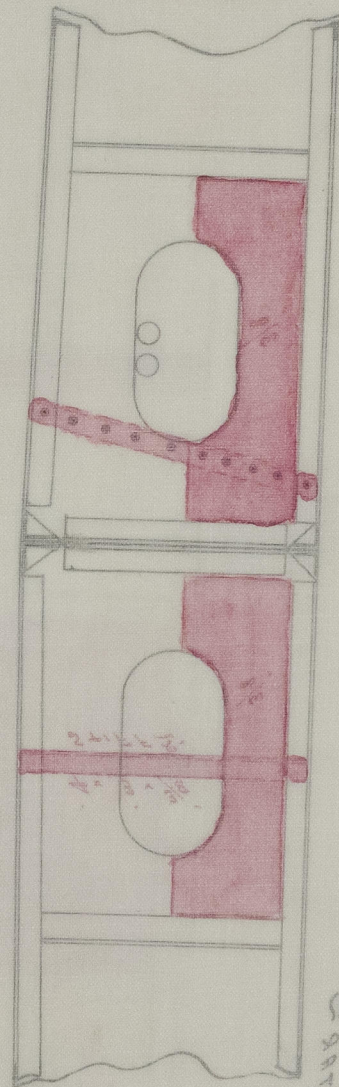

DOB 99 0134



© 2021

Lloyd's Register Foundation