


FROM
DUBLIN DOCKYARD CO.,
FOR ENCLOSURE TO
J. MacWilliam Esq.

BARGE "SLANEY"
ROUGH SHELL EXPANSION.


SCALE $\frac{1}{8}$ = 1 FT LENGTH. BREADTH $\frac{1}{4}$ = 1 FT.

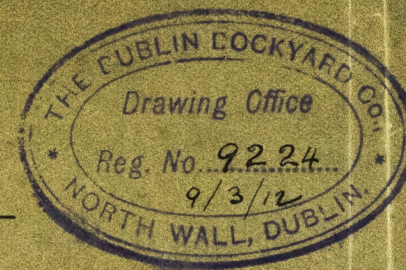

Mus

STARBOARD

PORT

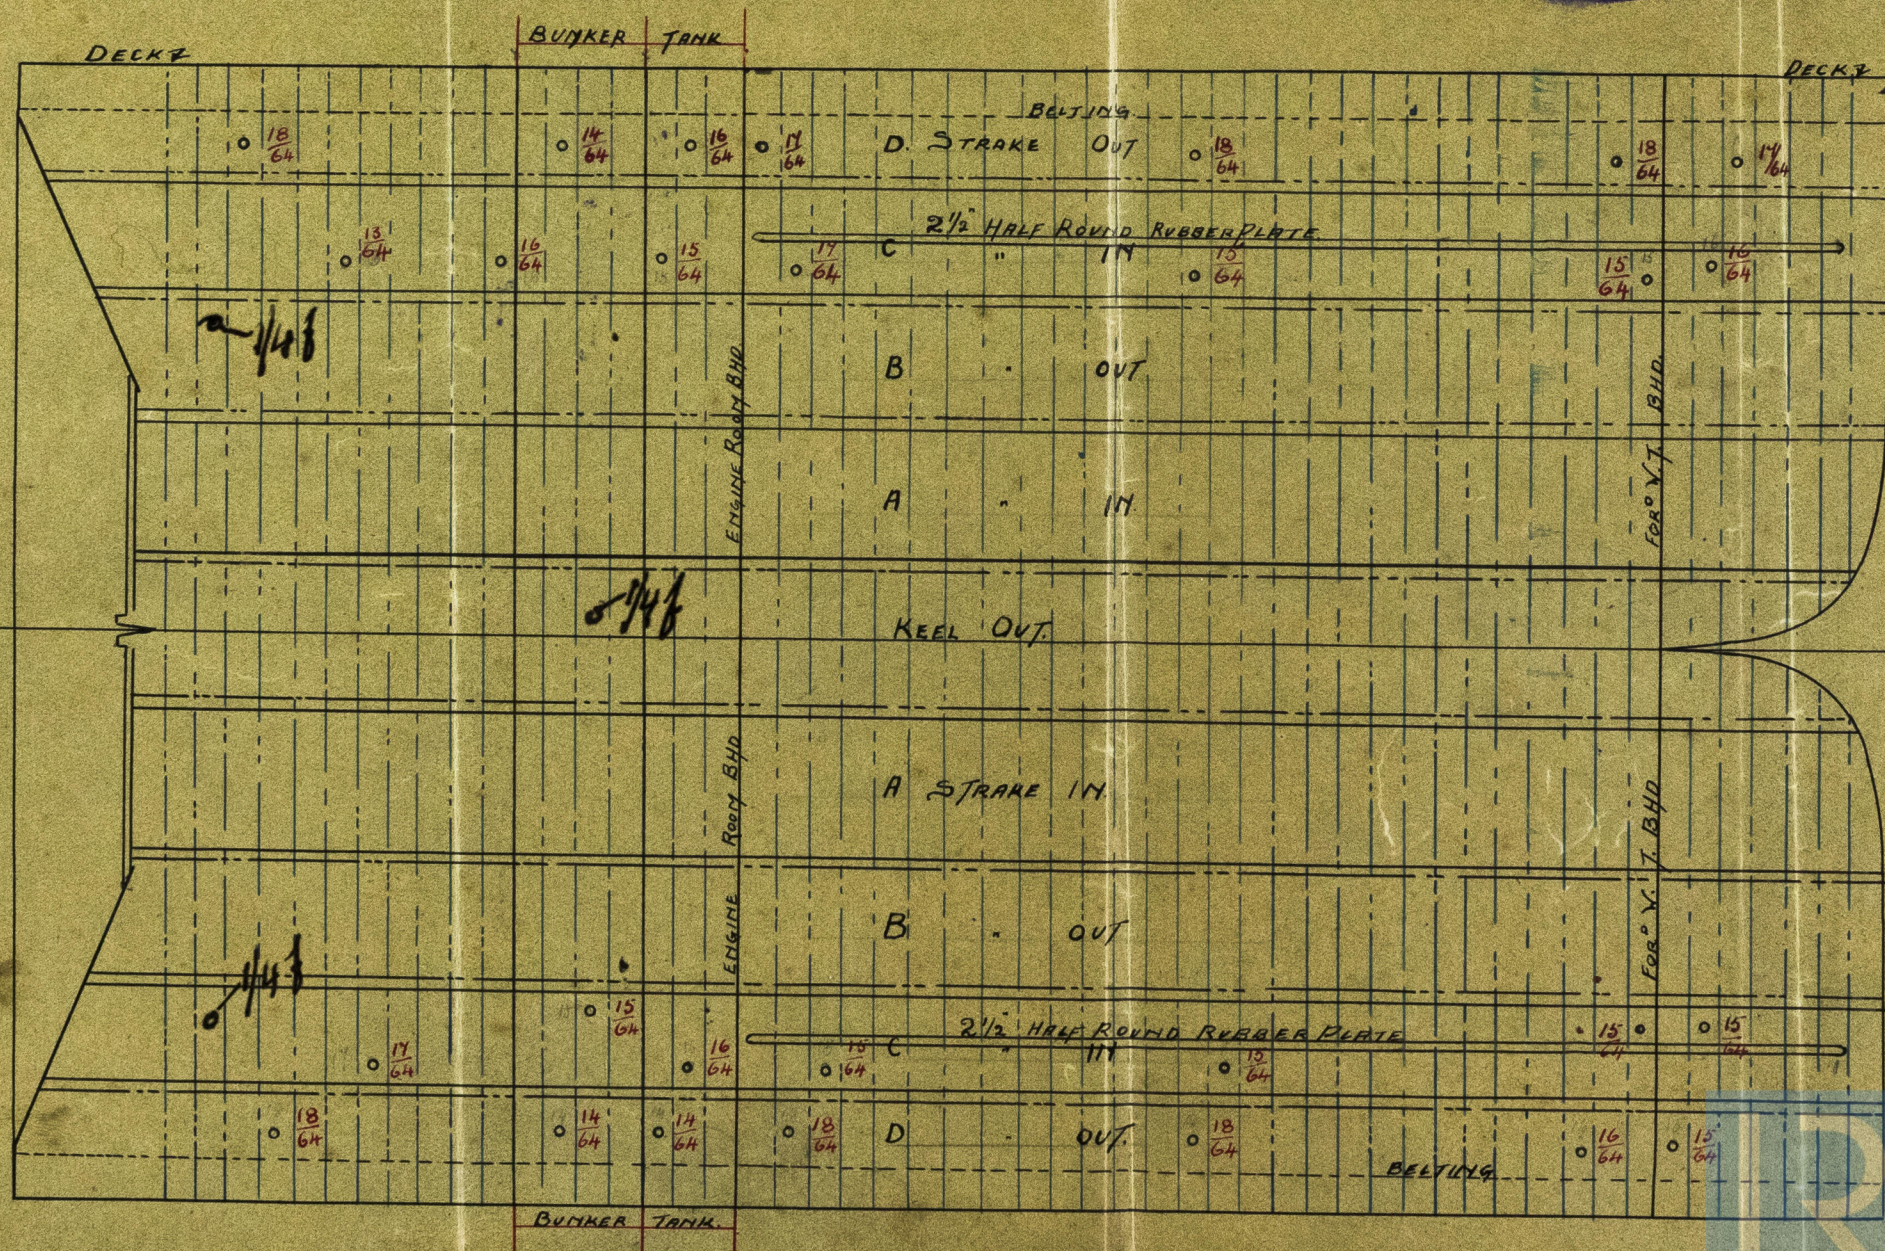

© 2019

Lloyd's Register
Foundation

DUB94-0180