
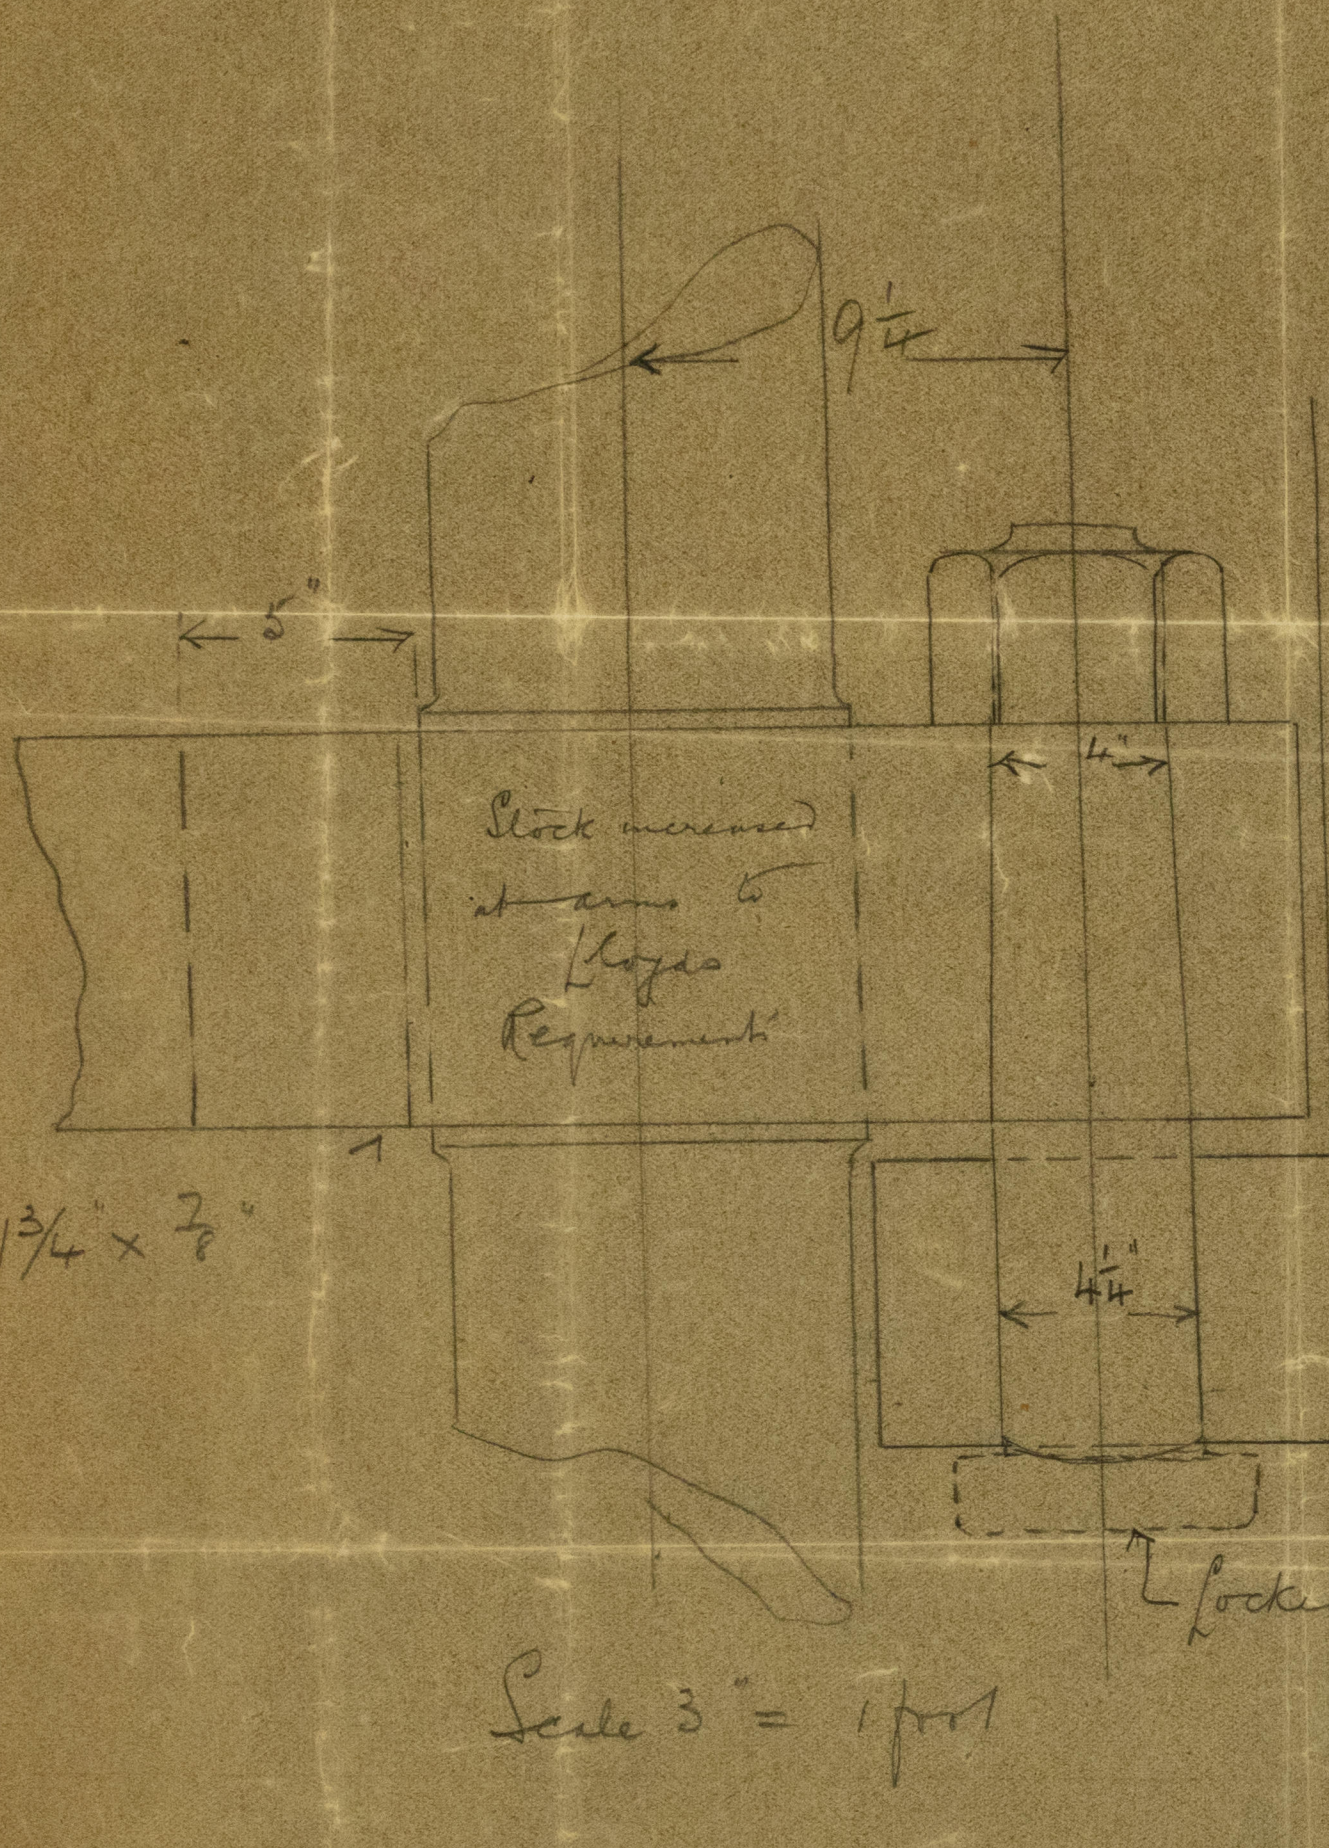


Mr J MacWilliam

24.2.14

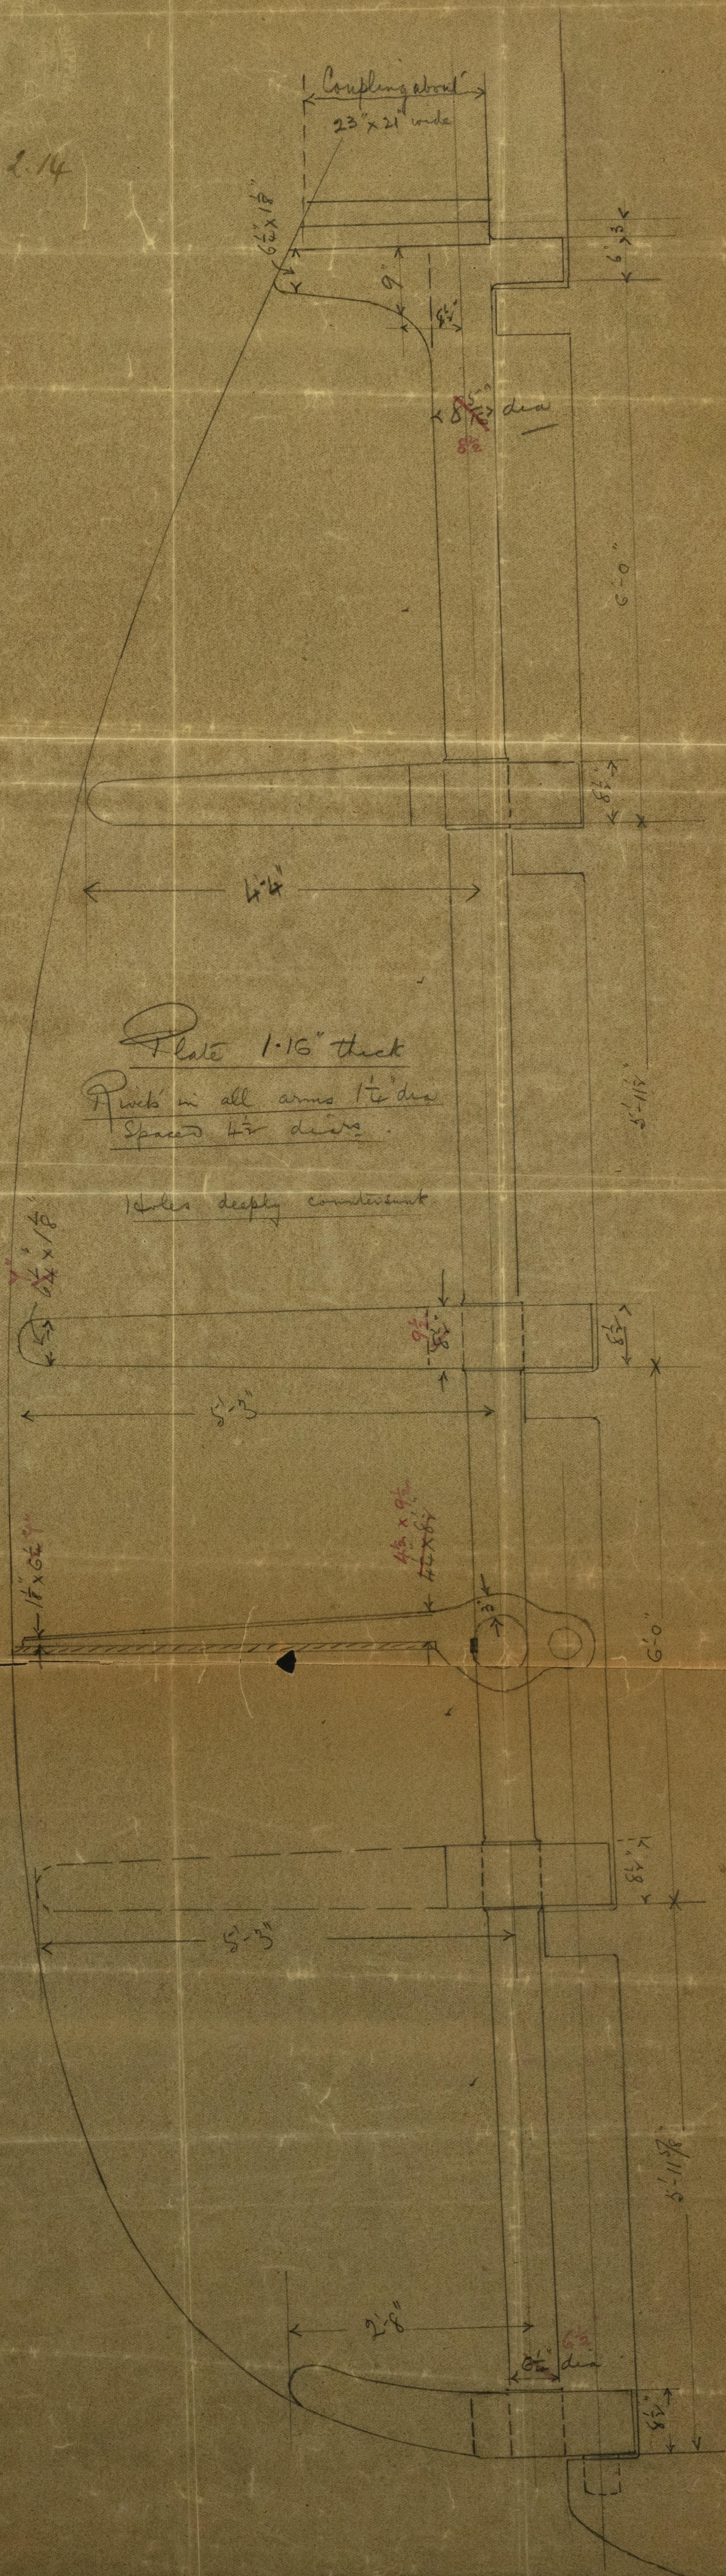

Try 1 3/4 x 7/8

S.S. Bray Head

Prop? Rudder frame to replace cast steel frame


Scale one inch = one foot

Lloyd's Requirements

Note:-

Vessel in dry dock.

Copy of this plan has been sent to forge; awaiting Lloyd's Approval

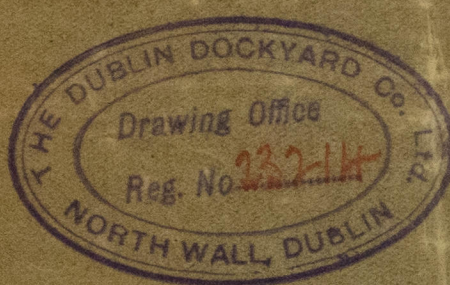

BBP

24.2.14



© 2021

Lloyd's Register Foundation

00001-0202