




SCHOONER


"OLWEN".

PROPOSED STEEL W.T. BULKHEAD.

SCALE:- $\frac{1}{2}$ INCH = ONE FOOT.

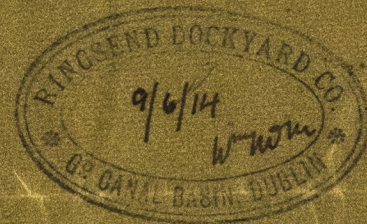


Vertical Stiffeners on Laps $3 \times 2\frac{1}{2} \times \frac{5}{16}$ spaced about 30" apart.
Beam, single angle, $3 \times 2\frac{1}{2} \times \frac{5}{16}$.

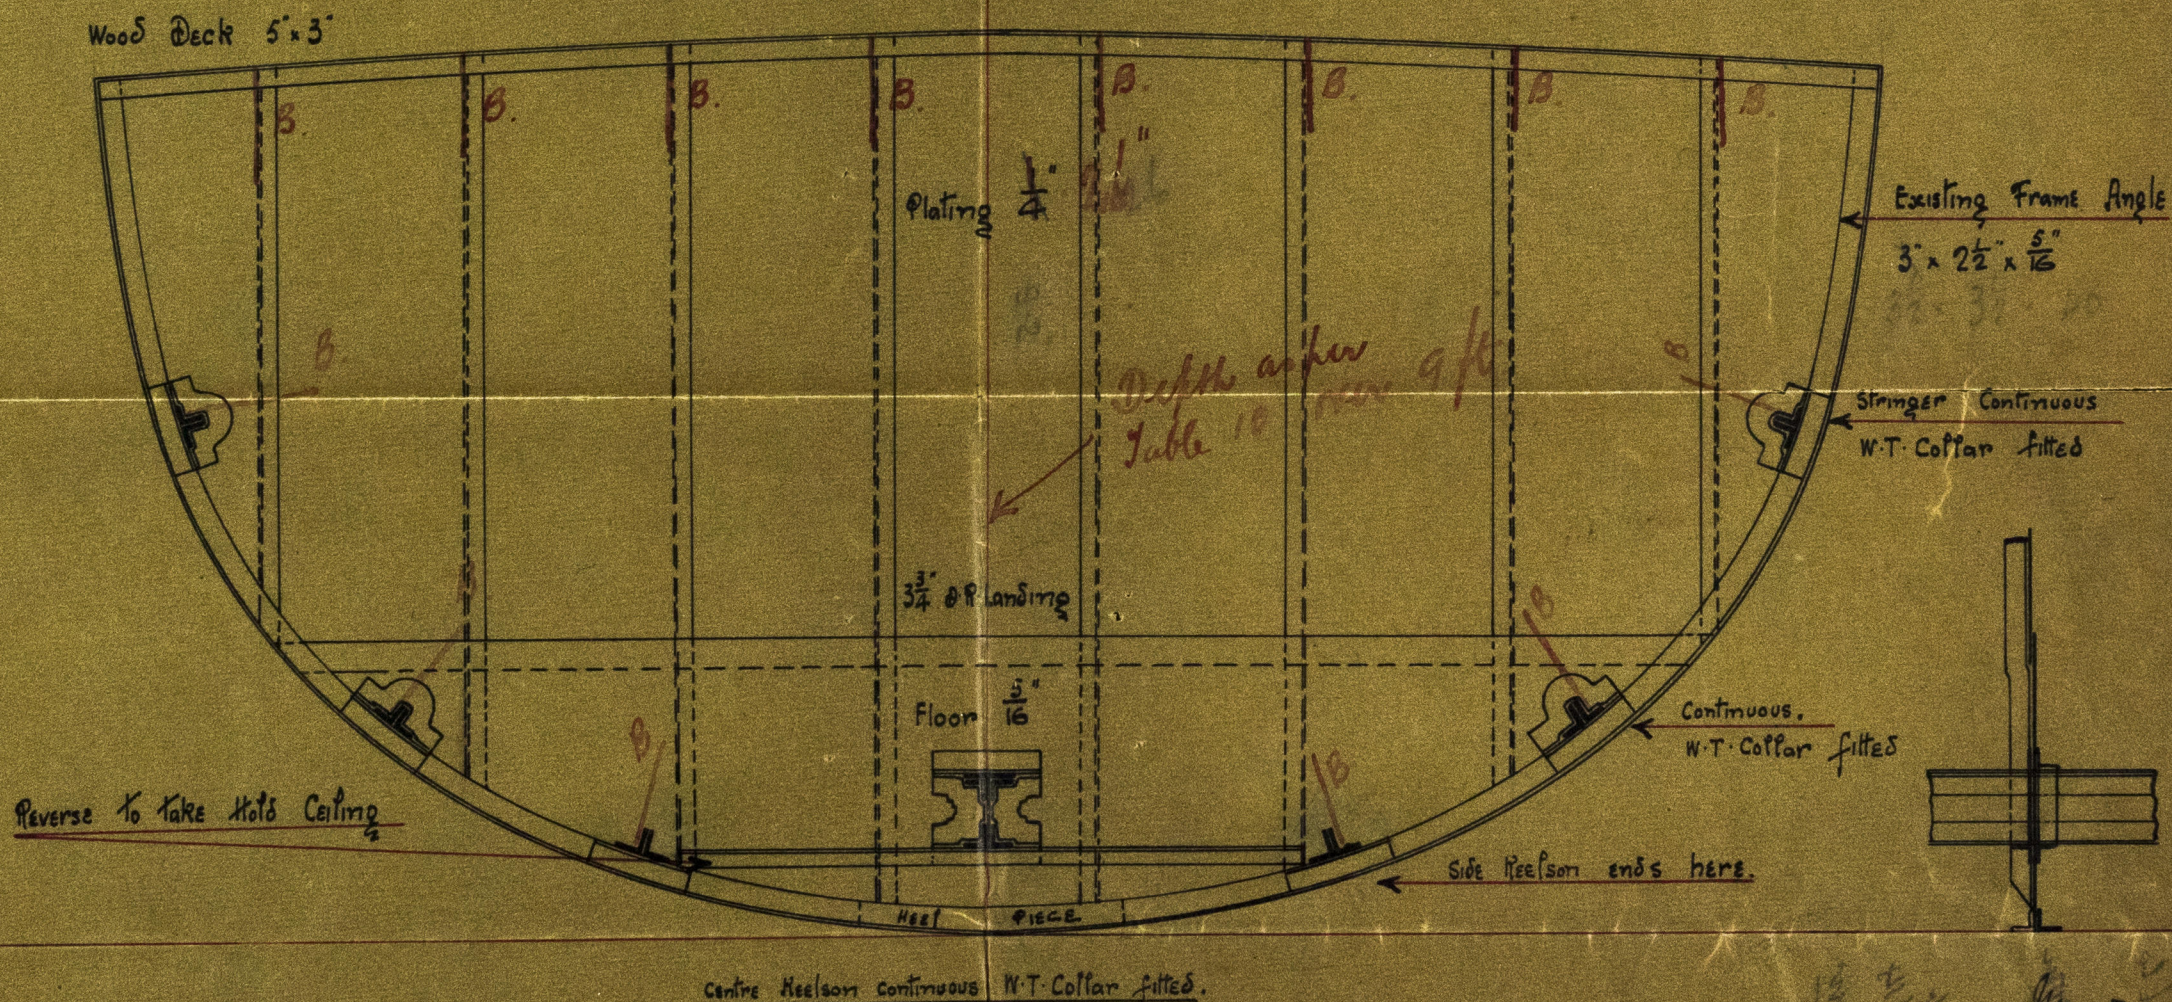

FRAME N° 11 LOOKING AFT



Vertical Stiffeners.

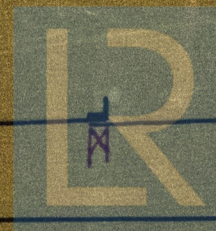

© 2021 Lloyd's Register Foundation

D11899-0202