



21.5.14
19.6.14

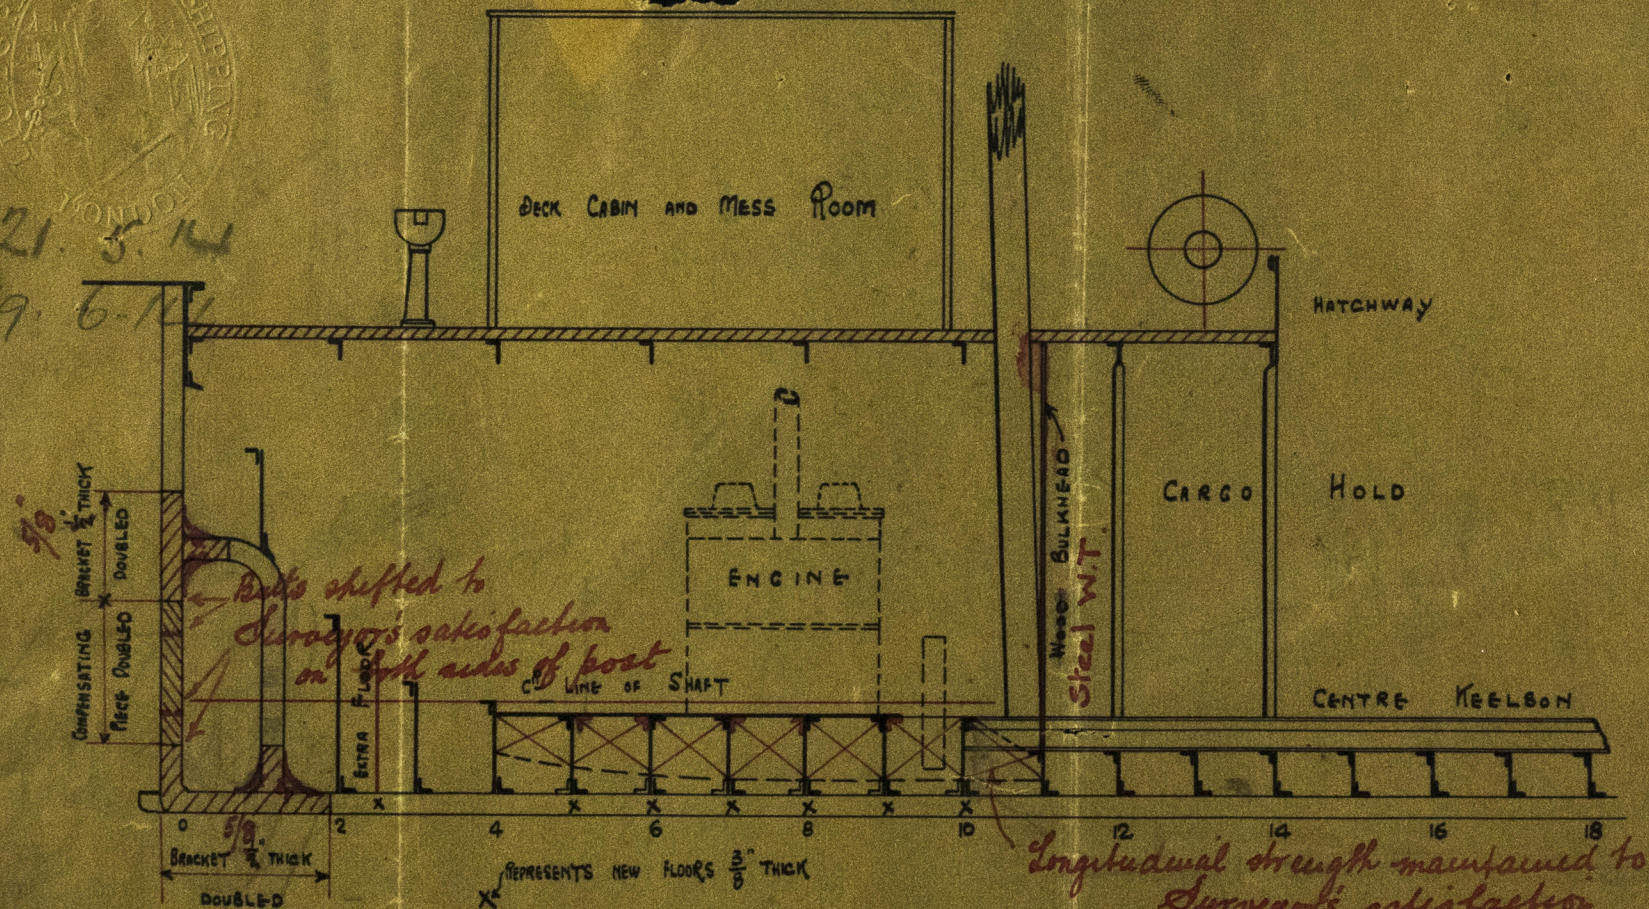

SECTIONAL ELEVATION

SCHOONER "OLWEN"


PROPOSED STRUCTURAL ALTERATIONS FOR MOTOR INSTALLATION

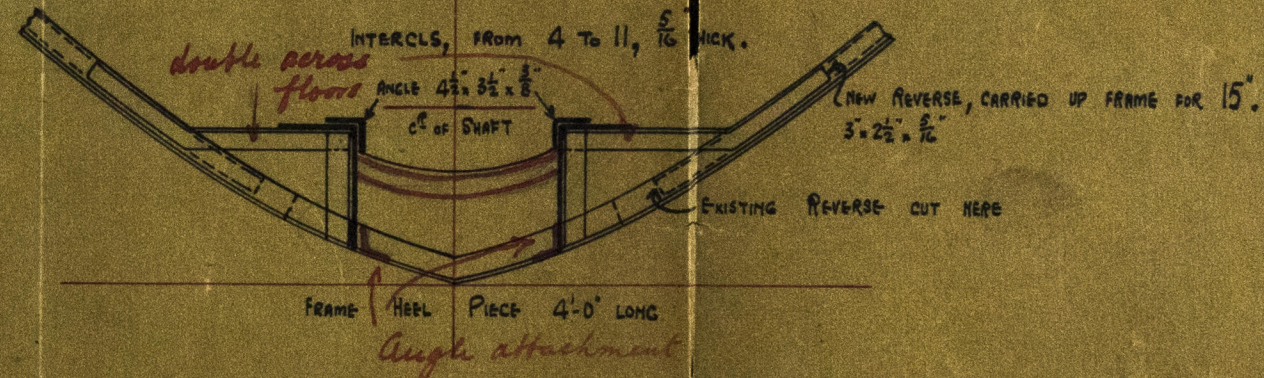

CROSS SECTION AT N°8

SCALE - 1/2 INCH = 1 FOOT.

15/5/14
22/5/14

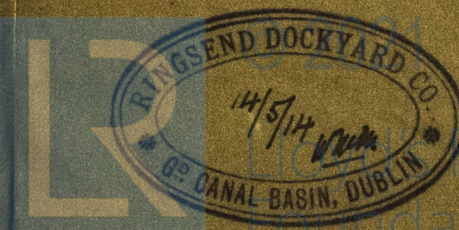

C.F.
21.5.14