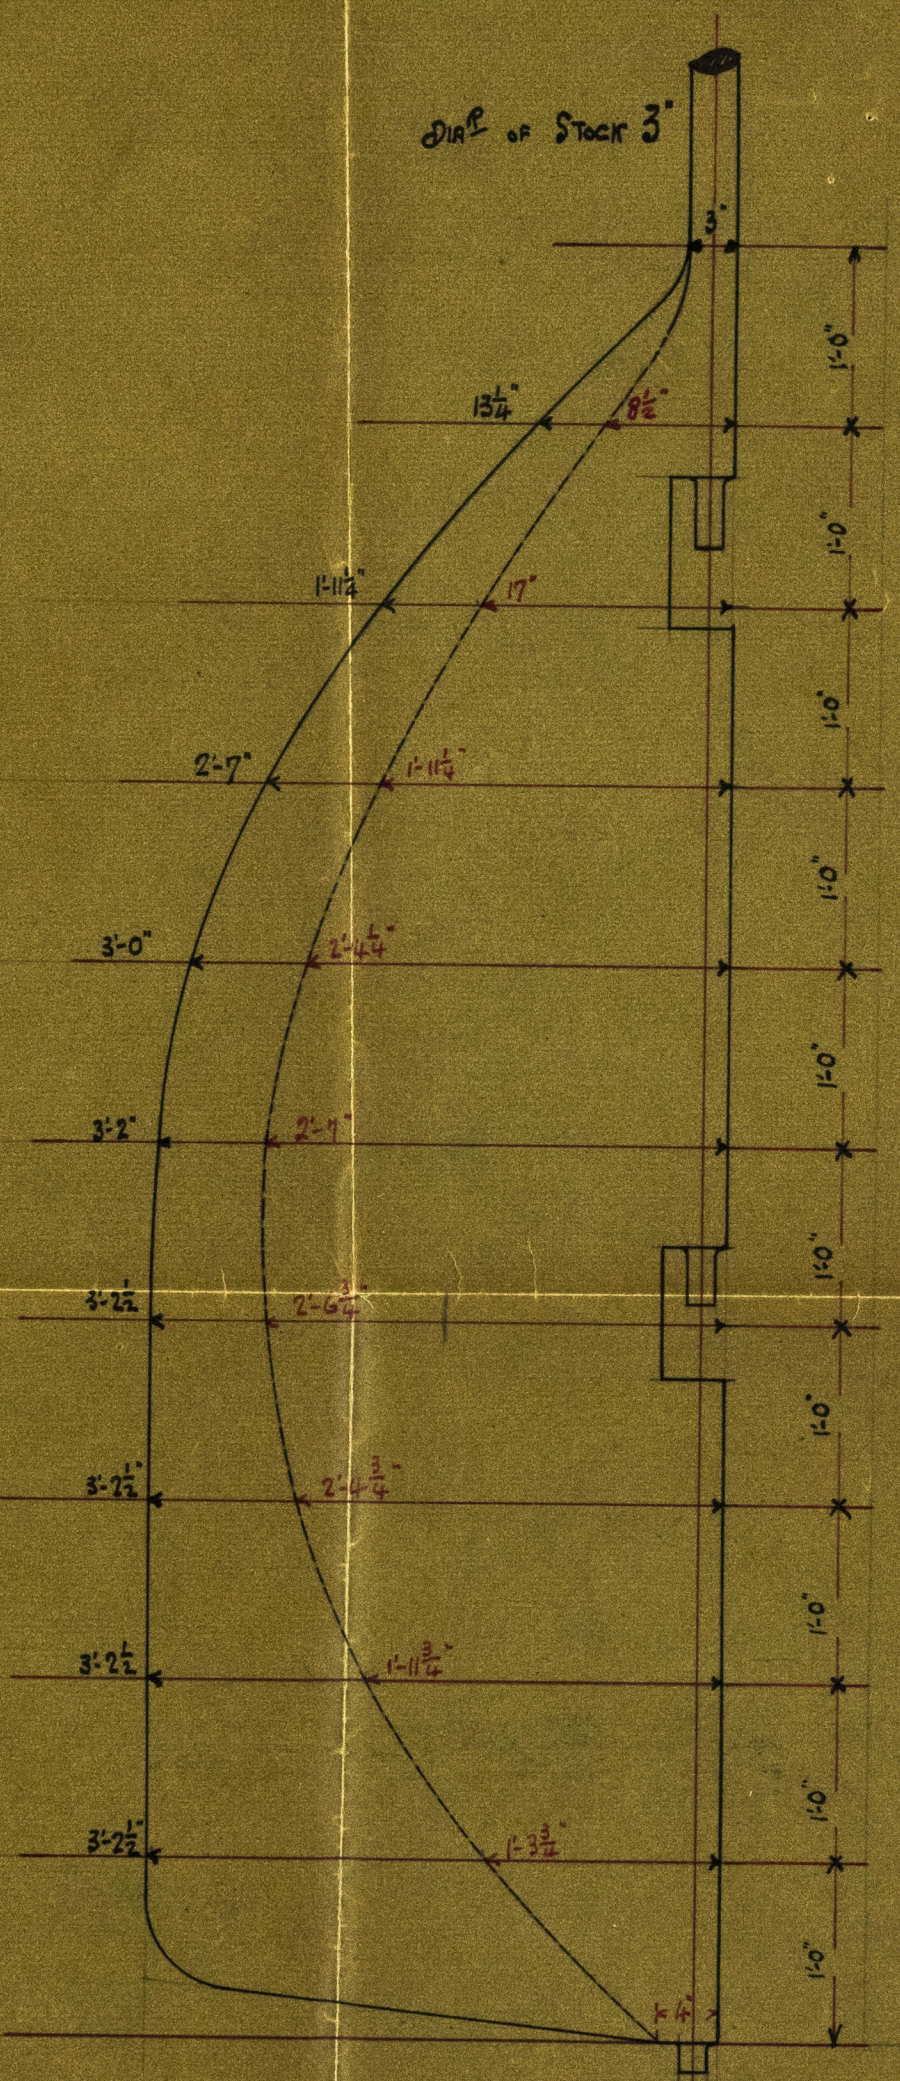

RINGSEND DOCKYARD CO.
Gd CANAL BASIN, DUBLIN

Dublin Jan 27th/14

SCHOONER "OLWEN"

SKETCH SHEWING RUDDER ORIGINAL AREA INDICATED BY DOTTED LINE.

SCALE:- ONE INCH = ONE FOOT.

© 2021 Lloyd's Register Foundation
D0844-0501