


~~this date is an error~~
~~should be 21/10/66~~
~~see page 10~~

9 x 1 1/6

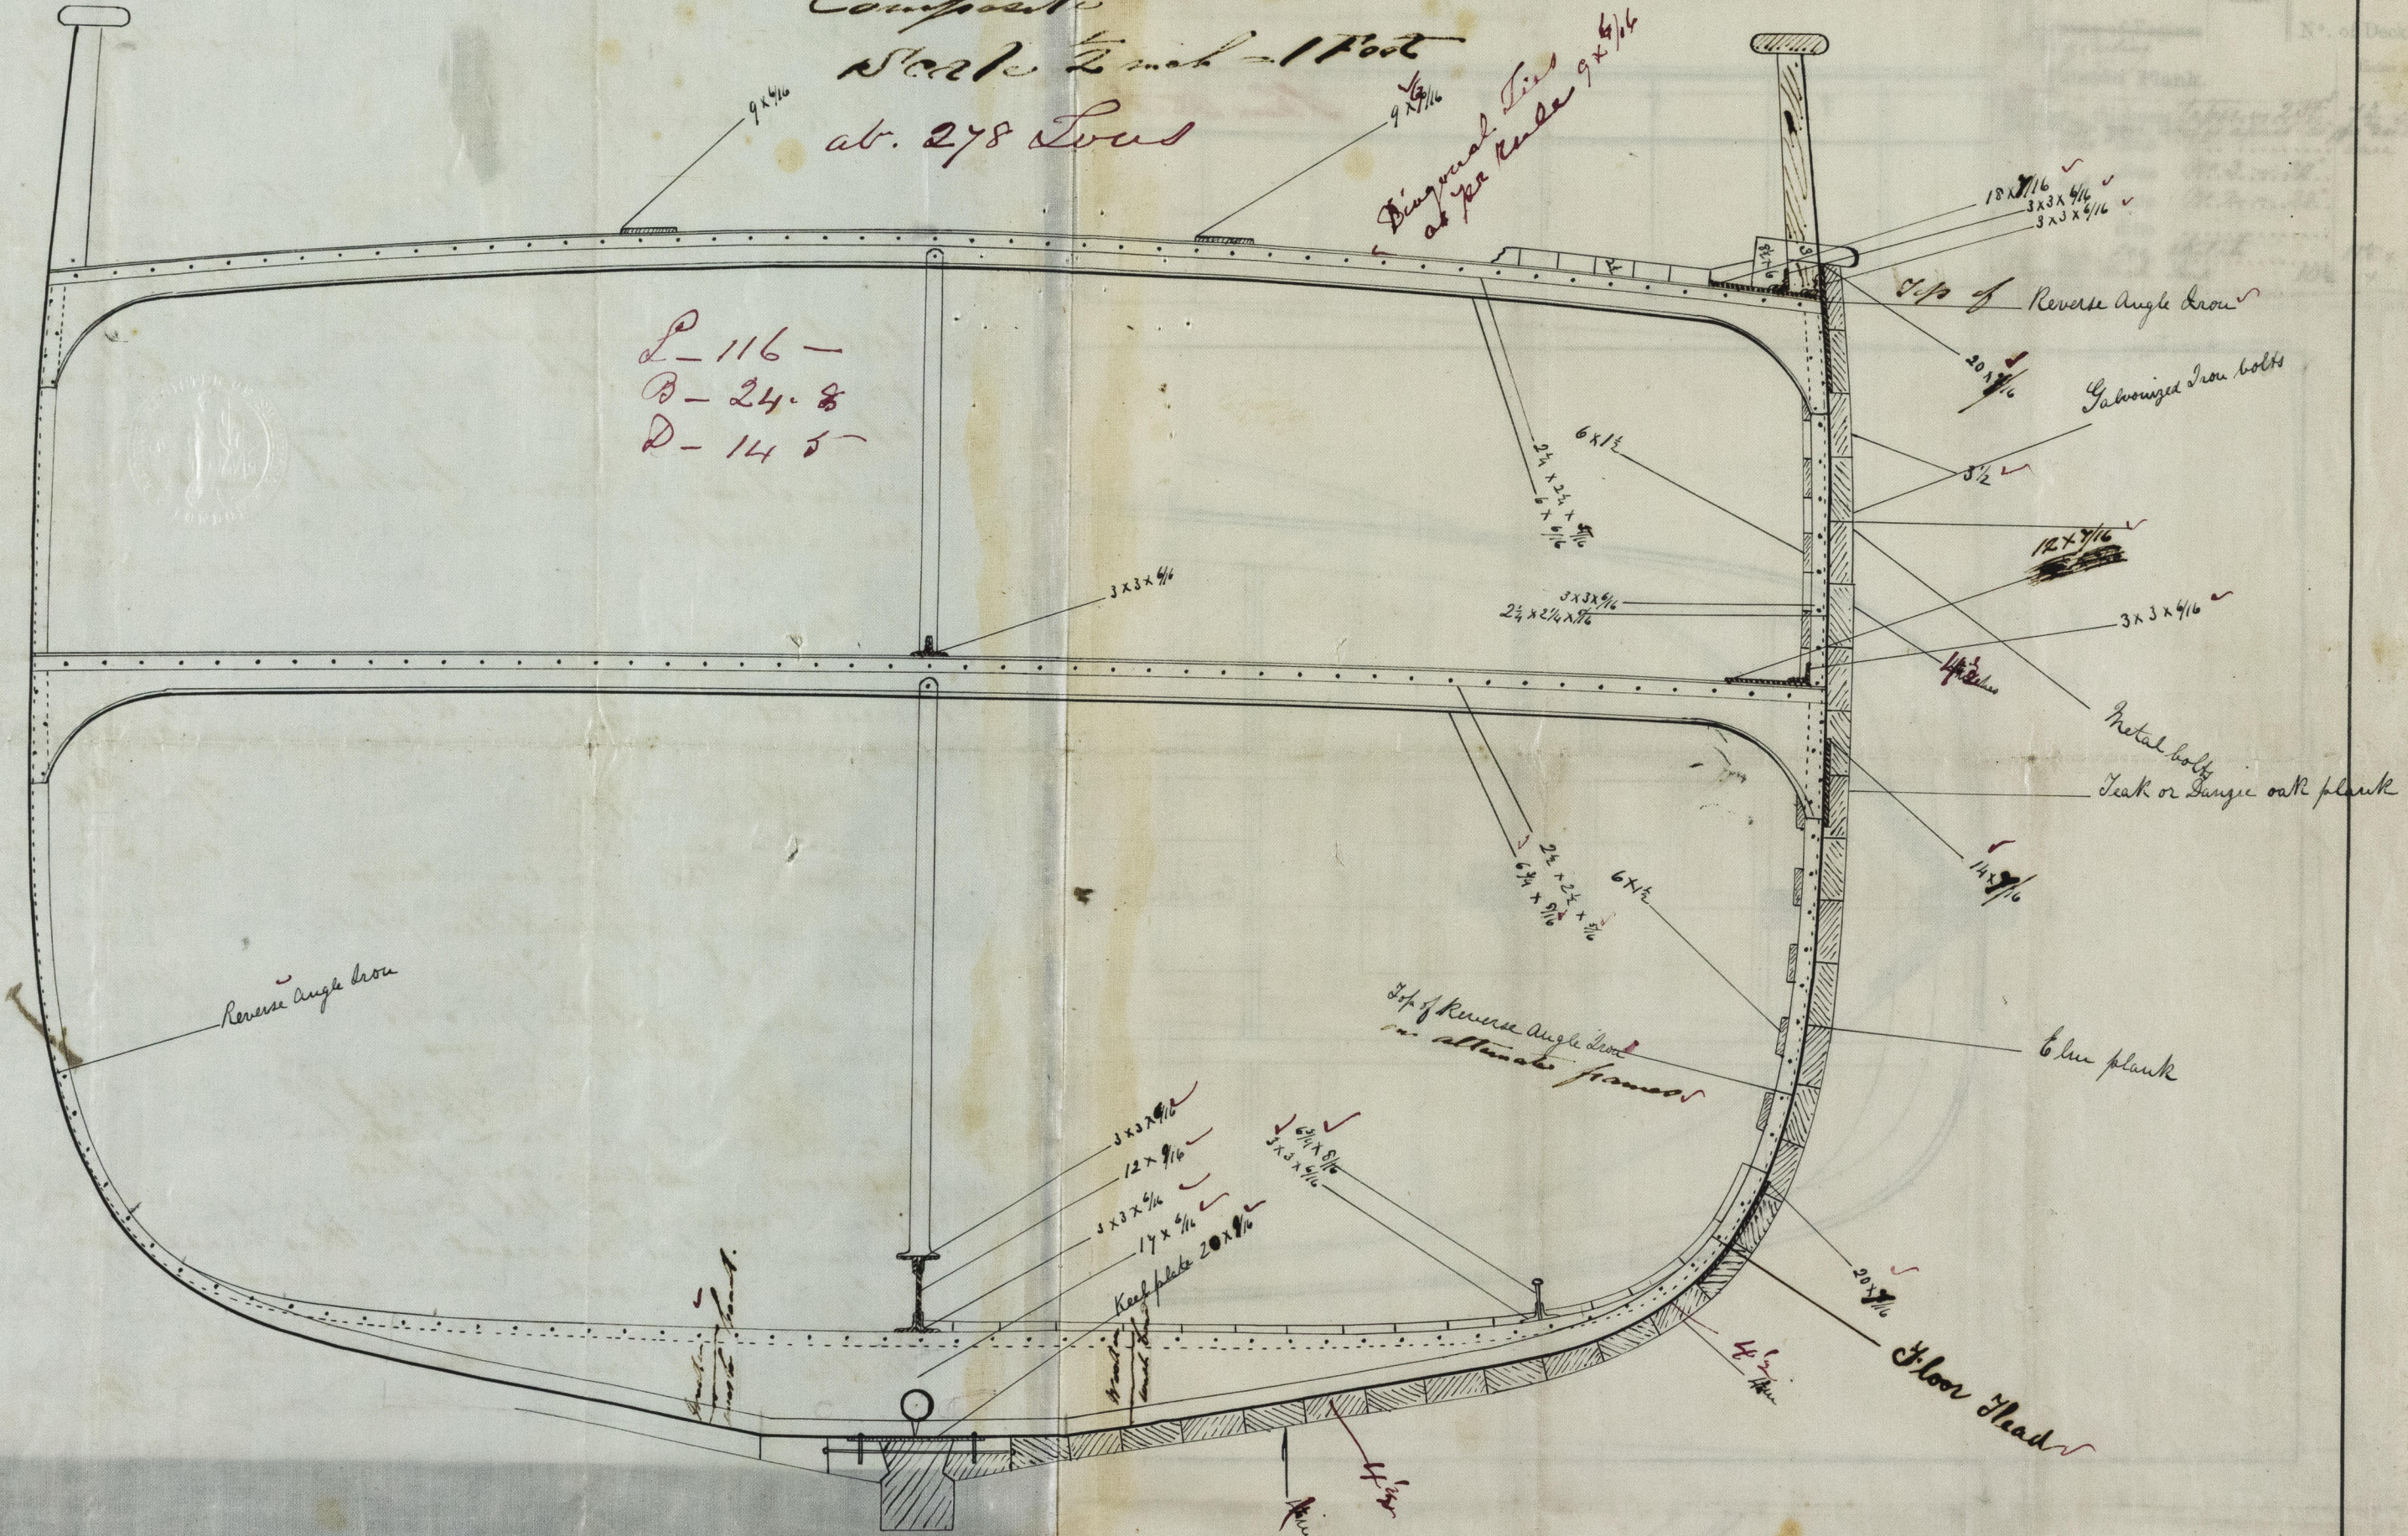

DUN106-0136