


COMPOSITE SHIP.

No. 3594 Survey held at *Dundee* Date *21st August*
Midship Section of *Ship "Montrose"* Master *J. J. ...*
 Tonnage under tonnage deck *783 86* Built at *Dundee* When built *1867*
 Ship No. *13* Ditta of poop *251* Deck *13-25*
 Scale $\frac{3}{8}$ in = 1 Foot Length of engine room *79 3/4* 23 28
 Gross tonnage *902.0* Port belonging to *London* Destined Voyage
Montrose
25/8/67

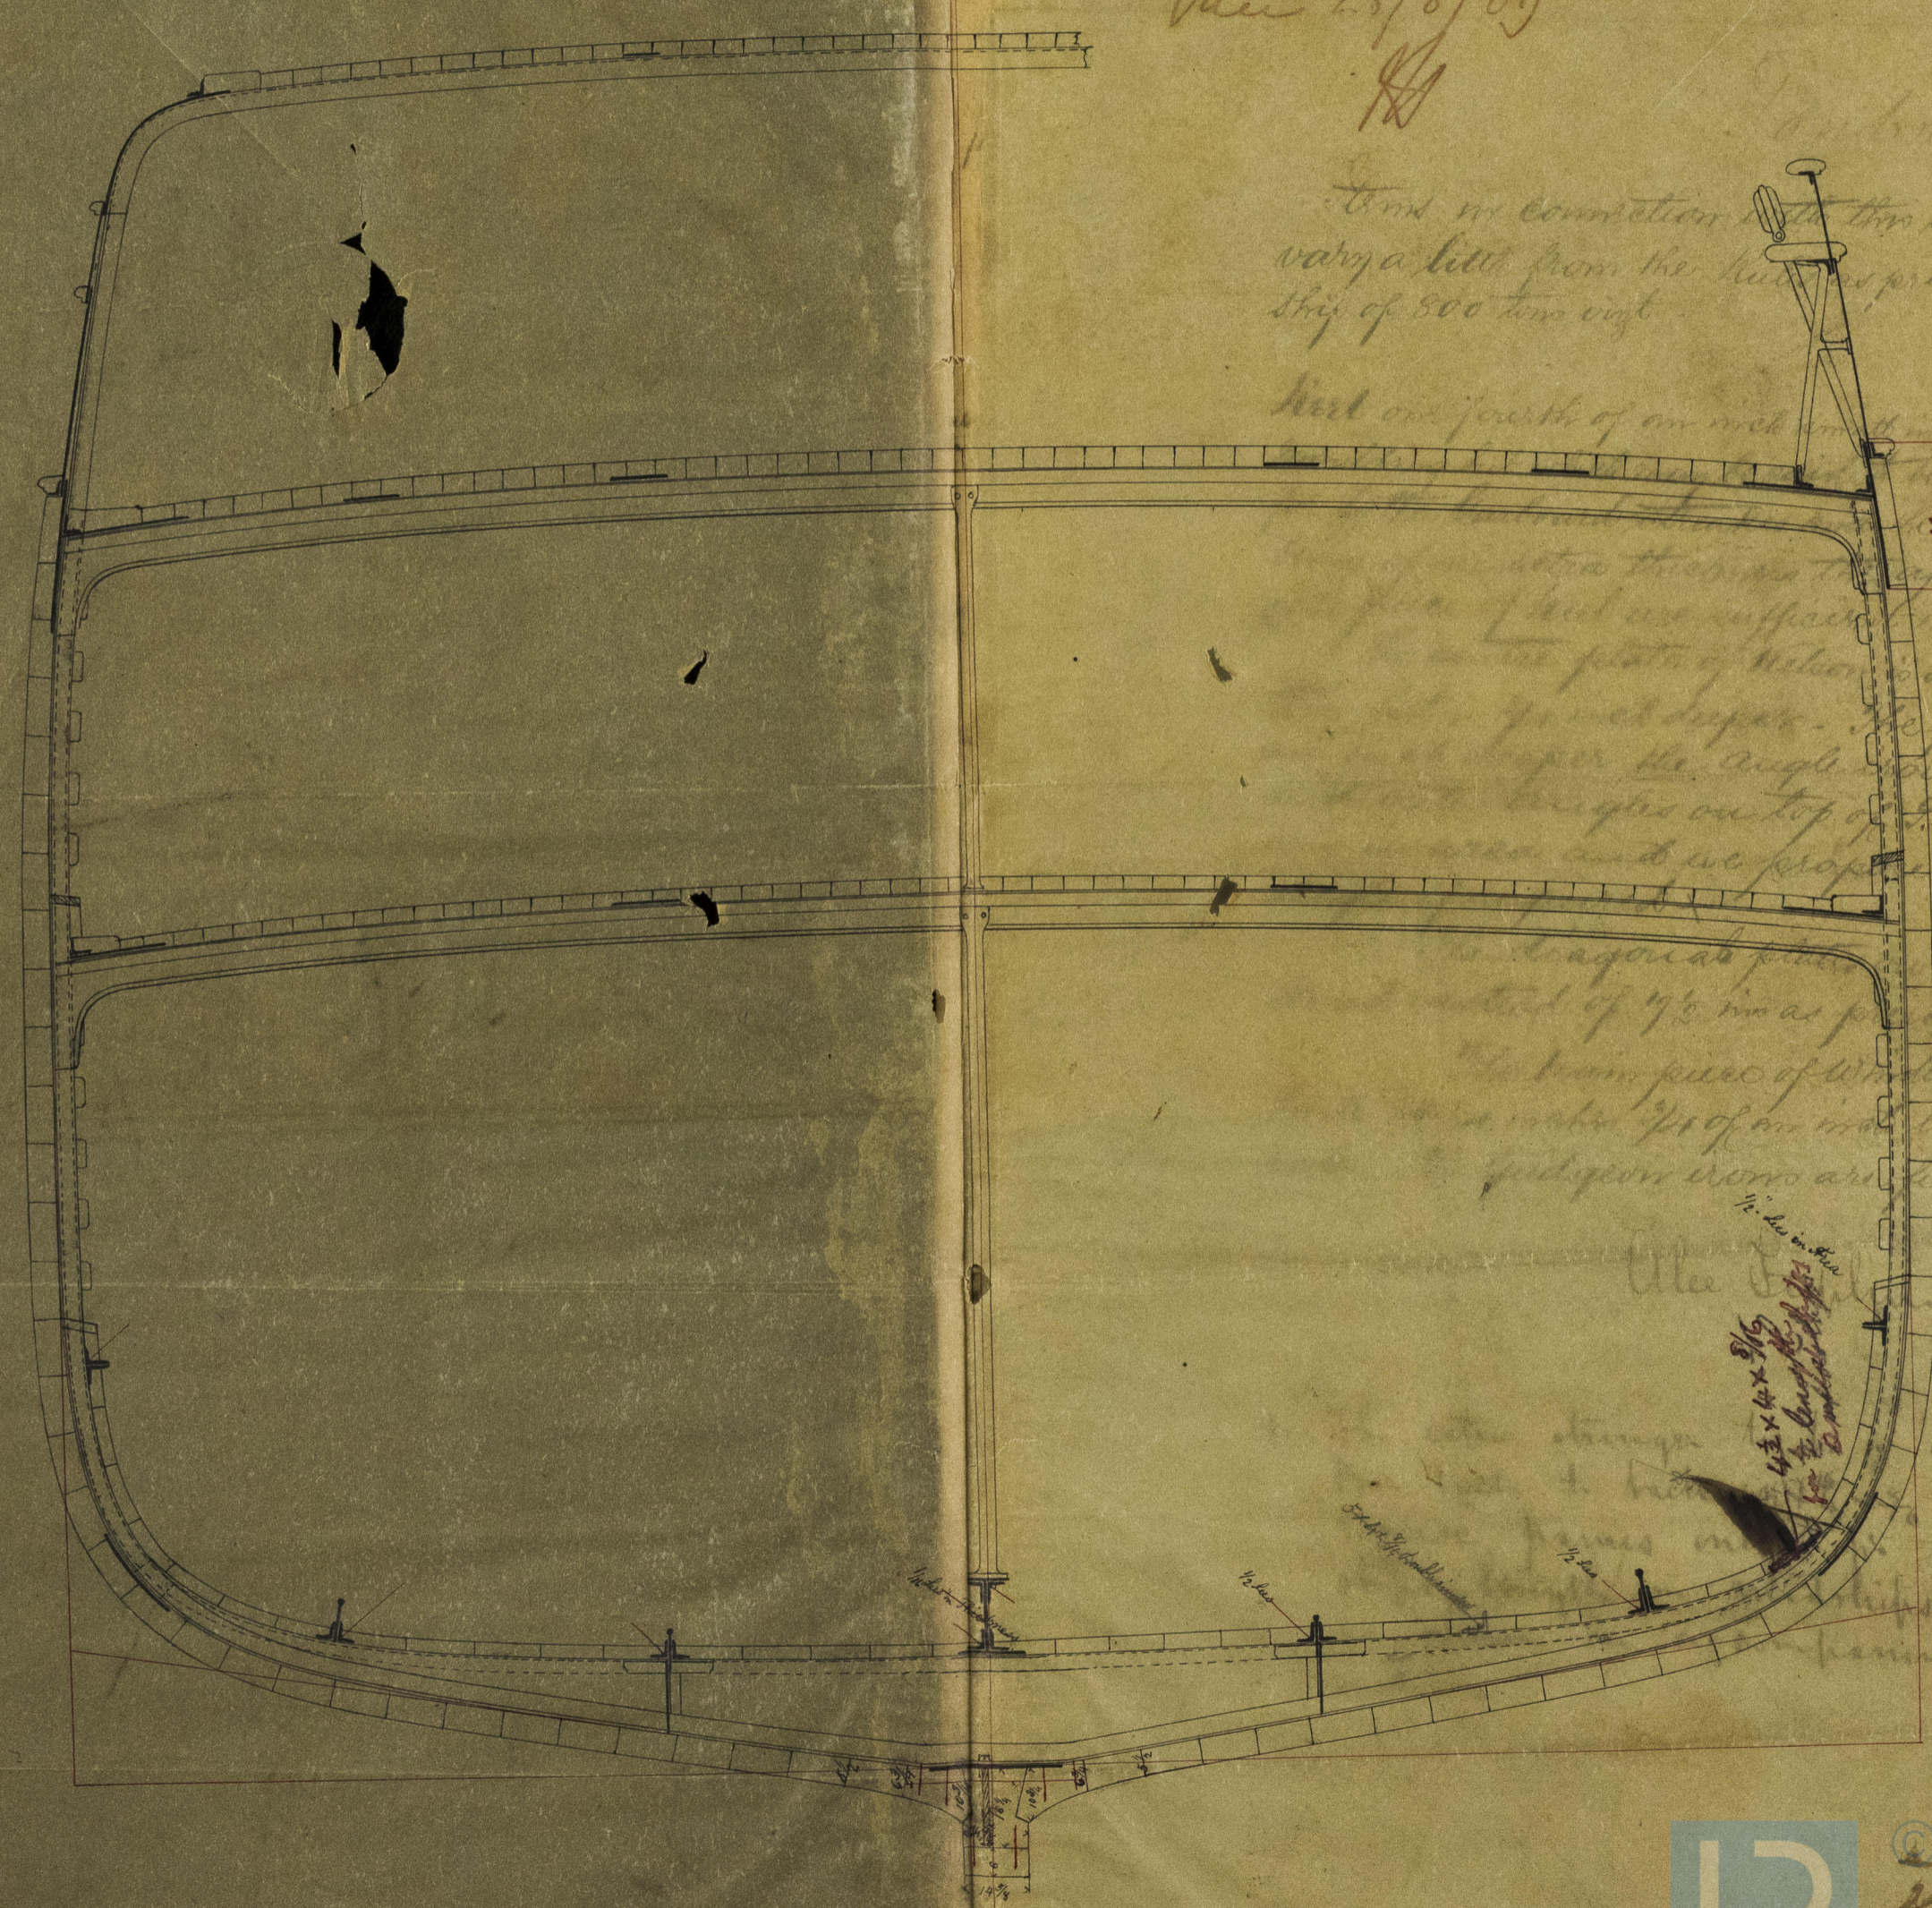




W. J. ...
14 1/2 x 14 1/2
for the keel
for the bottom

double angle riveted to half the thickness of the plates & placed transverse midship